

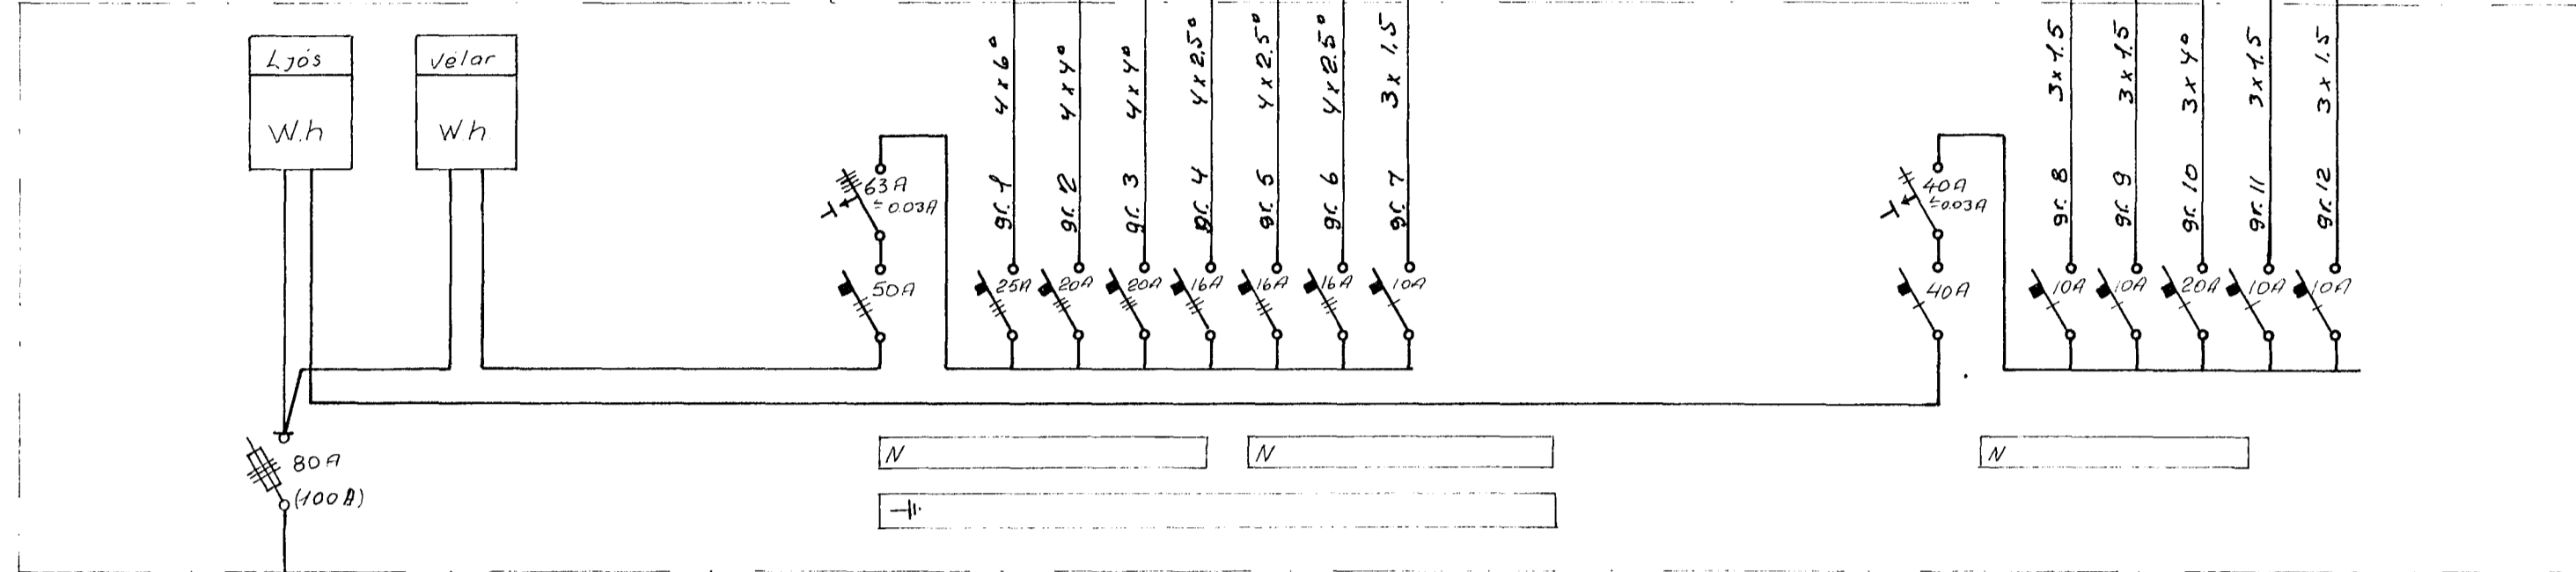


JBP 117 T.2

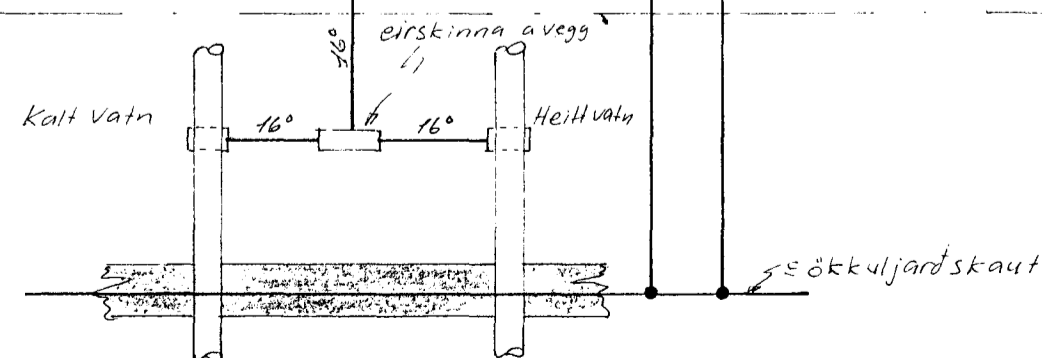

JBP 117 T.1

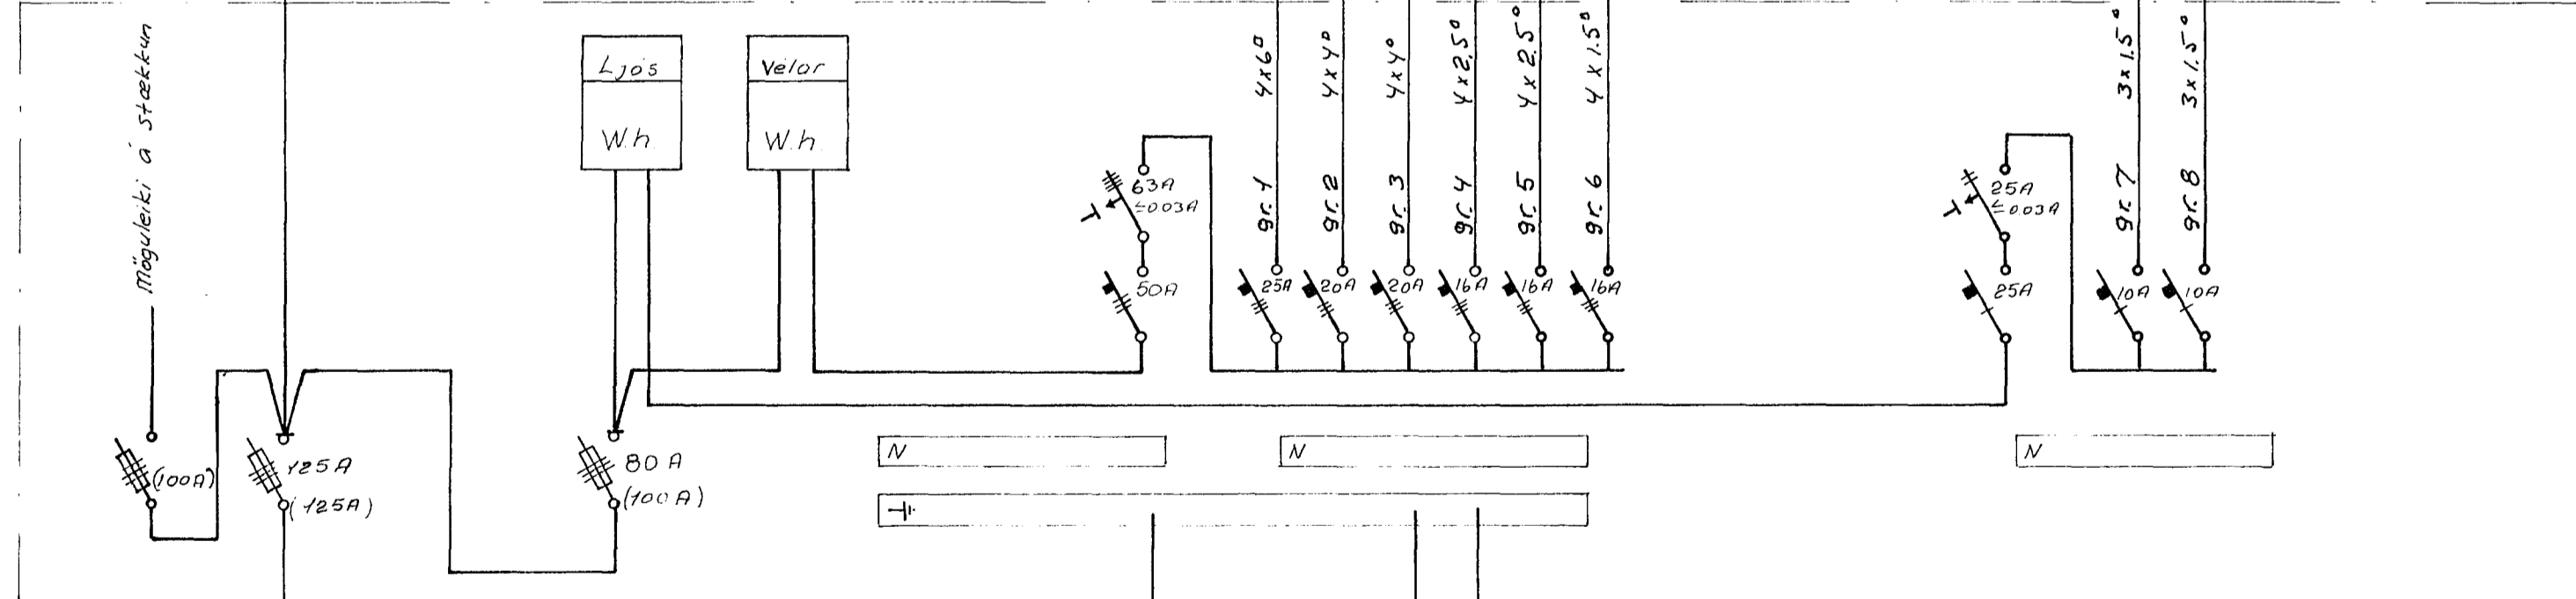

Breytt í okt 1976 T.S.

HELLUHRAUN 6. HAFNARF.	mælikv. %
	dags. SEPT. 1976
Einlínuyndir af töflum T.1ogT.2	teikn. T.S.   bl. 3 af 3
	samp. V. Sveinbjörnsson
	teikn. nr. 16-A41