
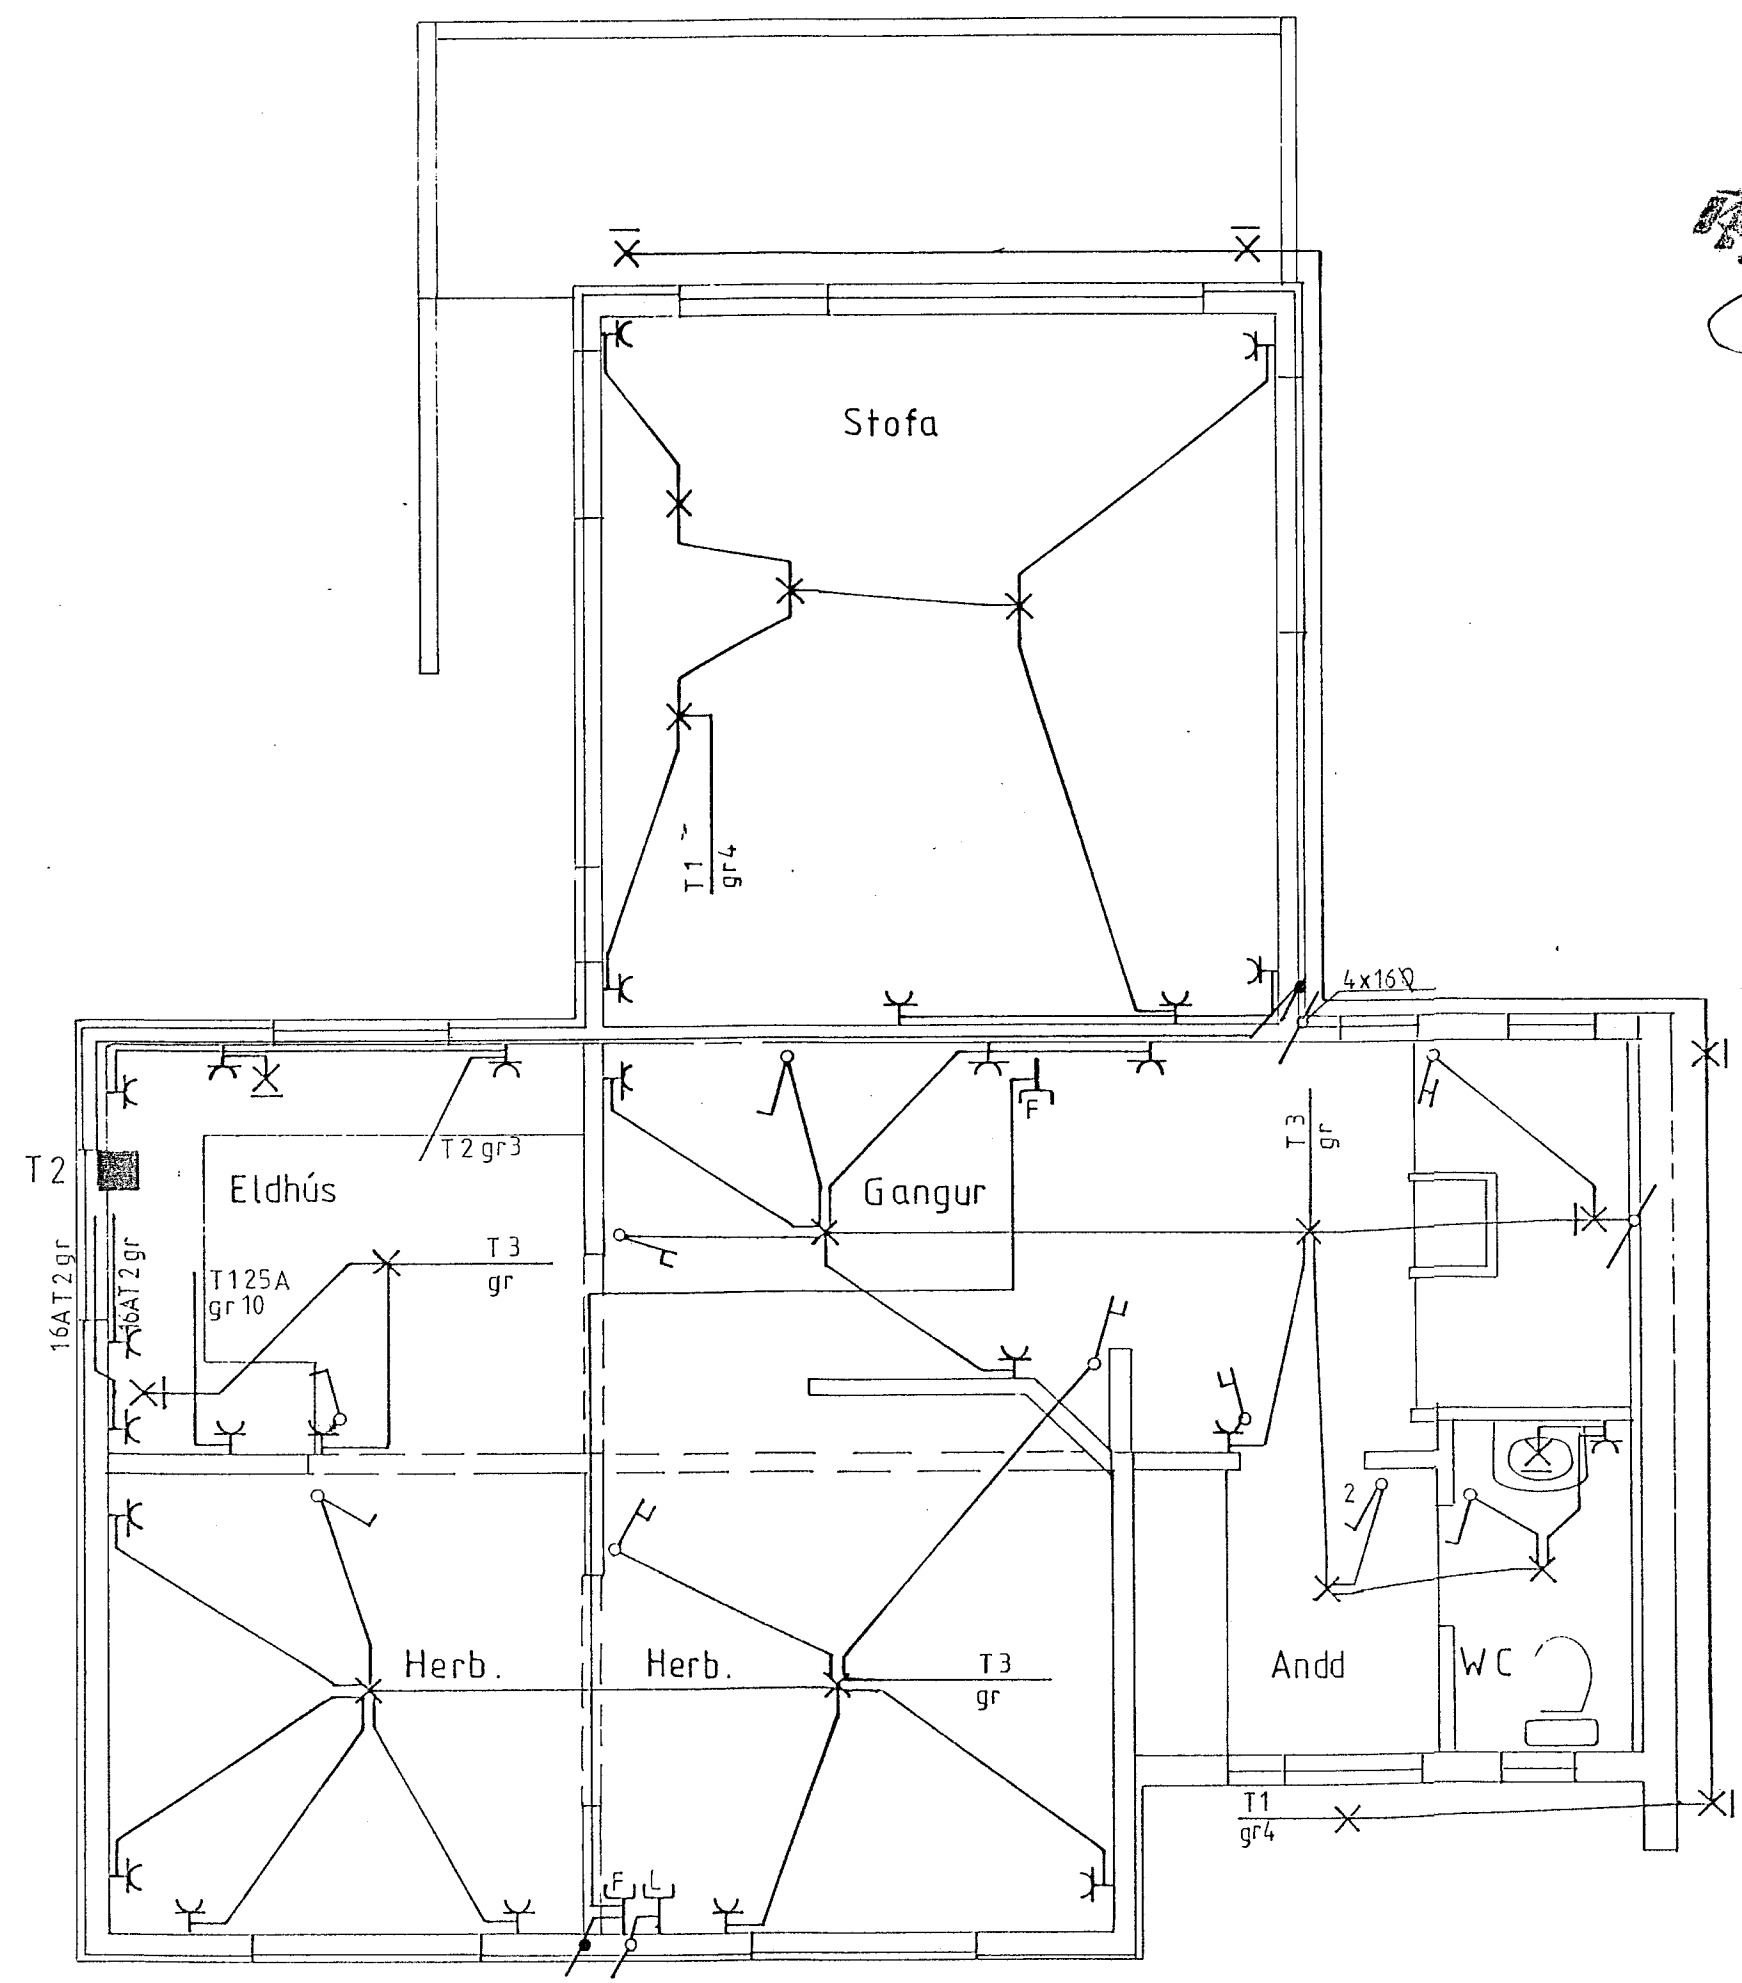


Sambýkt 2-1 18 92
 VEONA FULLNADARFRÁGANGS
 Rafnateikning
 Lth. Rafnateikning

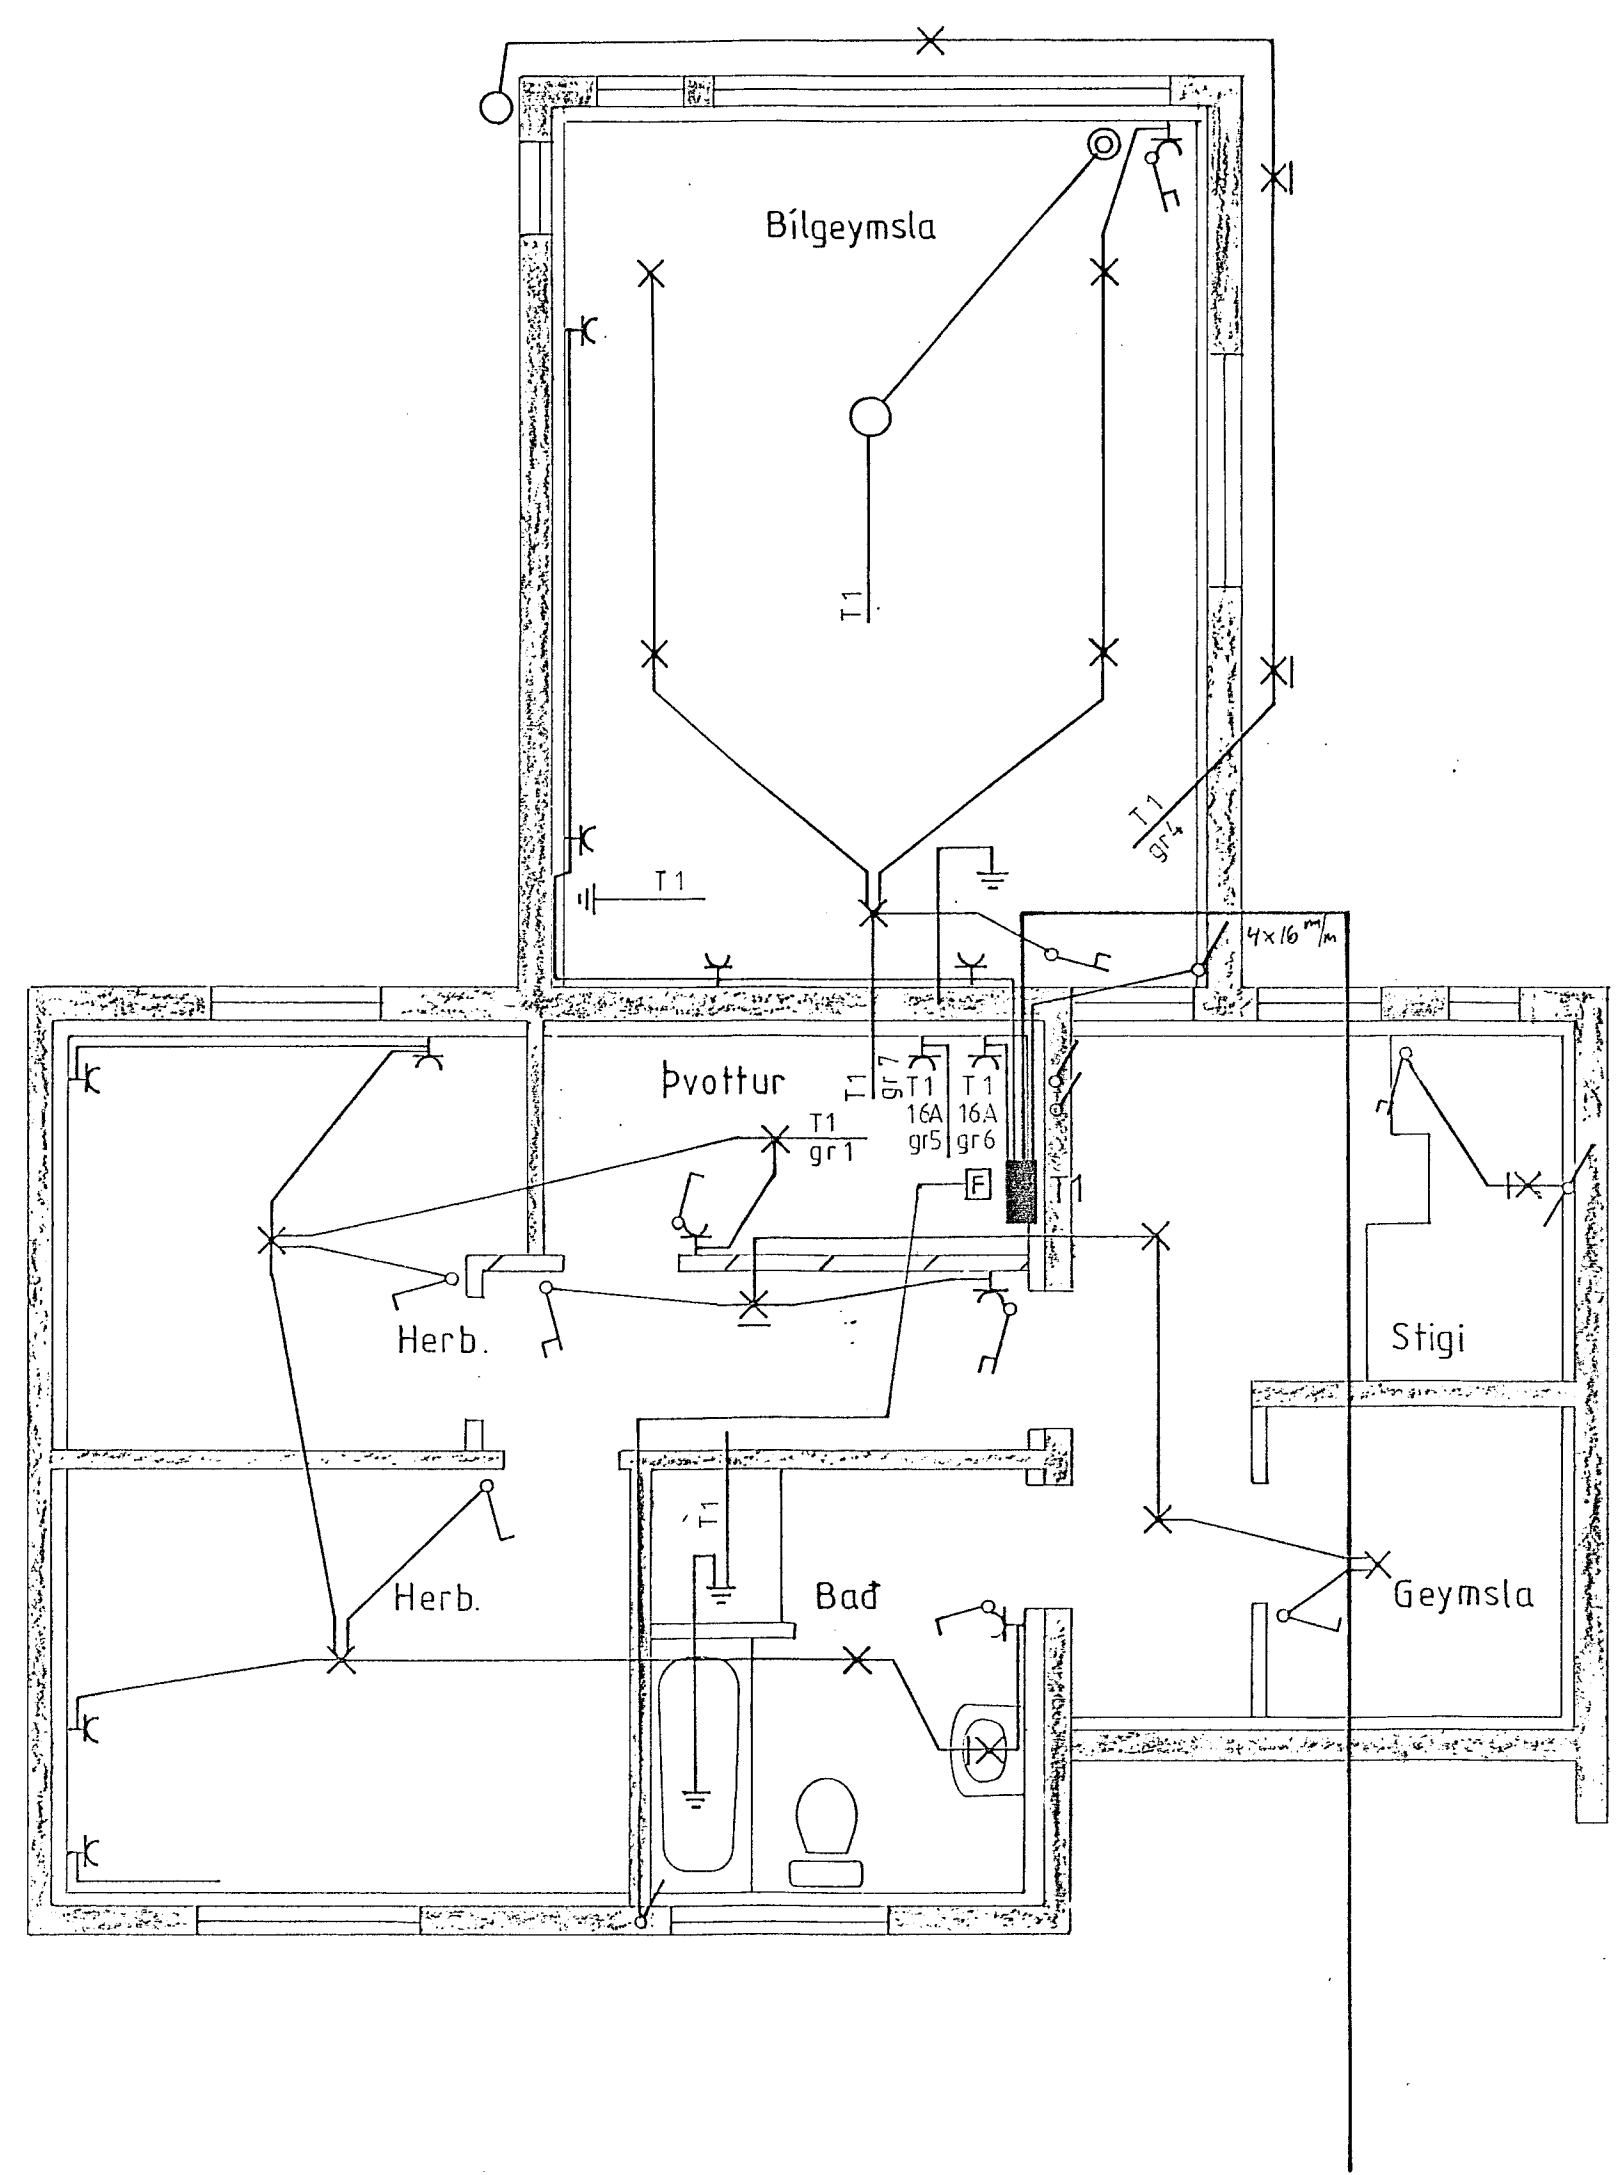

Suðurgata 56 Hafn. | teikning no. 87
 Rafnateikning | blað 1 af 2
 Grunnmynd | mkv. 1:50
 dags. sep 91
 Þórður K Kristjánsson Rafvirki s. 54750 | hannad þorður K
 V Elma Cates | teiknad 11/12/91

TEIKNING NR. 2996