

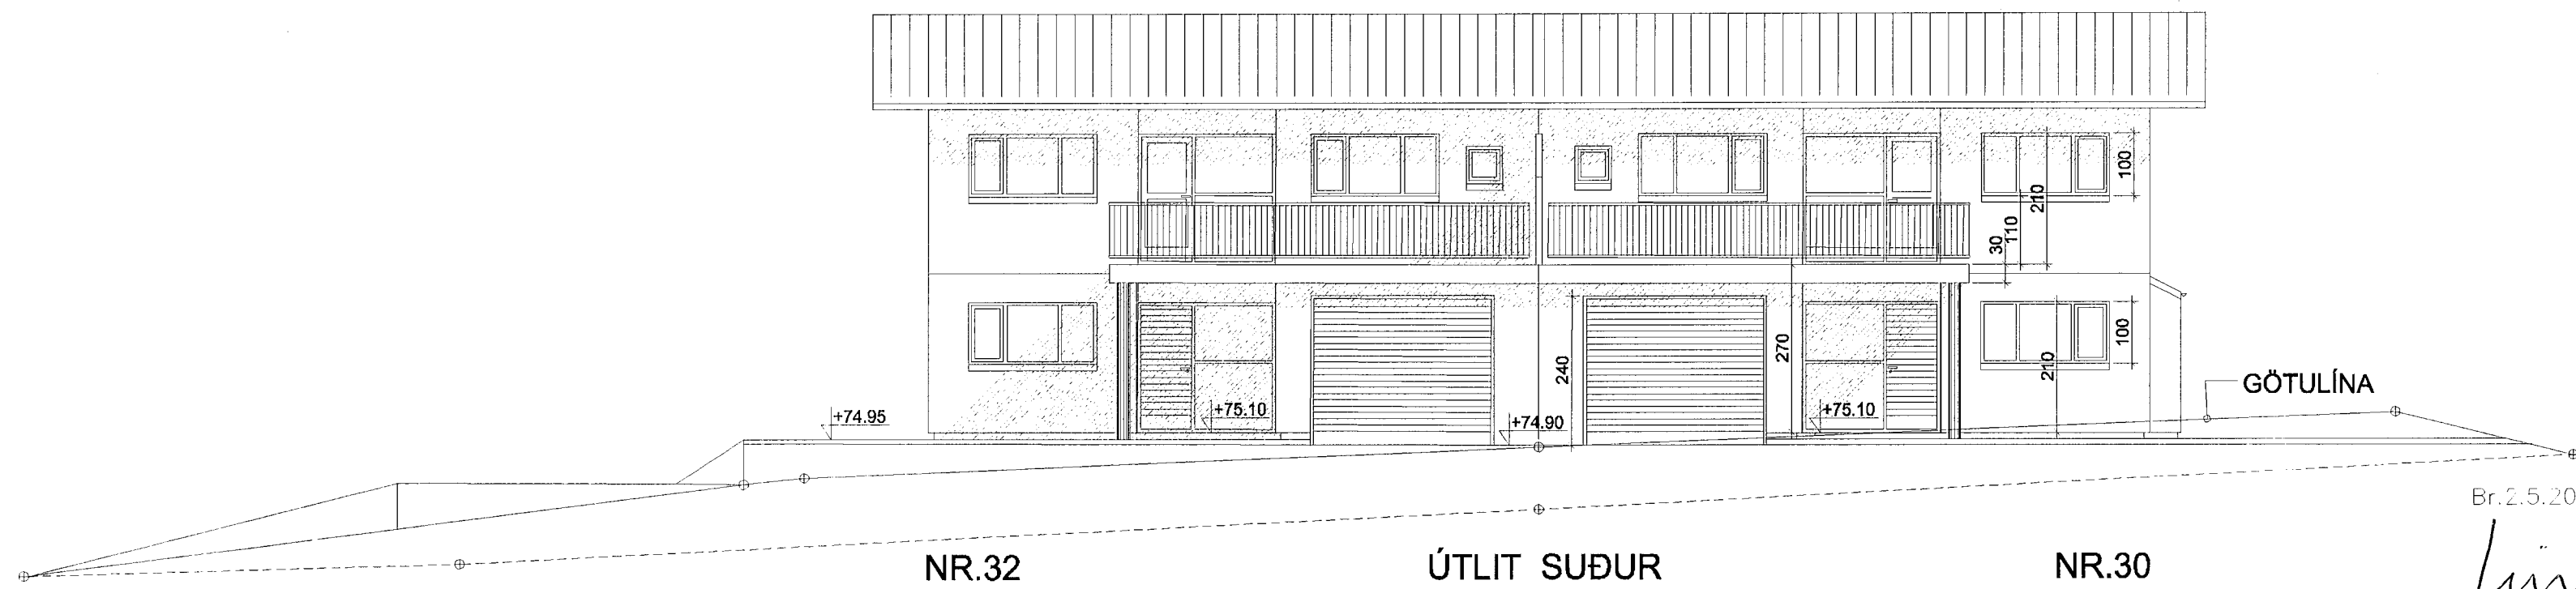


Samþykkt þann
 01 APR. 2014
 Byggingafultrúinn í Hafnarfirði
 F.h. Brynjar Rafn Ólafsson

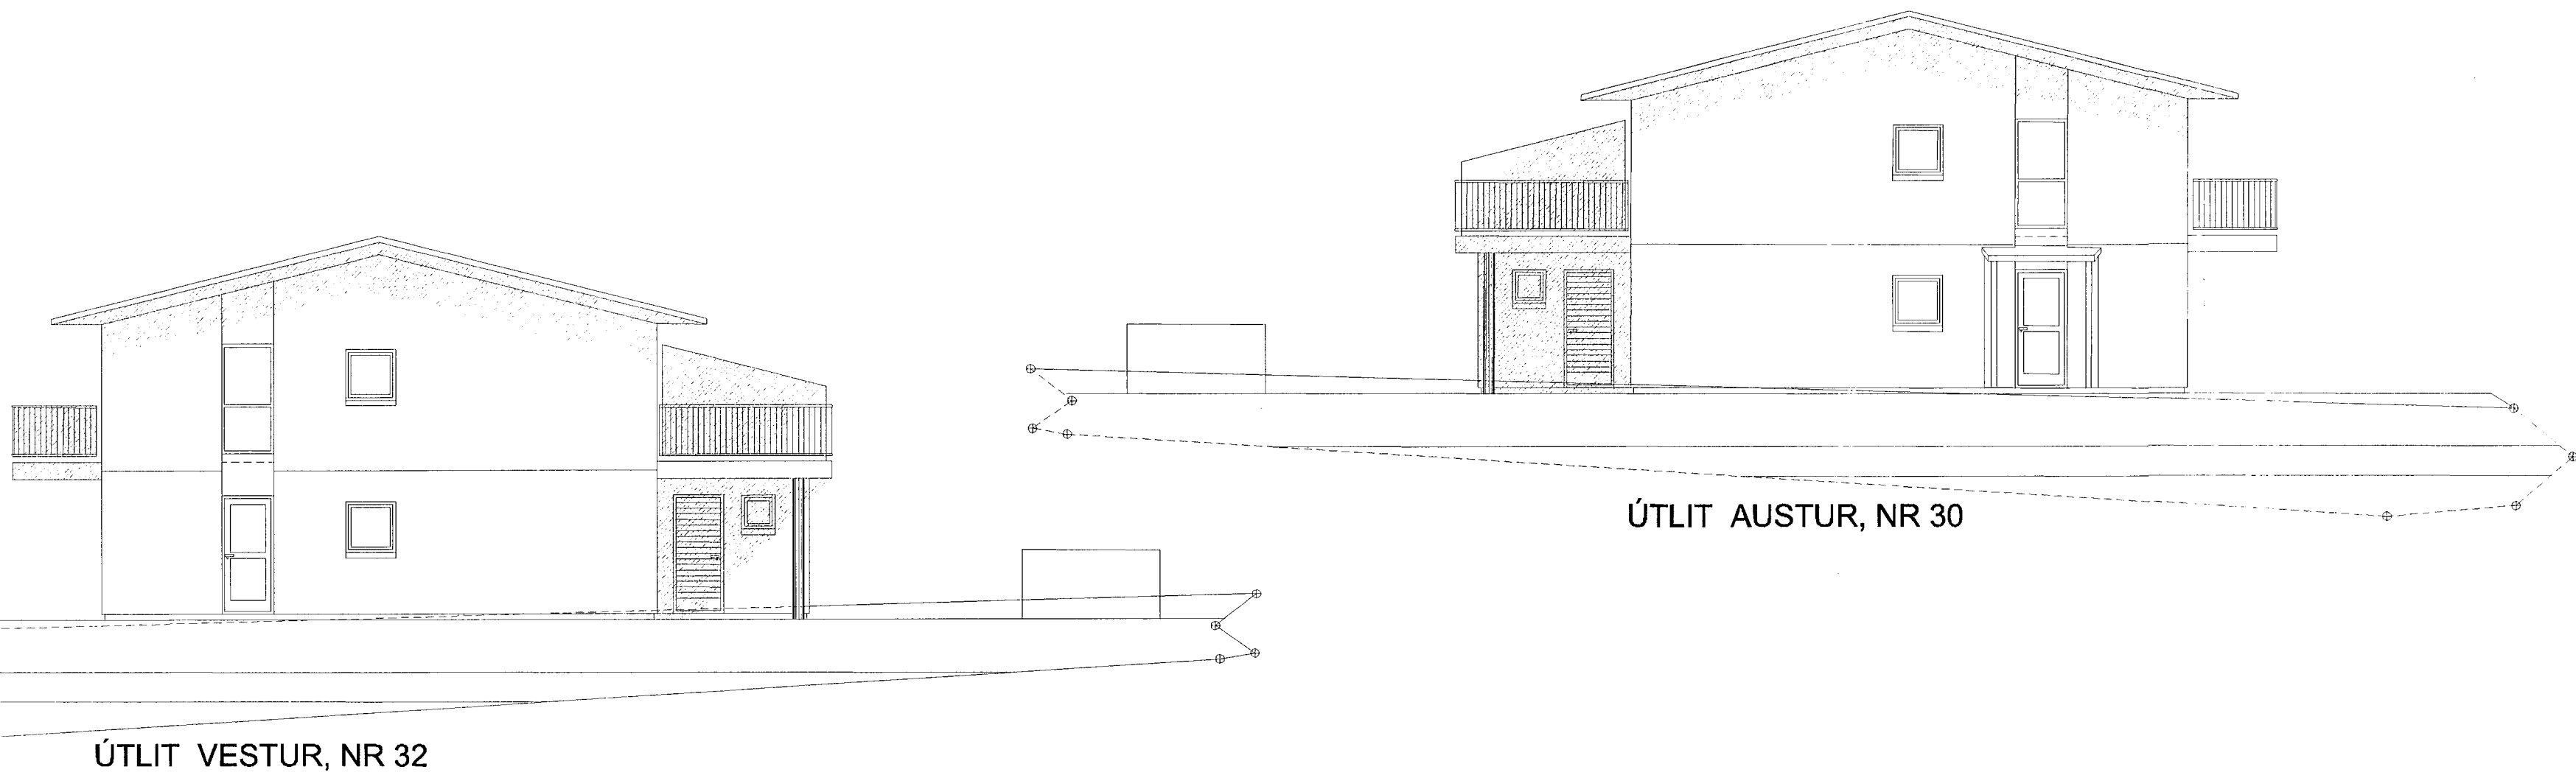

Br.2.5.2014: Ibbið, ný skráningartafla, skyggní v. austurgafi

Sigurbjörn Adalsteinsson
 SVÖLUÁS 30-32, HAFNARF. BL. 04

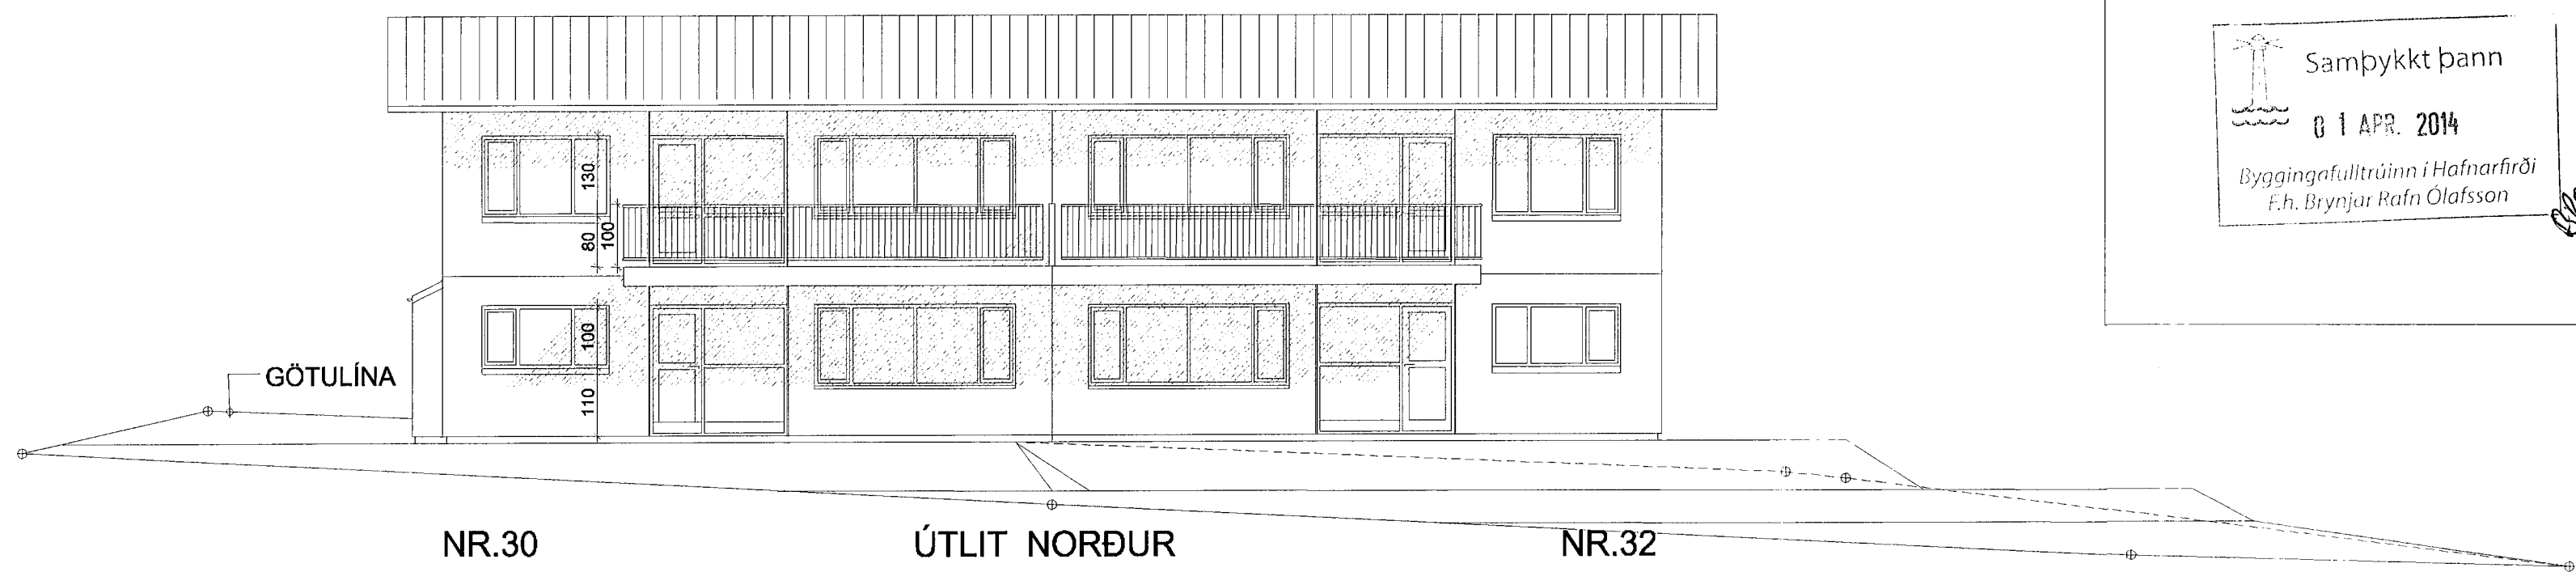

ÞRÍÐJA HÉÐIN, ARKITEKTAR — SIGURBJÖRN ADALSTEINSSON FAI
 ÚTLITSMYNDIR

STRANDGÖTU 28 220 HAFNARFIRÐI
 Sími: 555 46 10 FAX: 565 48 31
 KT: 250144_3979

NETFANG: sig@stania.is

HAMNAD: SA TEIKNAD: SA D.: G. x. 3. 8. 2001 M.K.V.: 1:100 VERKNR: