




SNIED 1 x 1 20

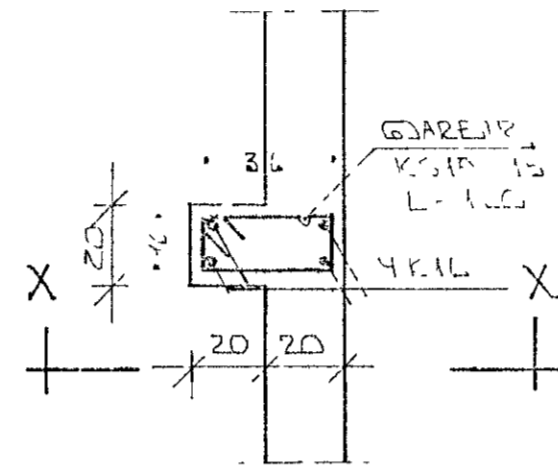


SULA SI 1 20

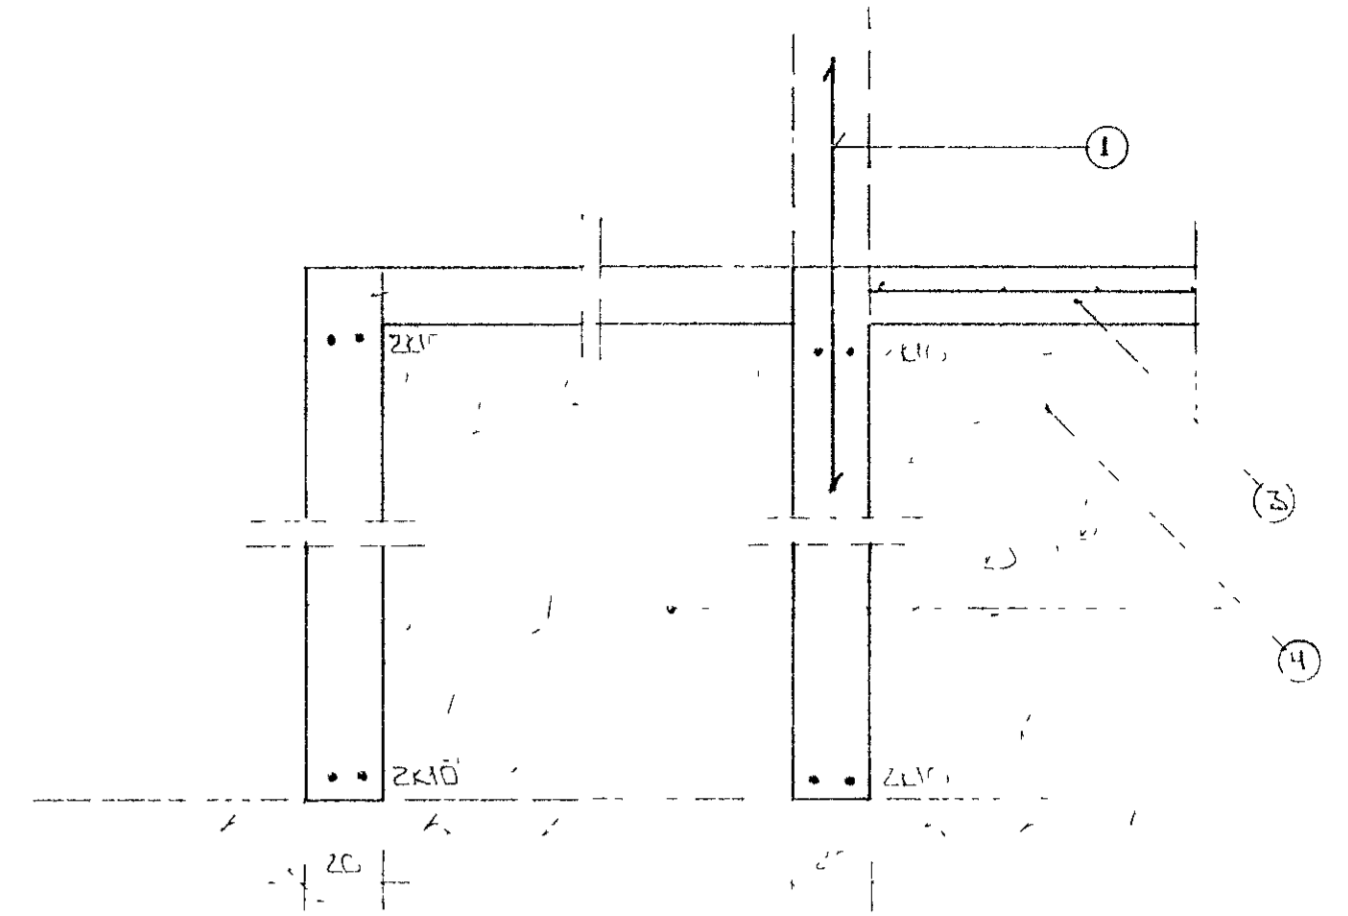

SNIED 3 x 1 20

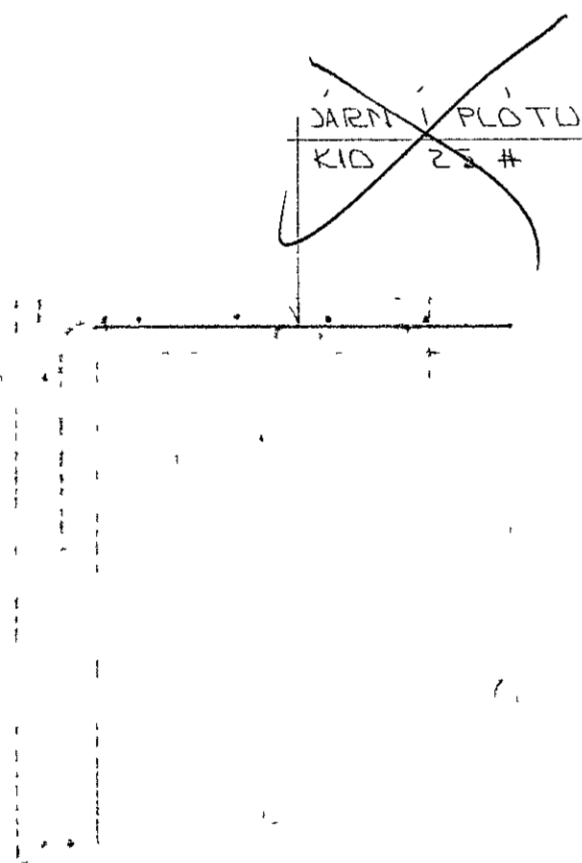

SNIED 1 x 1 20

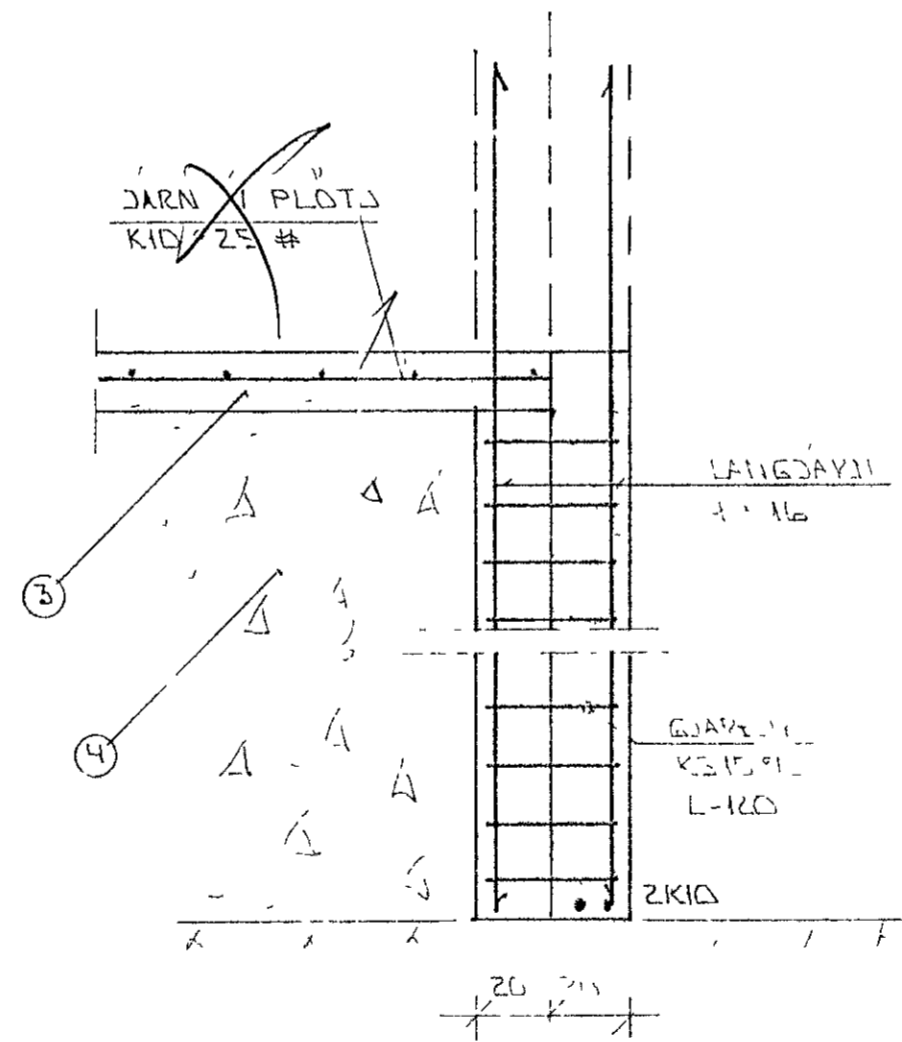

X - X 1 20



Sjá líkun 203

18 AUG 1993

Wp.

DRANGAHRÁUN & HAFNARFIREDI

DES' 88

8

8116

1-03