
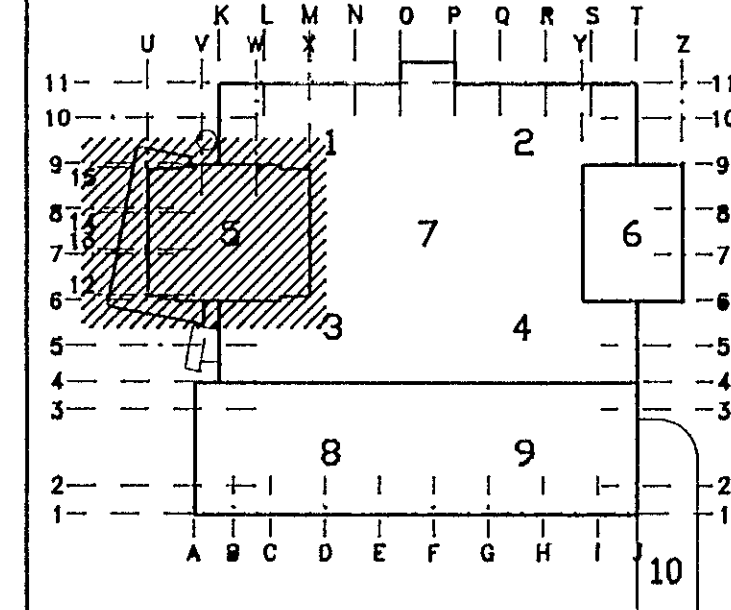


A	2	TENQJARNUM BÆTT INN TILVIÐUR LEIÐRETT	15.06.93
NR	FJÖLDI	BRÉYTINGAR	DAGS SAHF

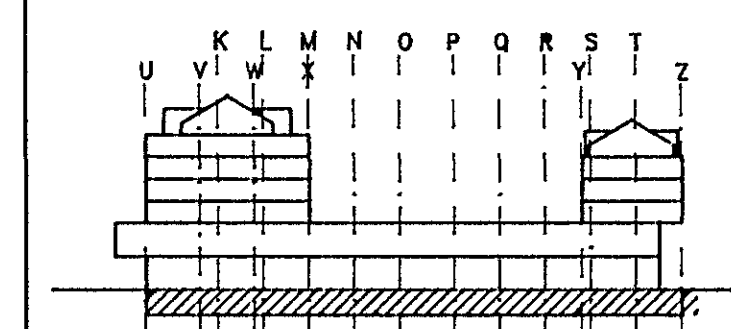

MIDBÆR
HAFNARFJARÐAR
 FJARDARGATA 13-15

ALMENNA
VERKFRÆÐISTOFAN HF
 FELLSMÖLA 26 - 108 REYKJAVÍK
 Sími (91) 678100 FAX (91) 680284

HEITI
BURDARVIRKI
 O. HÆÐ. HLUTI 5
 BOTNPLATA. GRUNNMYND

MÁL	1:50	/	/	/	/
HAHNAÐ	G.S.	TEIKNAD	G.S.	TEIKNAD	SAHF
DAGS	18/05 1993				
TEIKNING NR.	1032-B-114	BRÉYTING NR.	A		

21 JUN 1993
 ÁSKILID, ELÐRI
 TEIKNING ÓGILD

