


B.	3	Bett, við spöllum 3,4 og 6	01.09.93 U.F.
A	1	Snúli 4 bett inn	15.06.93 U.F.
NR	FJÖLDI	ÞREYTINGAR	DAGS SAHM

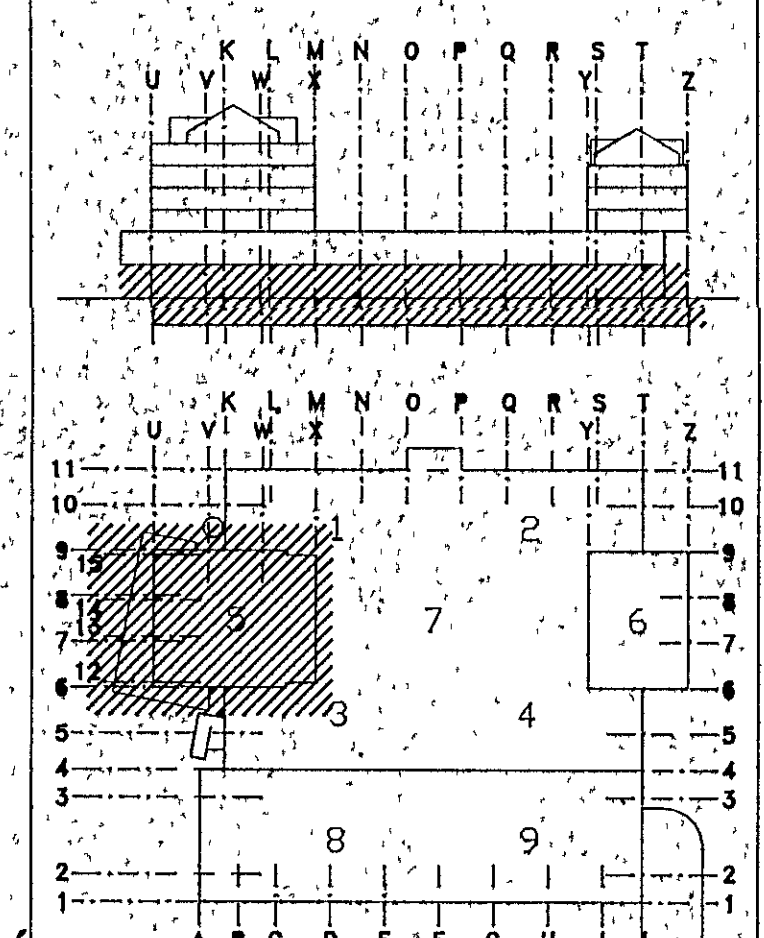

ÁSKILIÐ, ELÐRI  
TEIKNING ÓGIL  
09 SEP 1993

**MIDBÆR**  
HAFNARFJARÐAR  
FJARÐARGATA, 13-15

ALMENNA  
VERKFRÆÐISTOFAN HF  
FELLSMÚLA 26 - 105 REYKJAVÍK  
SÍMI (91) 678100 FAX (91) 680284

HEITI  
BURÐARVIRKI  
0. - 2. HÆÐ, HLUTI 5  
STIGAHÚS 1. SNID

M.:	1:20
HAHAÐ:	0.A.
TEIKNAR:	H.S.
YFIRVAK:	J.M.
SAHM:	57
DAGS:	18/05 1993
TEIKNING NR.:	1032-B-151
ÞREYTING NR.:	B'