



Byggingafultrúi Hafnarfjarðar
Móttækivátt
22 JUL 2014
[Signature]

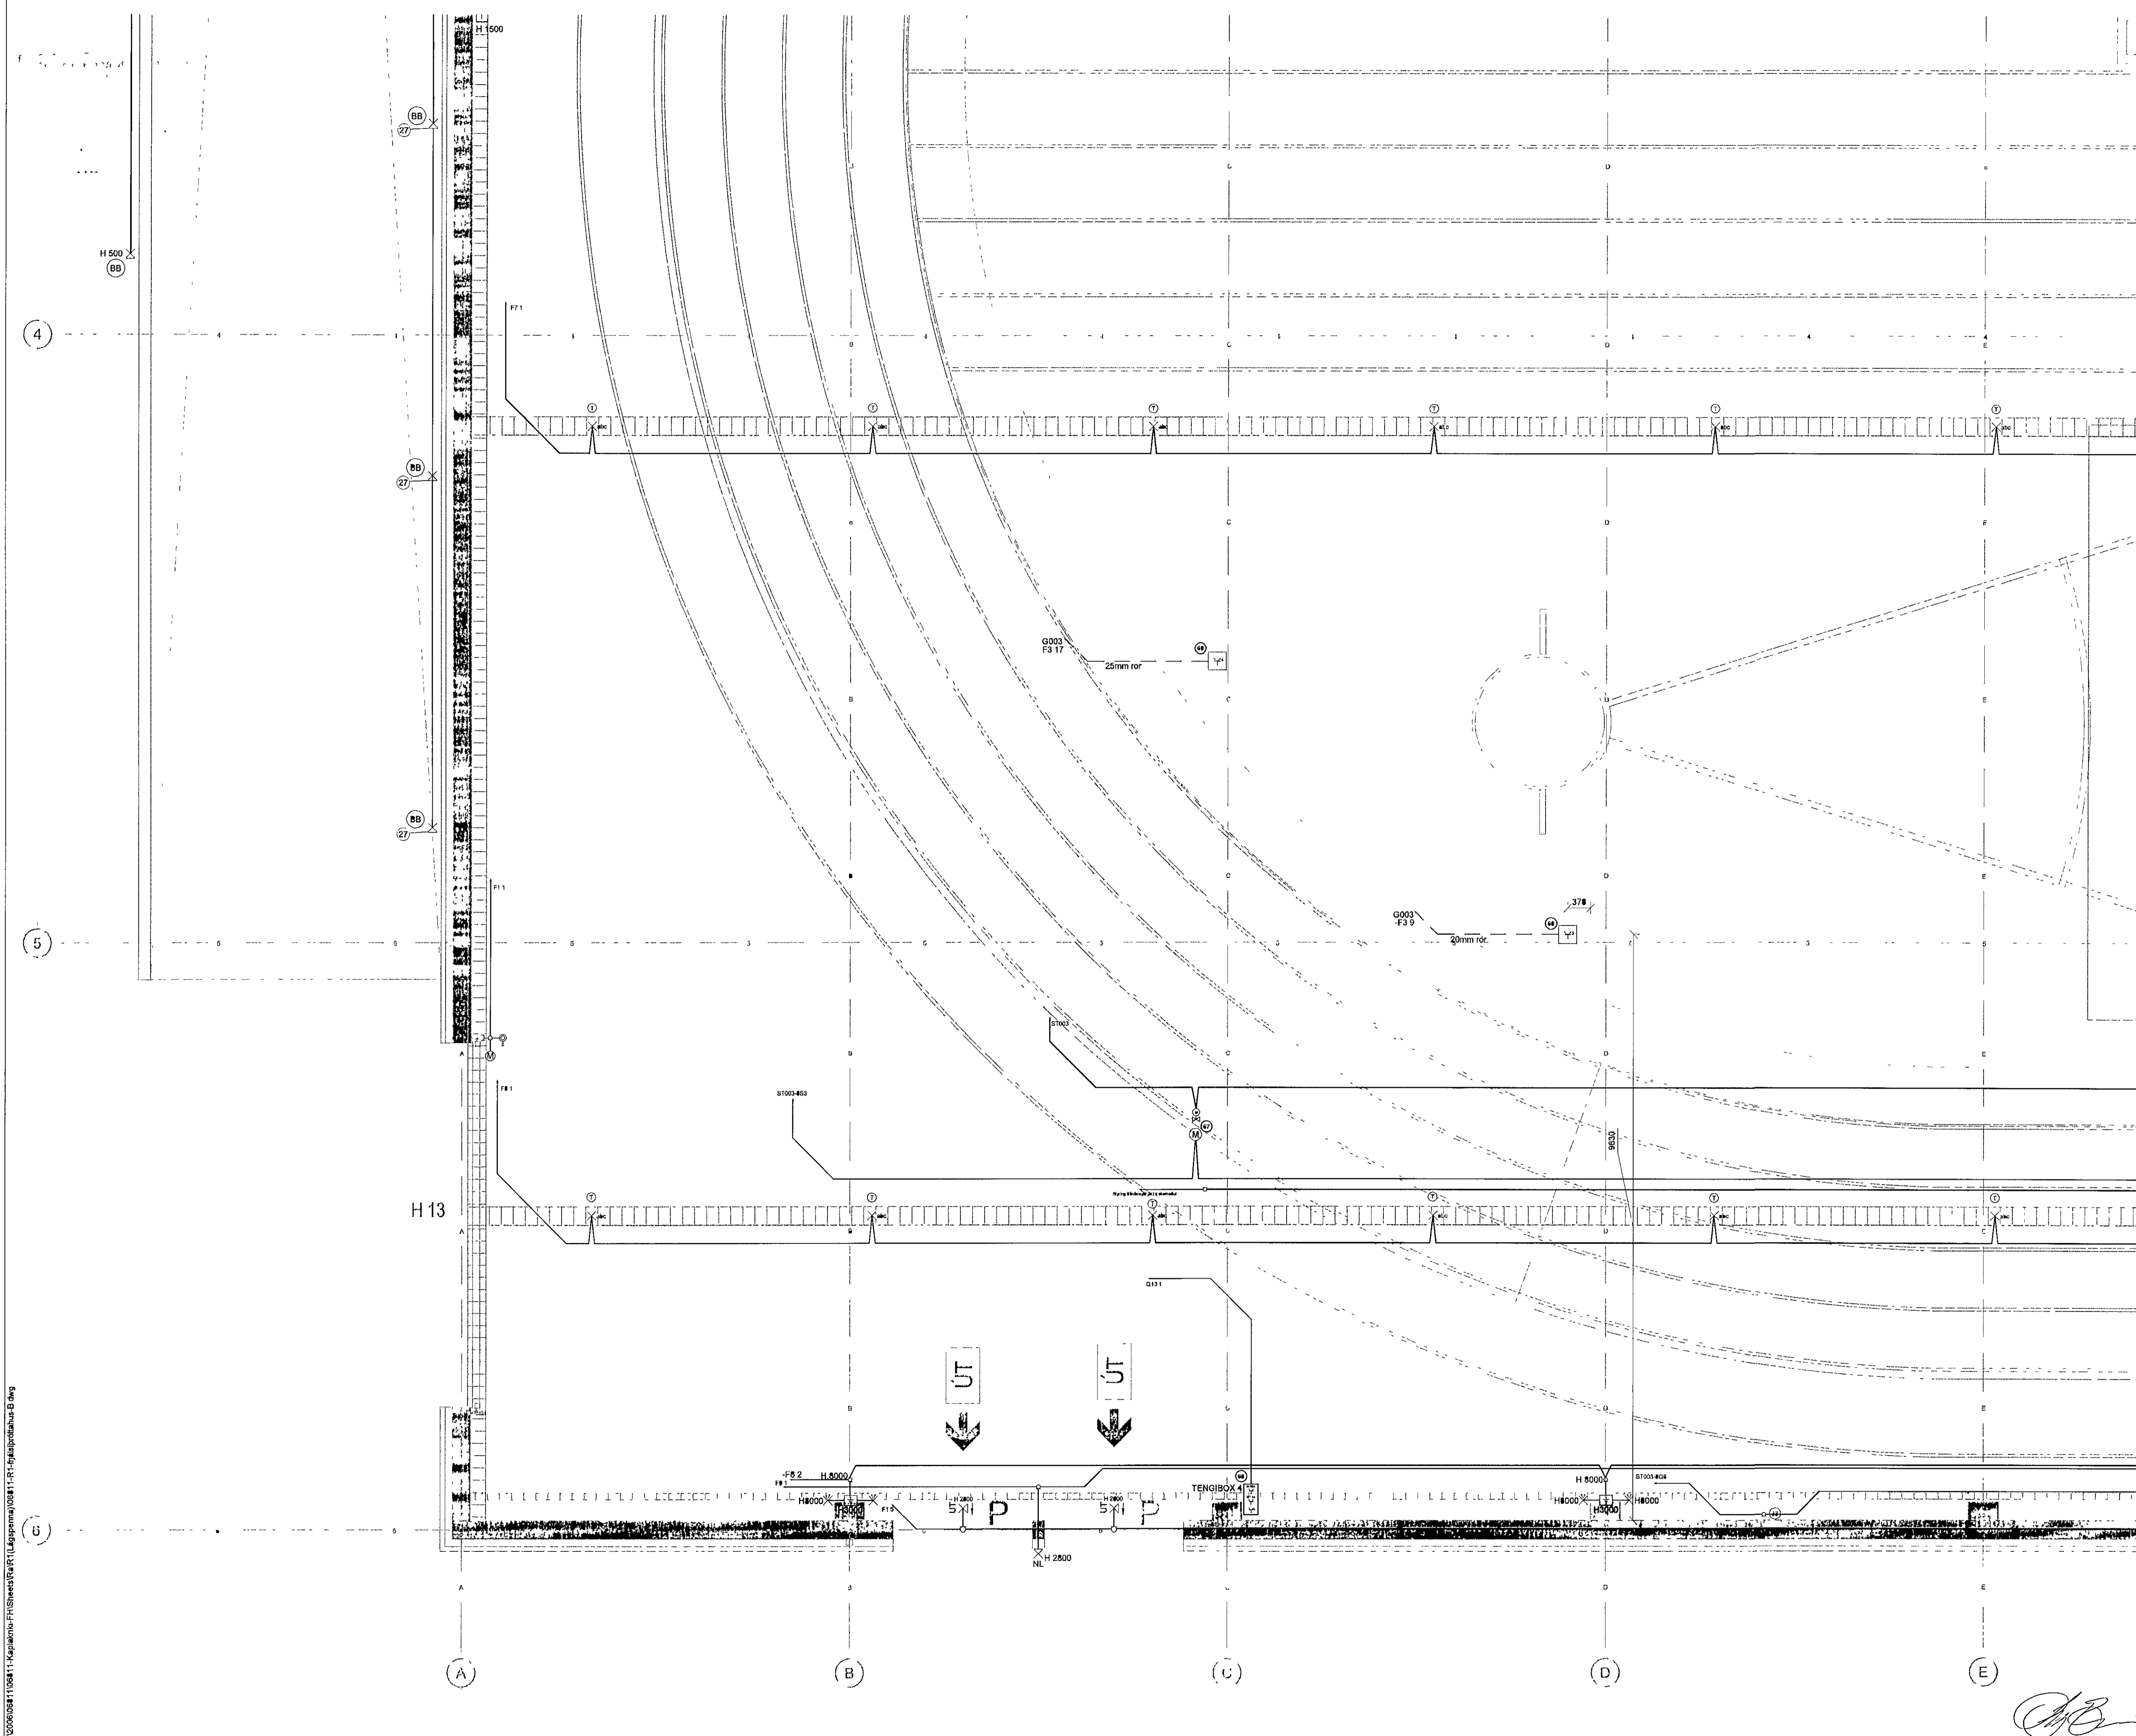

KAPLAKRIKI

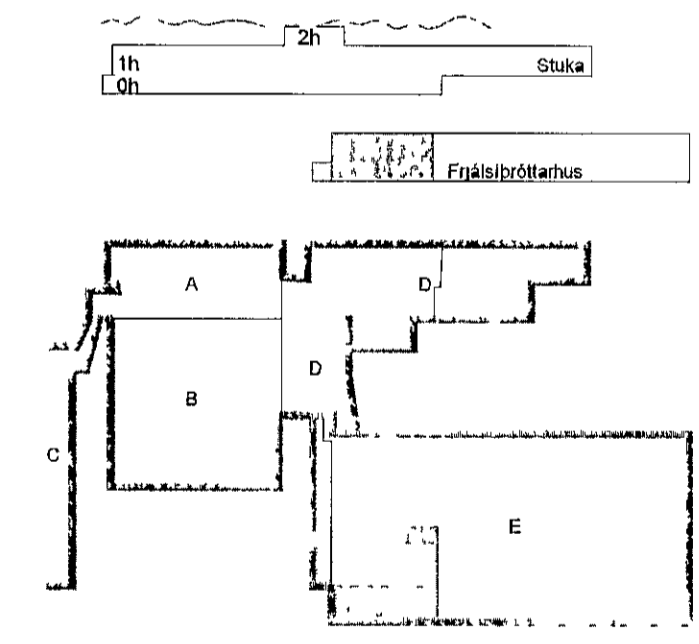

F	27.05.14	Reyndartekning	BSG/ÖG
E	01.10.10	Útboð 4	BSG/ÖG
D	02.08.10	Grenamerkingar og NL	BSG/ÖG
C	13.10.09	Gólfbox málið	BSG/ÖG
B	24.08.09	Rorum fjölgað	BSG/ÖG
A	17.08.08	Gólfbox færð til	SF/ÖG
Utg	Dags	Skýring	Hanna Ö. Yrflinó



VERKFRÆÐISTOFA

BÆJARHAUN 20 220 HAFNARFJÖRÐUR KENNIT 710796-2899
vsb@vsb.is Sími 585 8600 Fax 585 8610 www.vsb.is

Árðun sénonúmer
Örn Guðmundsson Kf 220961 2739 [Signature]

Verkefni			
KAPLAKRIKI			
HAFNARFIRÐI			
Verkið			
Rafkerfi			
Lagspenna frjálspróttahús			
Grunnmynd			
Hanna Ö.	Yrflinó	ÖG	1.50
RVK/HJ	RVK/HJ	ÖG	1/A1
Dags	Verkefni	Tekning	Utgáa
18.03.2008	06811	B R104	F

[Signature]

V:200608110811-Kaplakriki-FH-SheetsRafri(Lagspenna)0811-R1-Fjallpróttahús-B.dwg