


A BETTYD GLUGGUM PLÚS  
 LERKING A GLUGGUM 16.06.94  
 NR FJOLDI BREYTINGAR DAGS SAMP

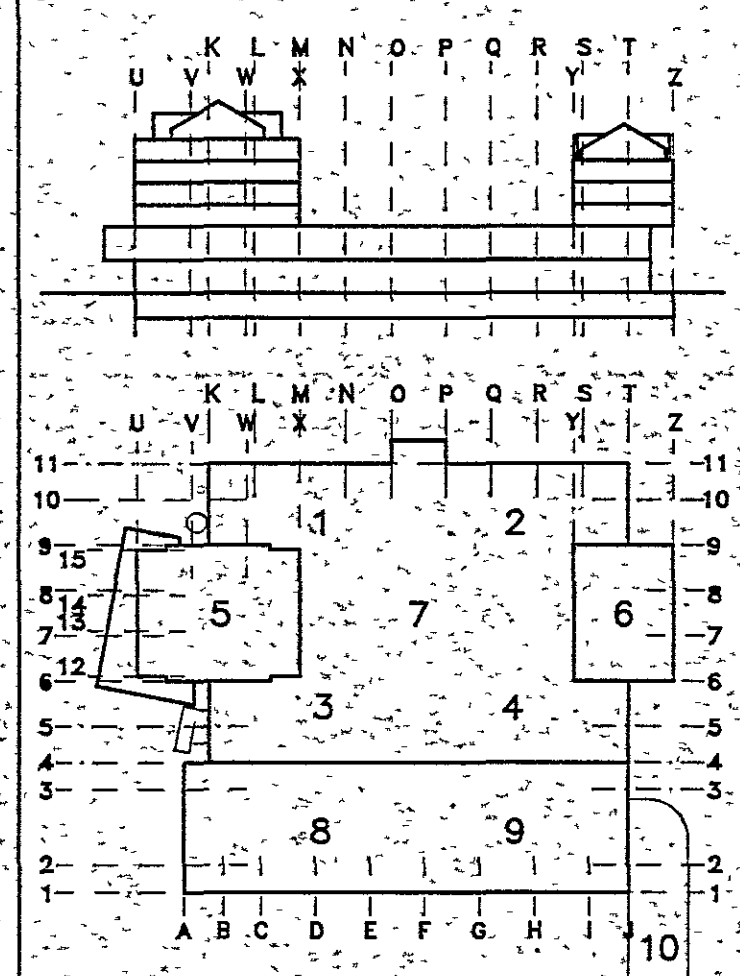

06 SEPT 1994

**MIDBÆR**  
**HAFNARFJARDAR**  
 FJARDARGATA 13-15.

TEIKNISTOFA ERLINGS G PEDERSEN  
 ARKITEKT F.A.L.  
 STORHÓFEDI 17 112 REYKJÁVIK  
 SÍMIL: 680088

KLÆDNINGAR  
 HJUDARMYNDIR  
 VESTURHLID, AUSTURHLID.

1:50  
 EGP HBS/EGP  
 01/03 1994  
 ARK : 41-09 A