




SNID A 1:20

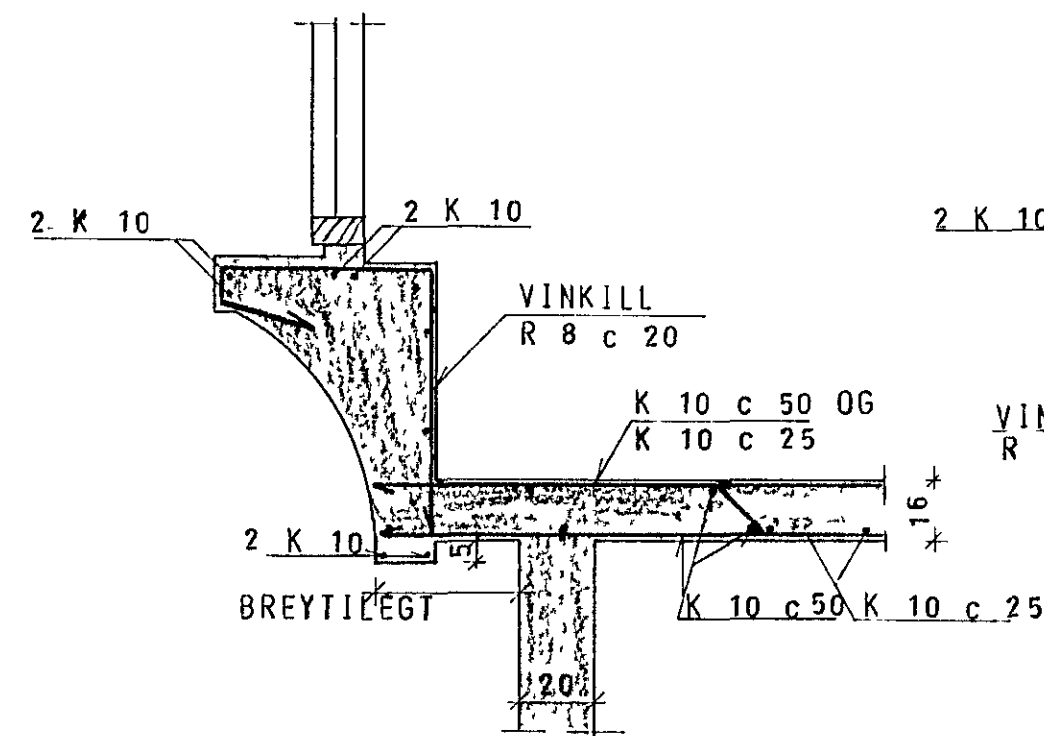


SNID C 1:20

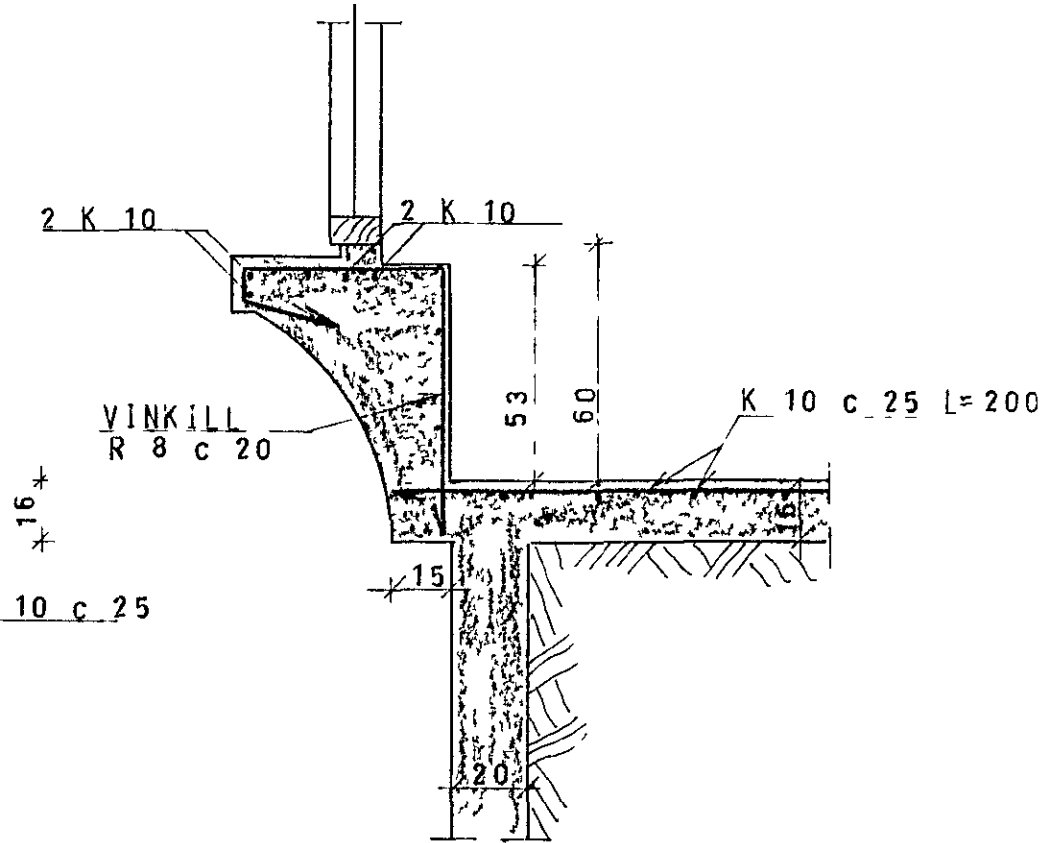


SNID E 1:20

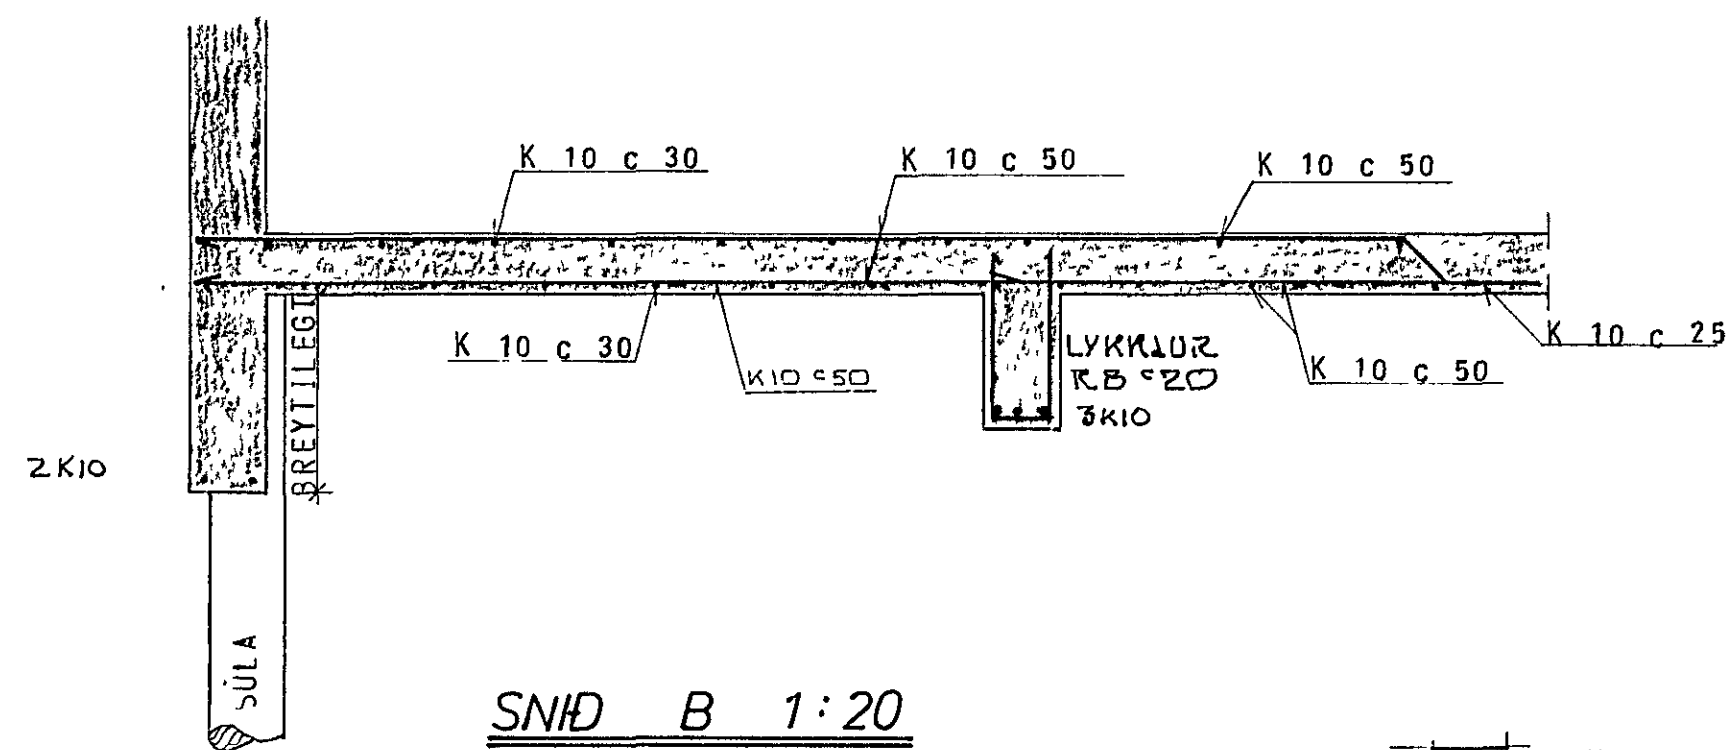


SNID B 1:20

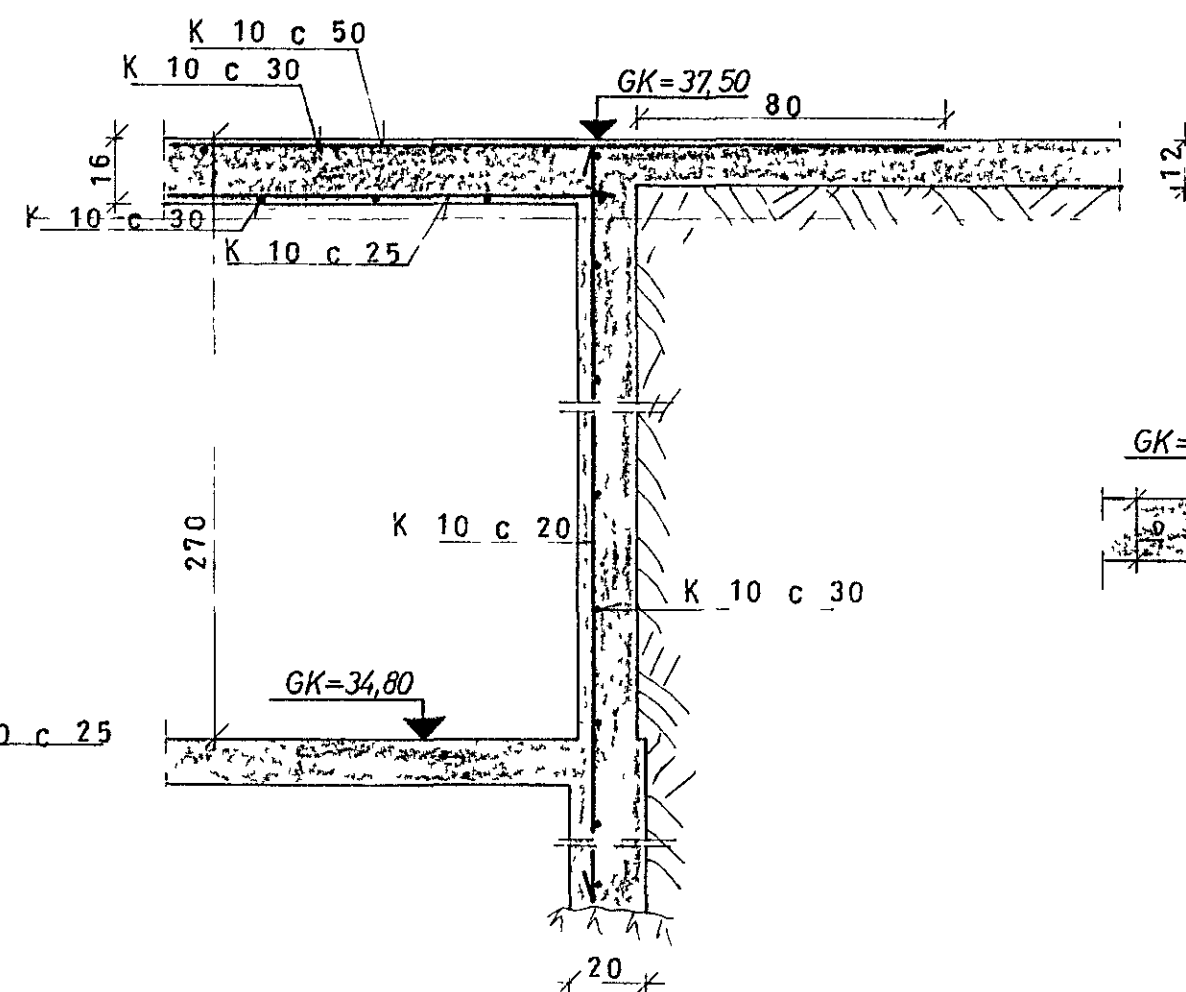


SNID D 1:20

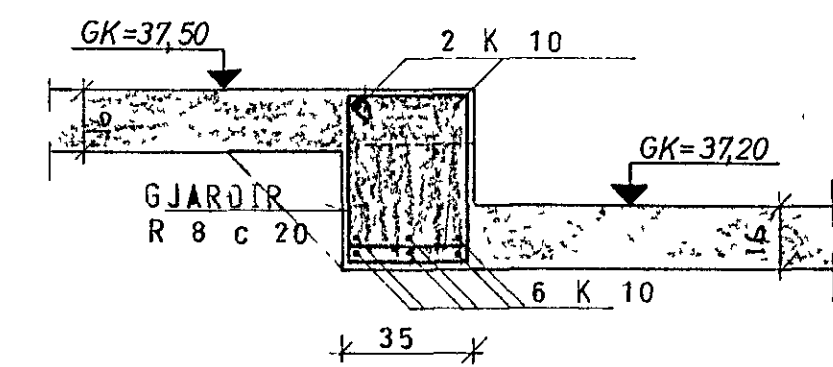

SNID F 1:20

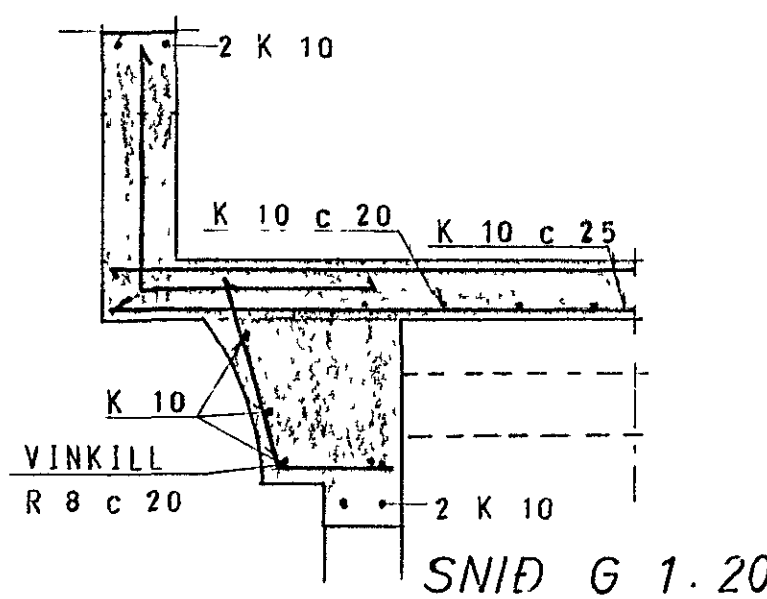

SNID G 1:20

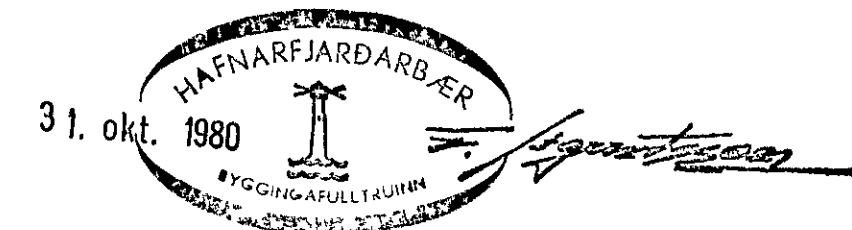

SKÝRINGAR SJÁ TEIKN NR 10

FJÓLUHVAMMUR 6, HAFNARFIRÐI	MÆLIKVARÐI 1:20	VERK 7925	TEIKN NR 17
SNID	Hanna Teiknað 27	Yfirfarir Samb	DAGS JÚNÍ '80
JÓHANN GUNNAR BERGPÓRSSON STRANDGÖTU 11 — HAFNARFIRÐI — SÍMI 53315	VERKFR MVFI	BREYTT	