
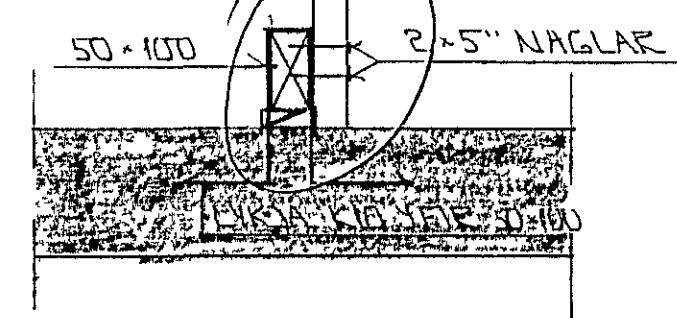




Ræddi vid Svuma
þjá Sigga þi og
bentir á ósamræni
engin níðbrögsl.

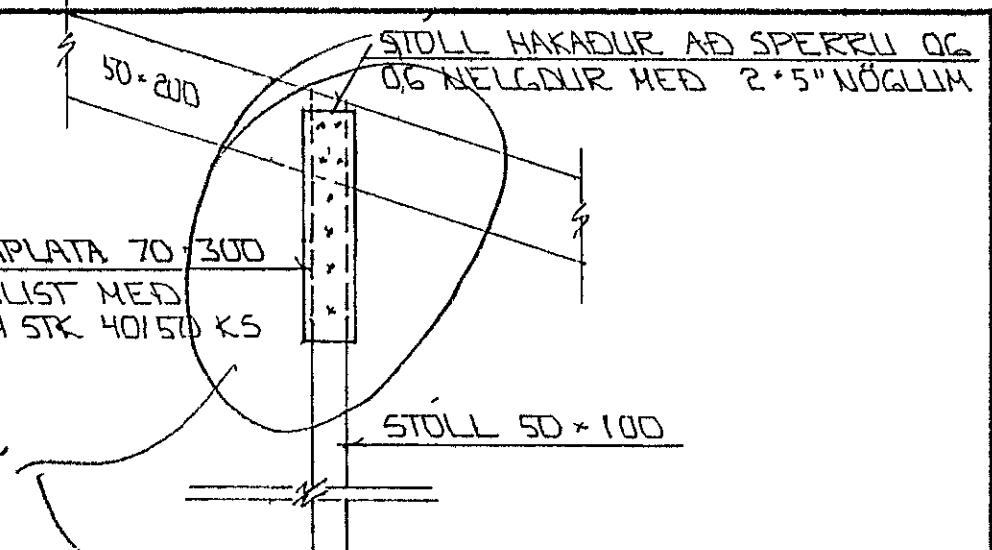

SPERRUFESTING
K10 L=120

PESSI FRÁGANGUR EINNIC
HEMLADUR


FRÁGANGUR PAKKANTS
SJA SÉRTIKN ARK
2 stk 626 - í hvert sperruból

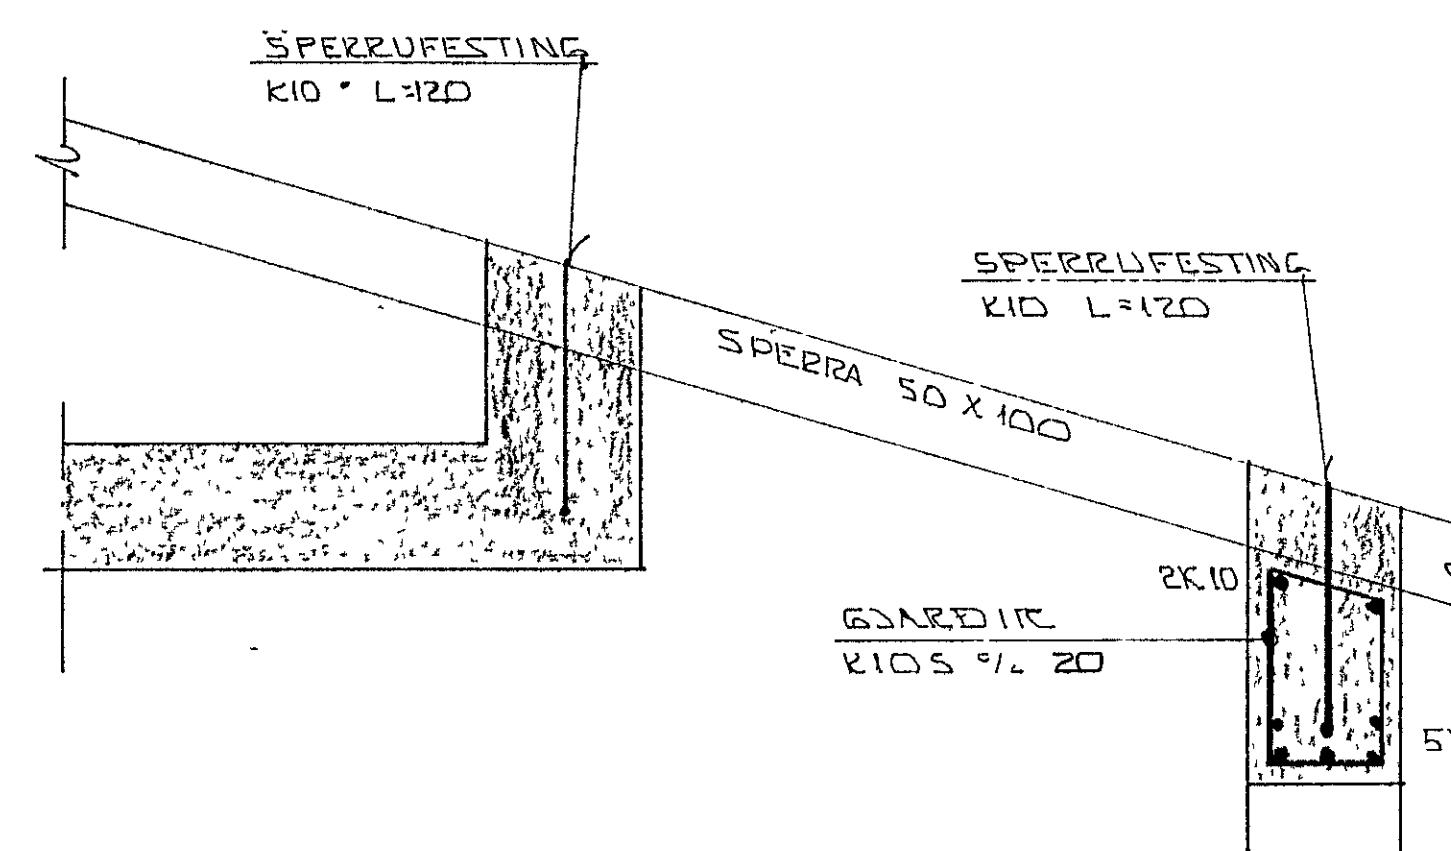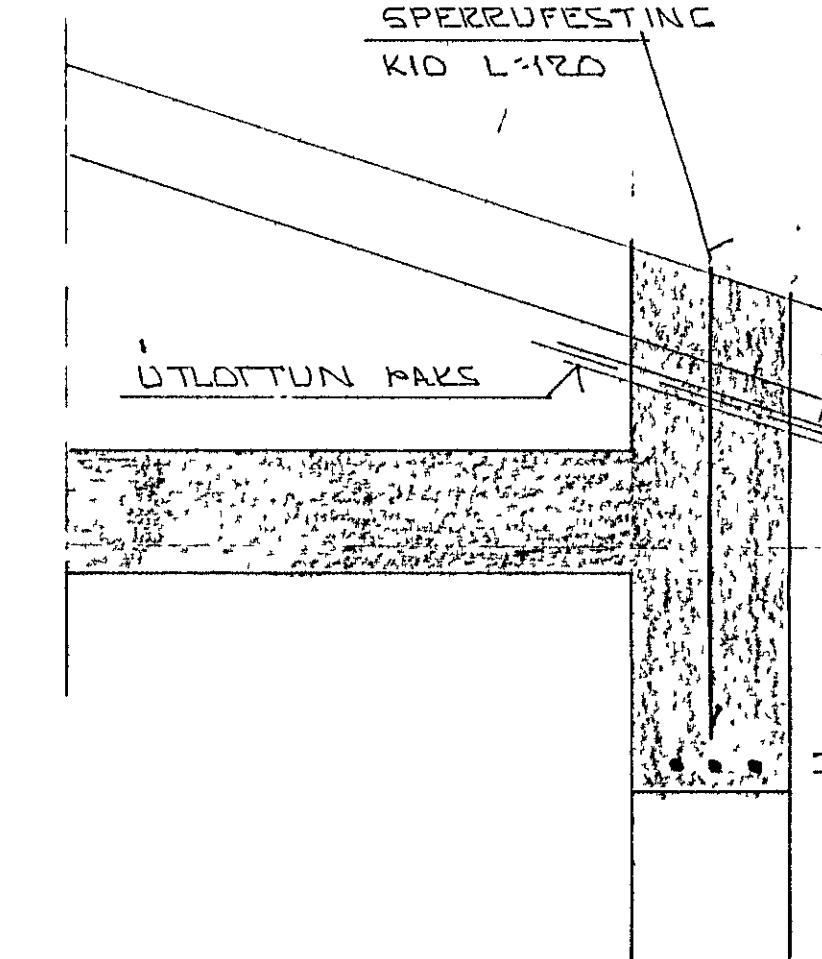

SNID 8 - 8 + 1:10

SKYRINGAR.

ALMENNAR SKYRINGAR SJA BL NR. 1-01
SNID MERKT 7-7 OG 8-8 SJA BL NR 1-08

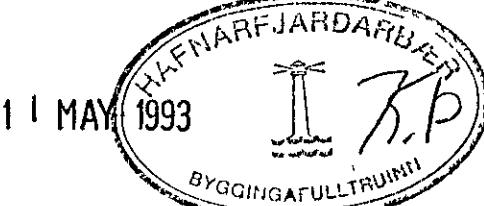

01 MAI 93	FRÁGANGI STÓLA BR	64
BRNRK	DAGS	EÐLI BRETINGAR
HÁHOLT LZ HAFNARFIRDI		
SNID í PAKVIRKI		
MELIKV. A 1:10		
SIGURÐUR ÞORLEIFSSON TEKNIFRÆÐINGUR F.T.F.I.		
STRANDGOTU 11 HAFNARFIRDI SIMI 54751/54255		
BLAD NR 1-09		