


ALTERNAR SKYRINGAR SJA DL 1-01

BR	DAGS	EDLI BR	SIGN

HÁHDLT 16
HAFNAFIRÐI
BÍLGEYMSLA UNDIRSTÖÐUR

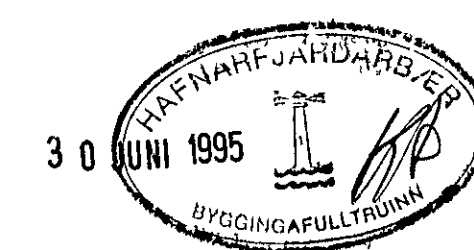

DAGS	JUNI 95
VERK NR	9529
TEIKN NR	1-02
HANNAÐ	AV
TEIKNAD	AV
YFIRFARIÐ	