



AFSTÖÐUMYND 1500

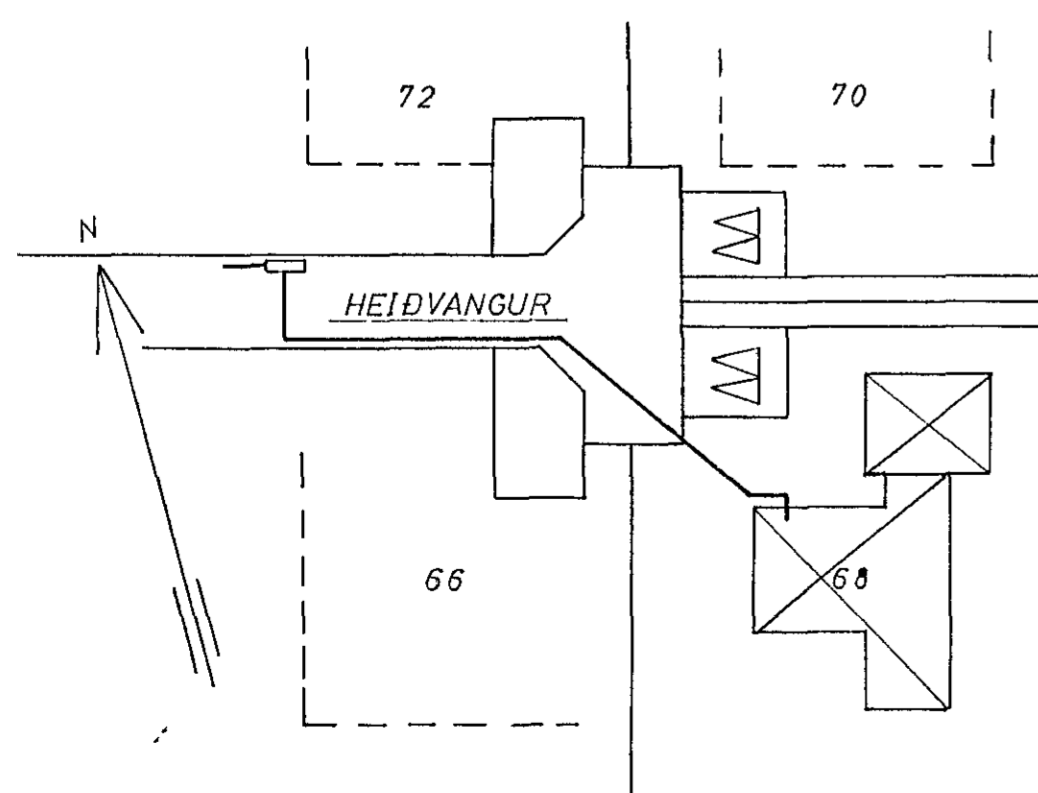

SNID A-A 1 20

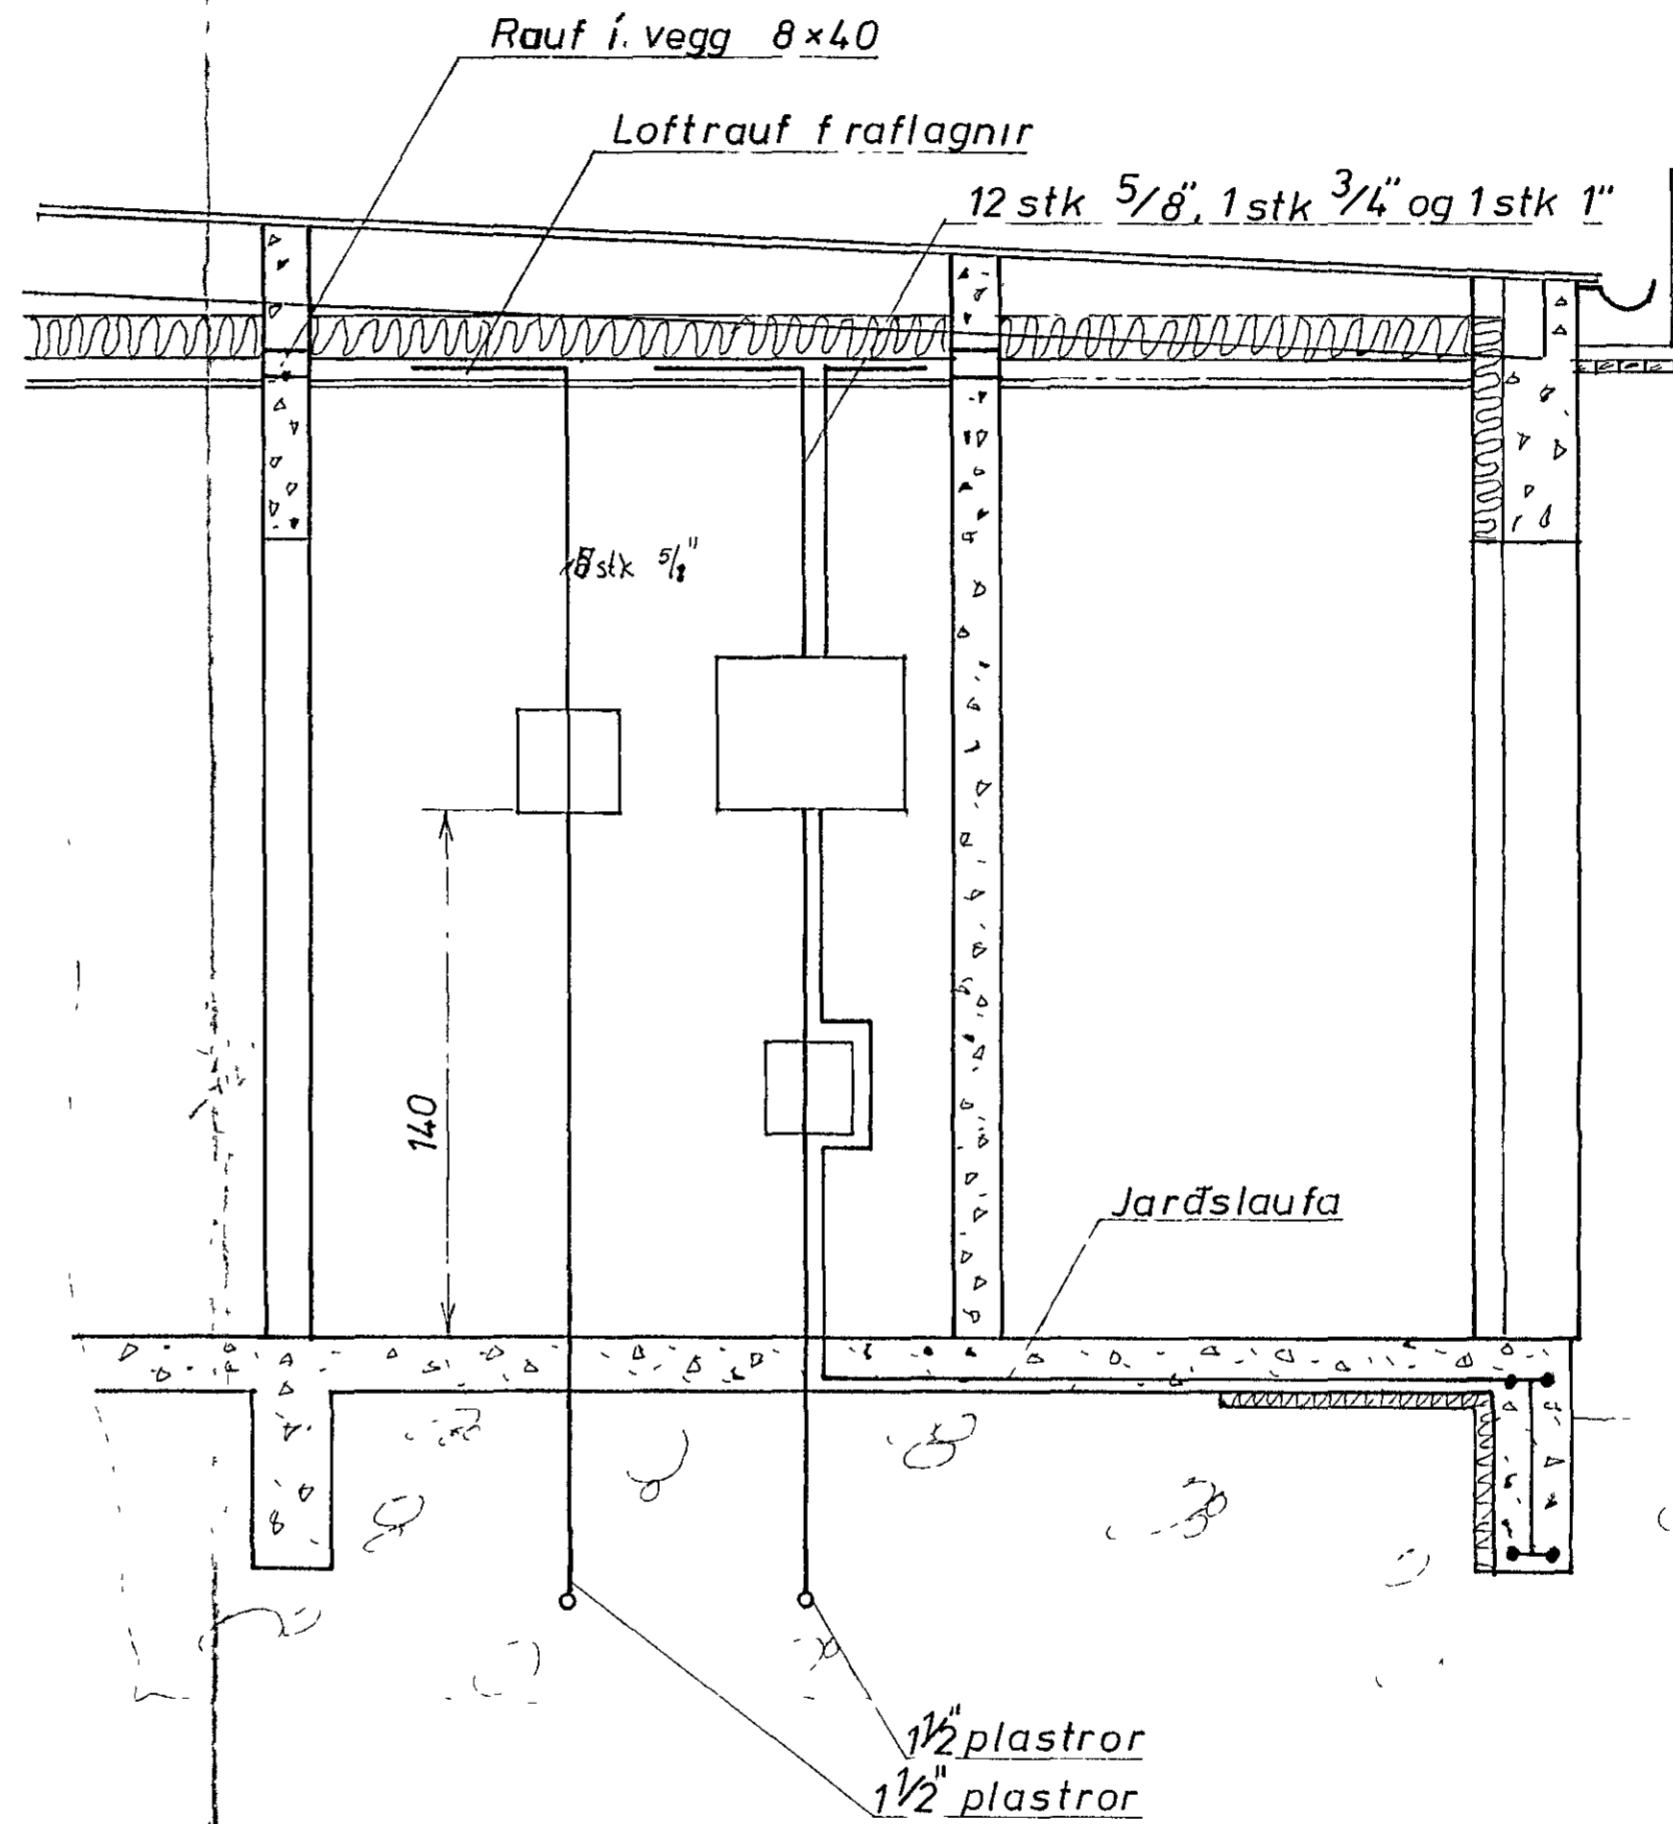

Húsvæta nr 2238 Teikning nr 1147
 Samþykkt þ 28.8.1973
 f h RAFVEITU HAFNARFIJARDAR
 Björn Jóhannsson
 Eftirlitsmaður rullagna

Inntök samþykkt 28.18.1973
 f h RAFVEITU HAFNARFIJARDAR
 Albert Þorsteinsson

| Breyting | | | INGVI I. INGASON IT FÍ |
|----------|------|------|---------------------------------------|
| Nr | Dags | Nafn | |
| | | | Verkefni. Heiðvangur 68 Hf. |
| | | | H.P.P.P.S Mkv 1500 1 20 Nr 5-02 |
| | | | Dags 19-8-73 |
| | | | Samþ Ingvi Ingason |