
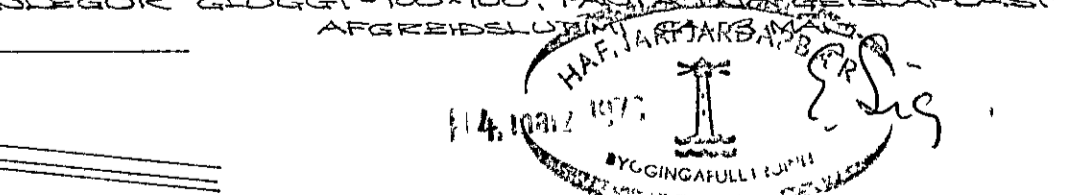


HJALLABEANT NR. 78

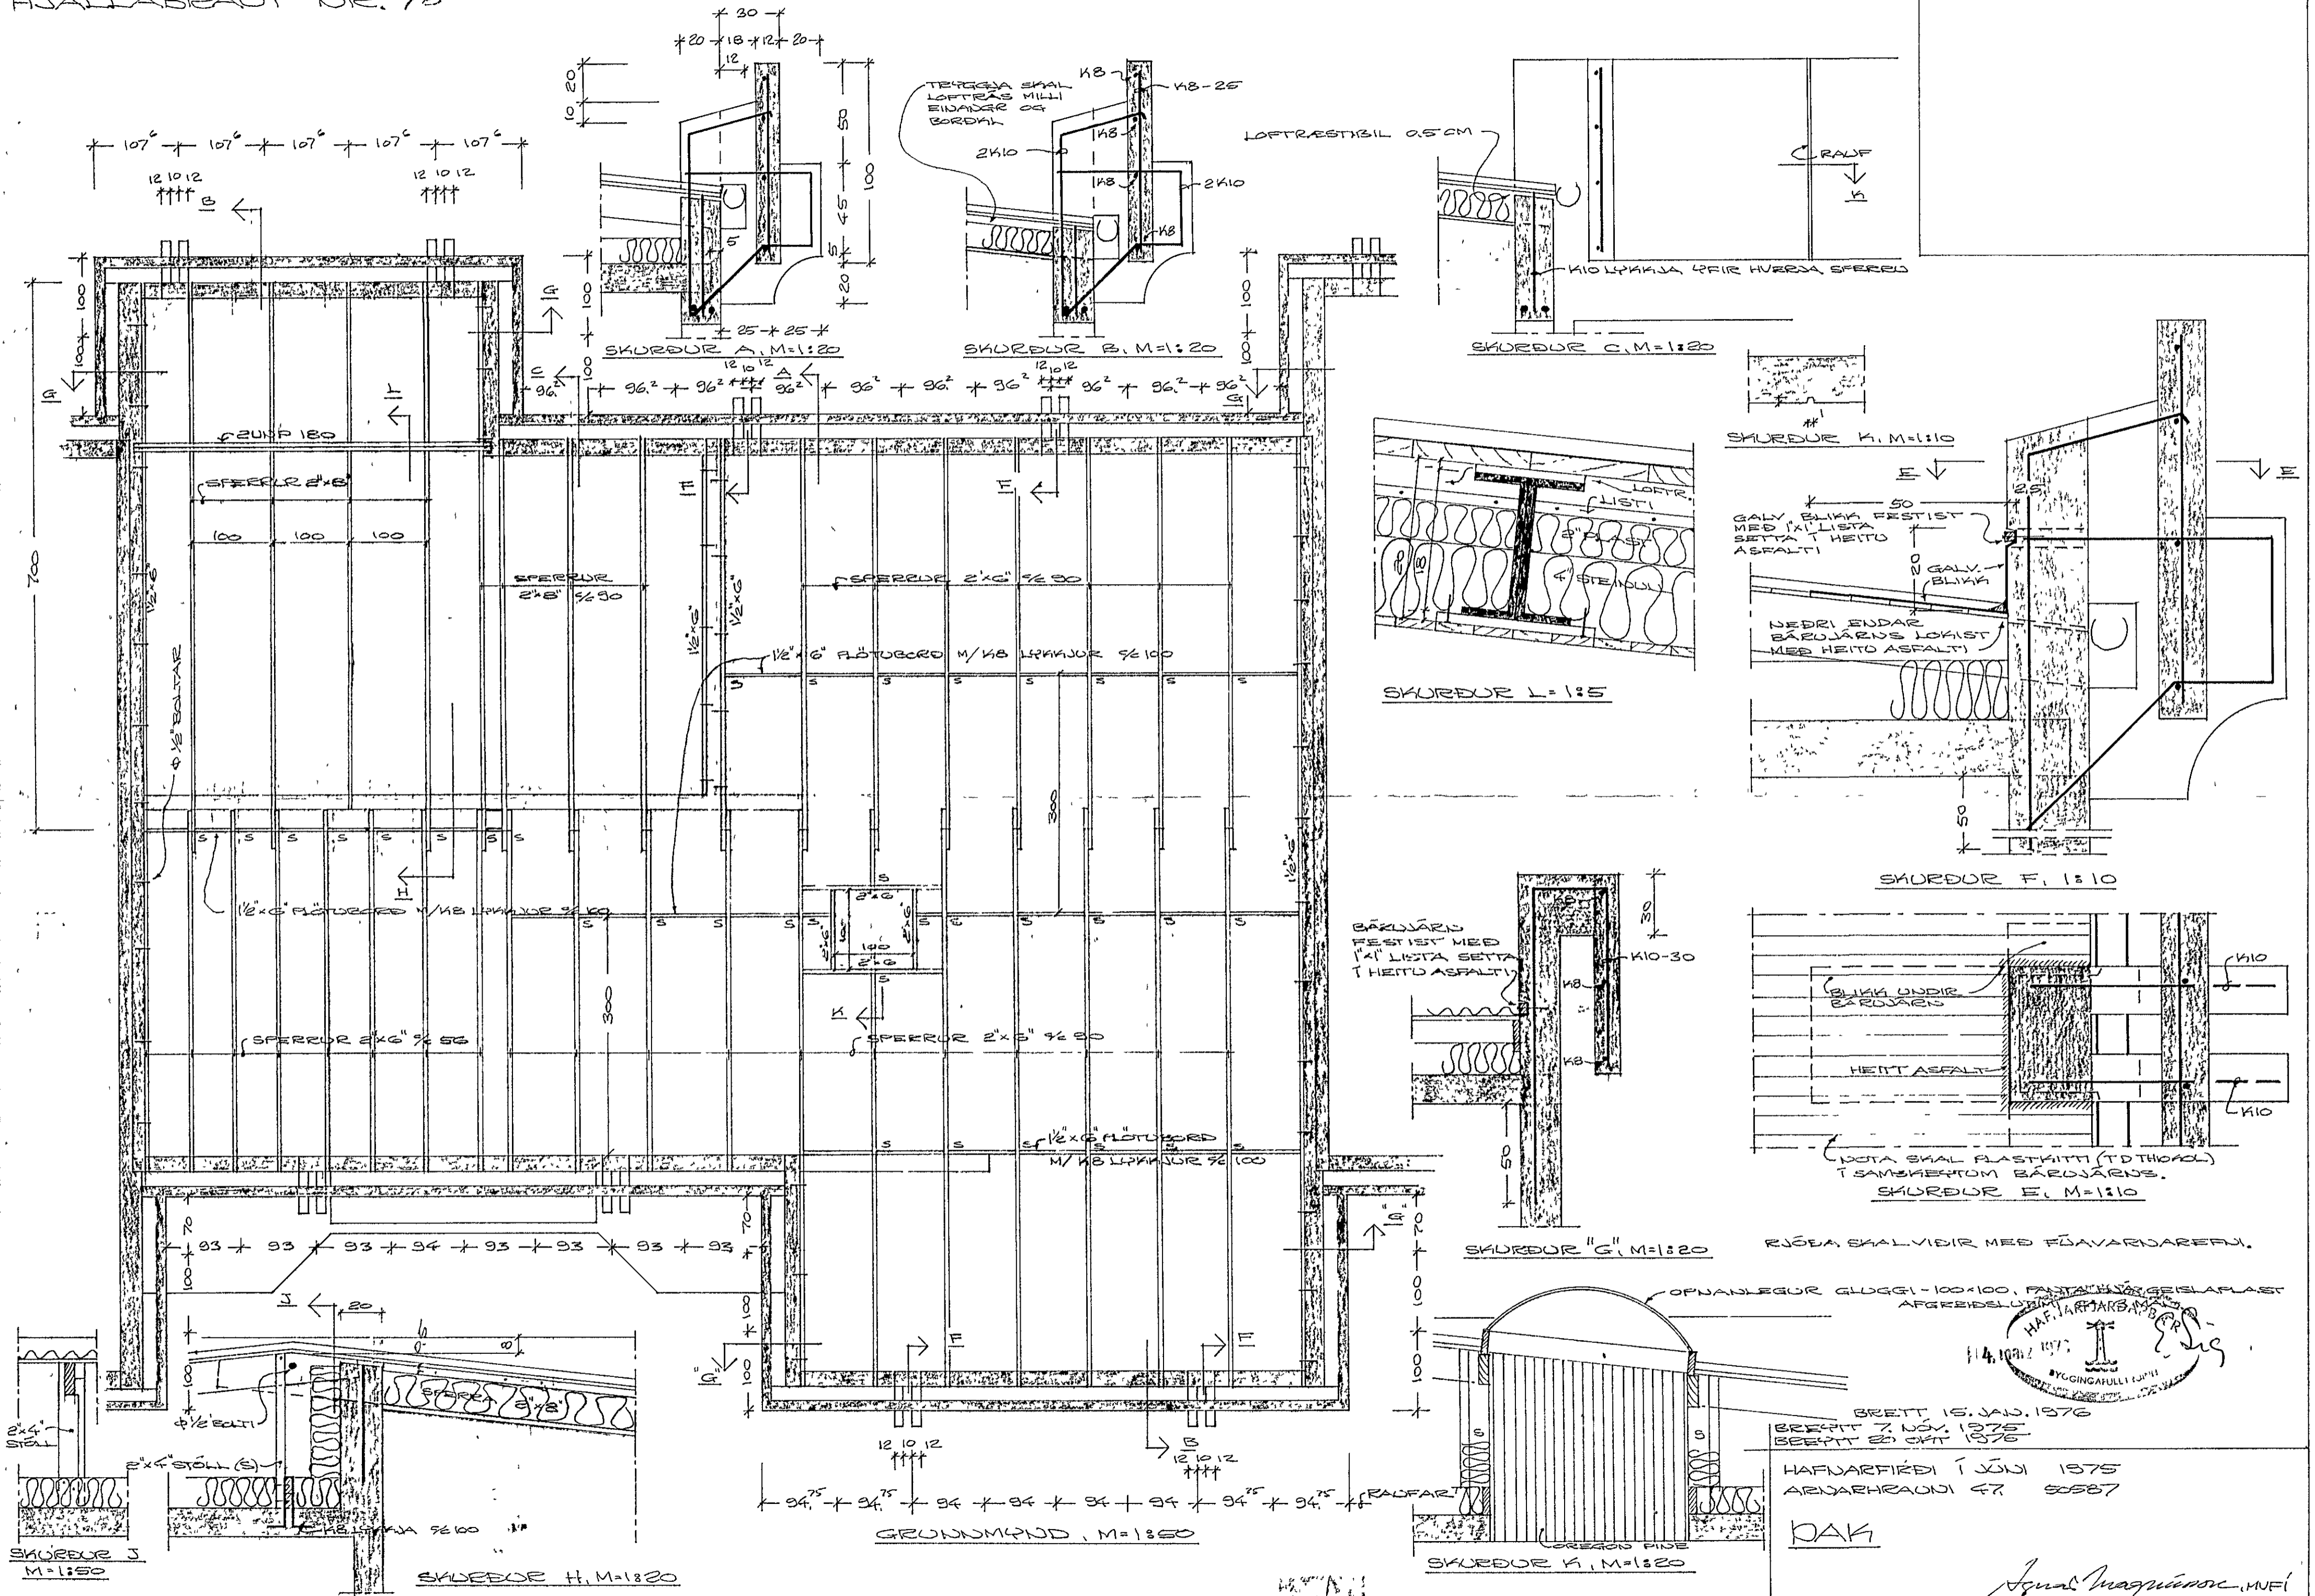

BRETT 15. JAN. 1976  
 BRETT 7. NOV. 1975  
 BRETT 20. OKT. 1976  
 HAFNARFIRÐI Í JÚNÍ 1975  
 ARNARHEAUNI 47 50587

DAK

*Sigurður Magnússon, MBEI*