

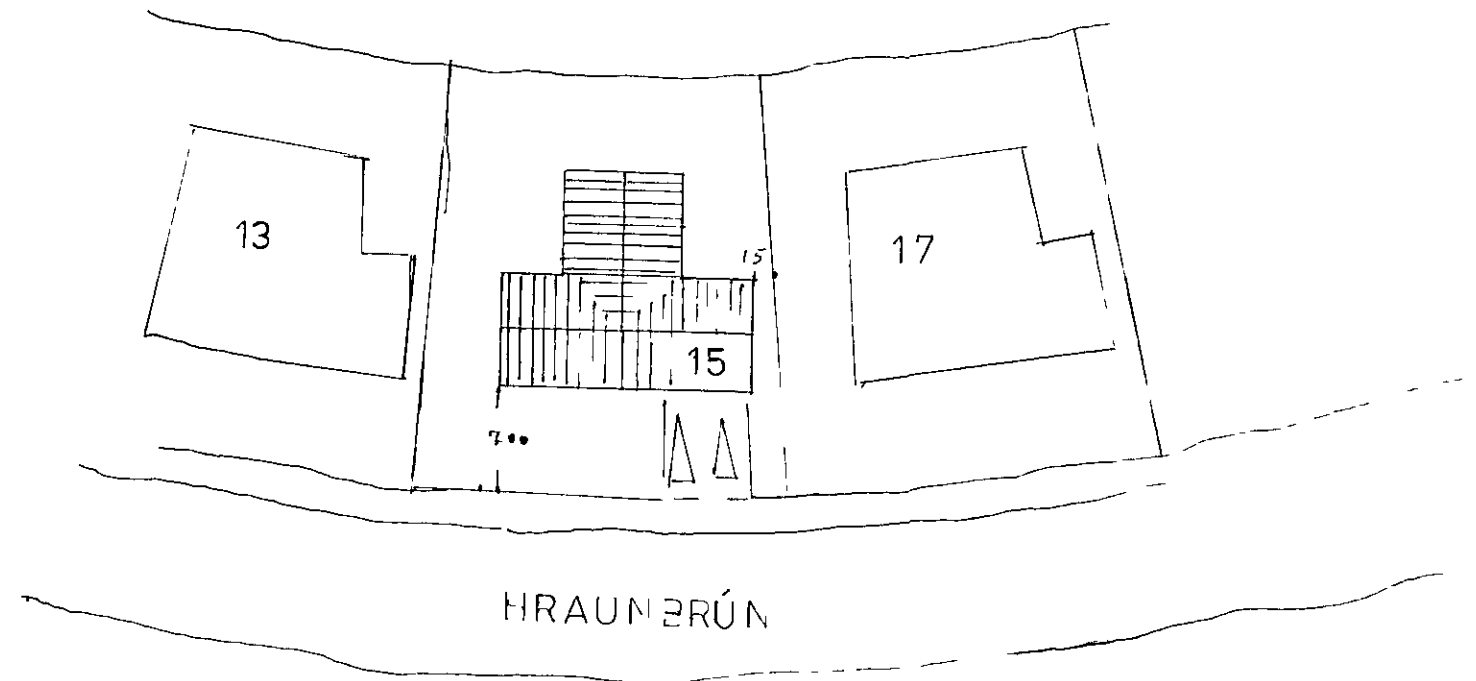


NEDRI HÆÐ:

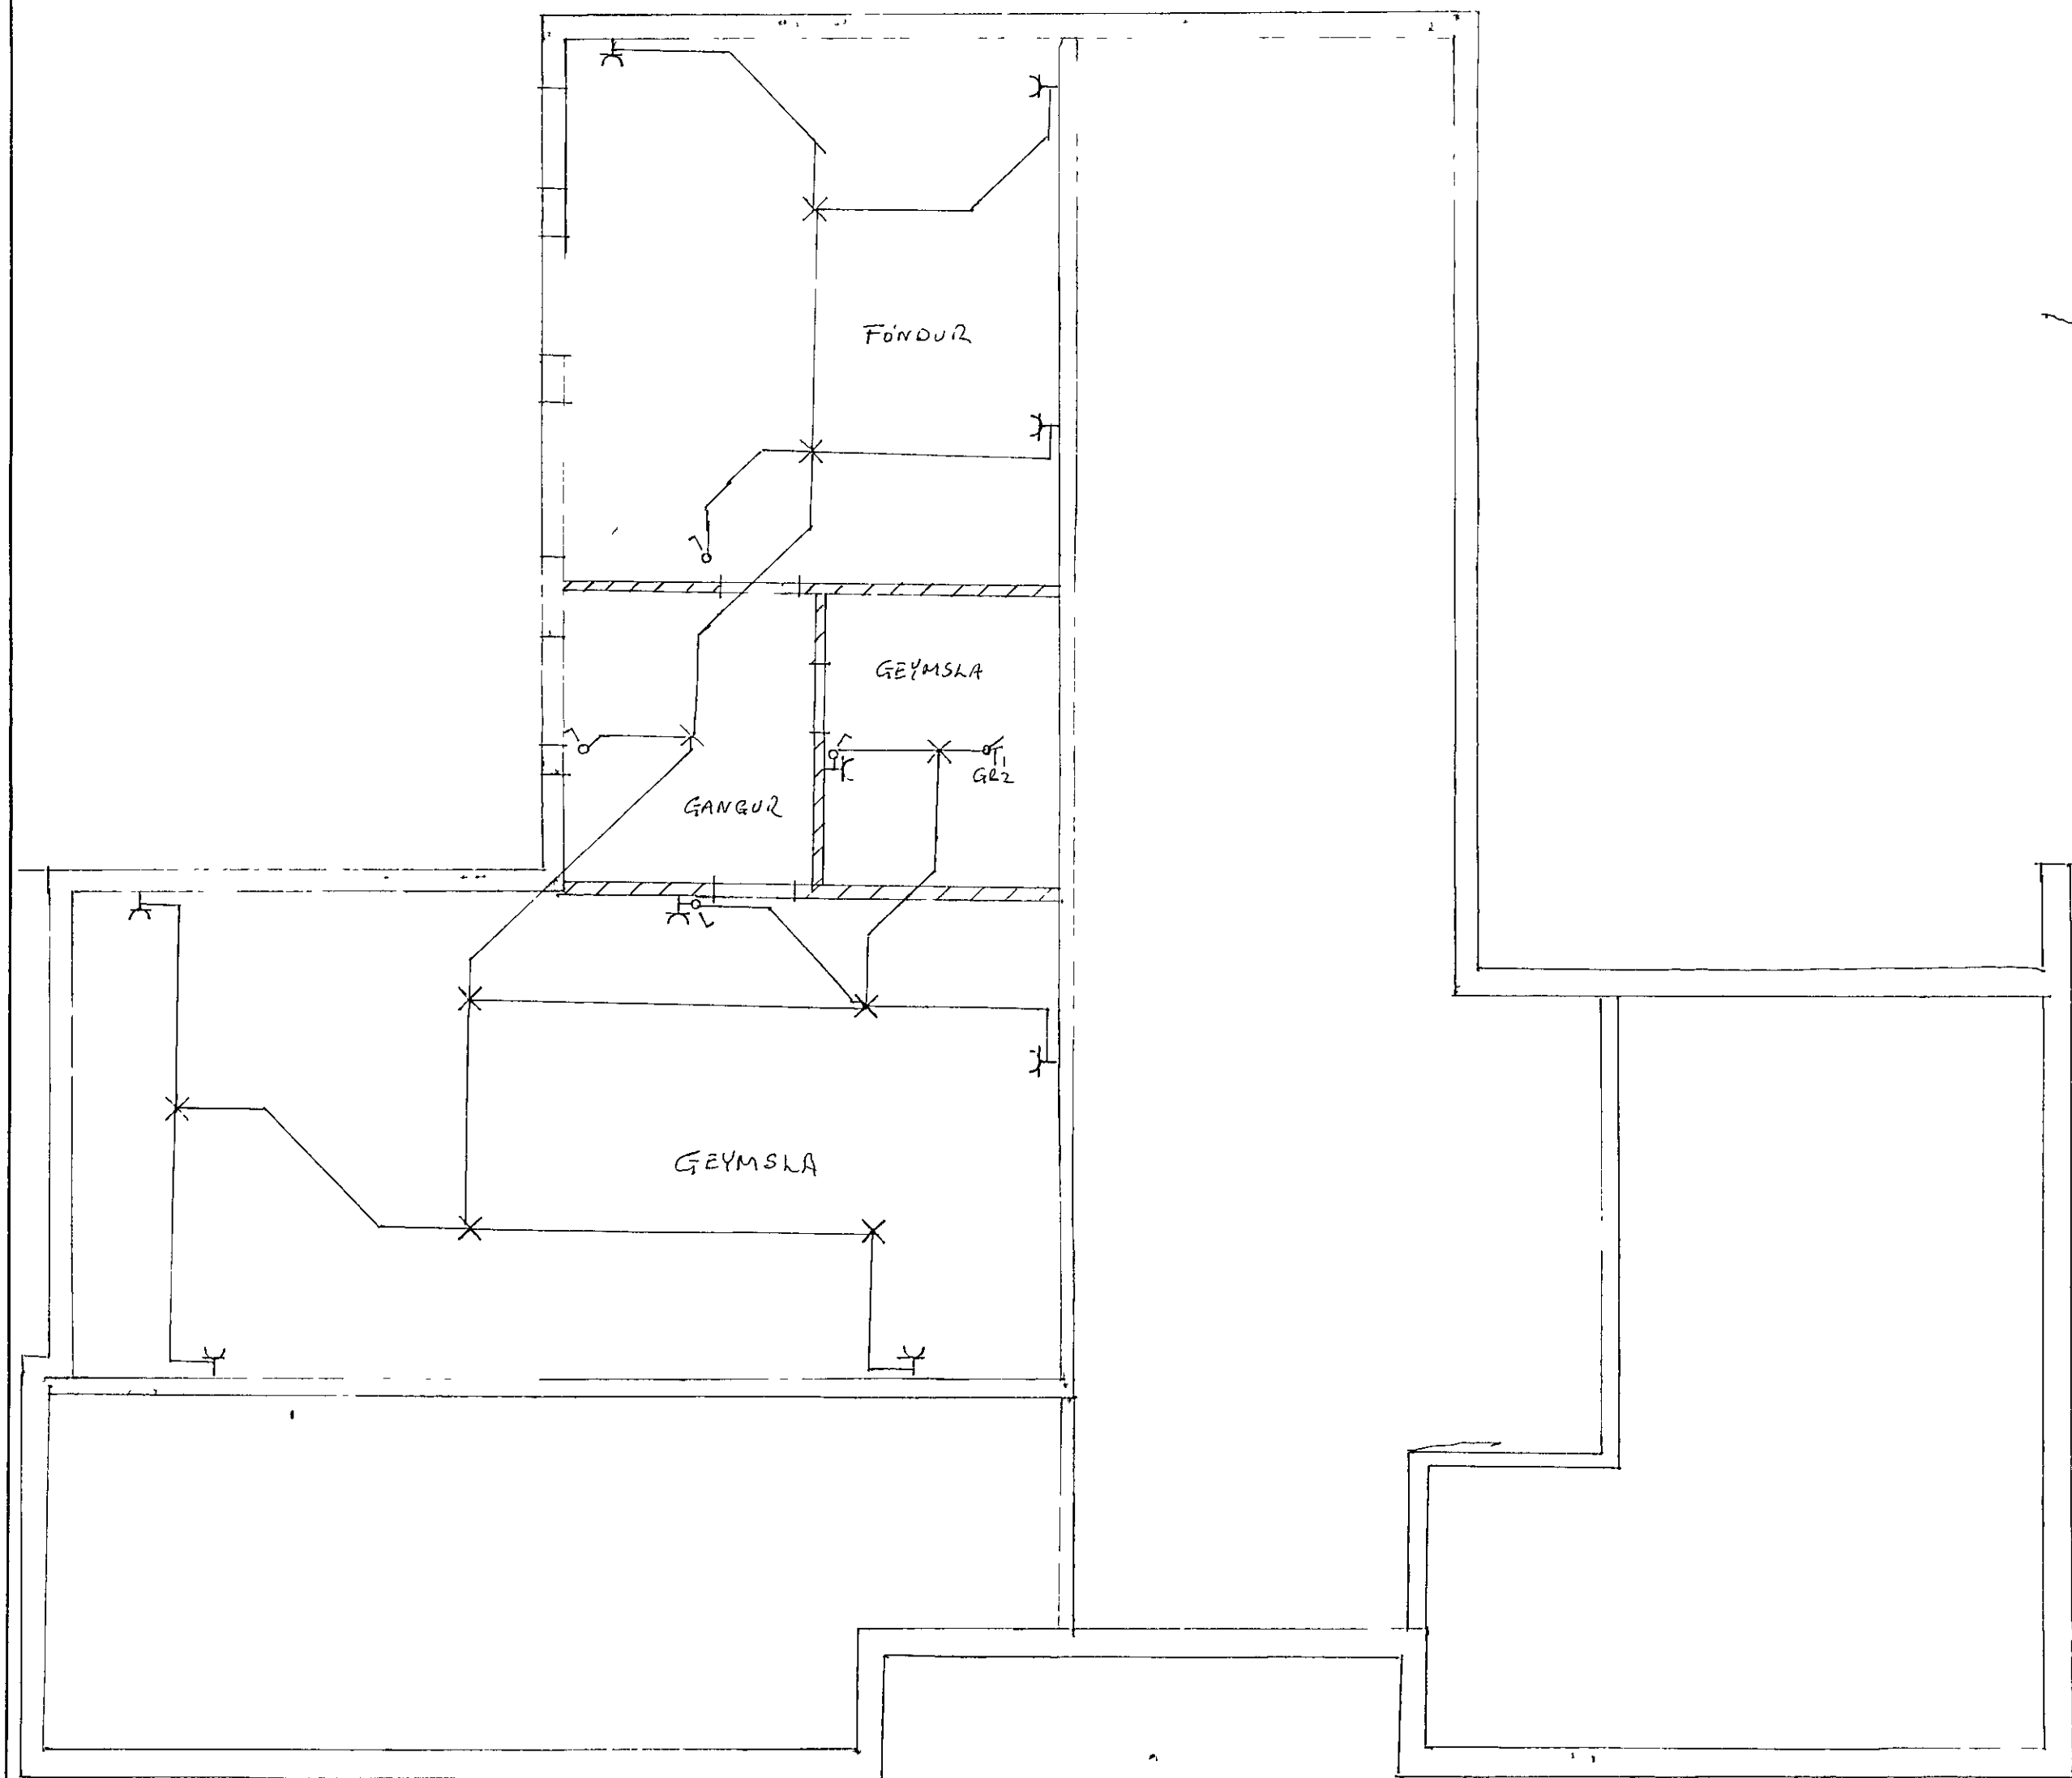

AFSTÖÐUMYND:

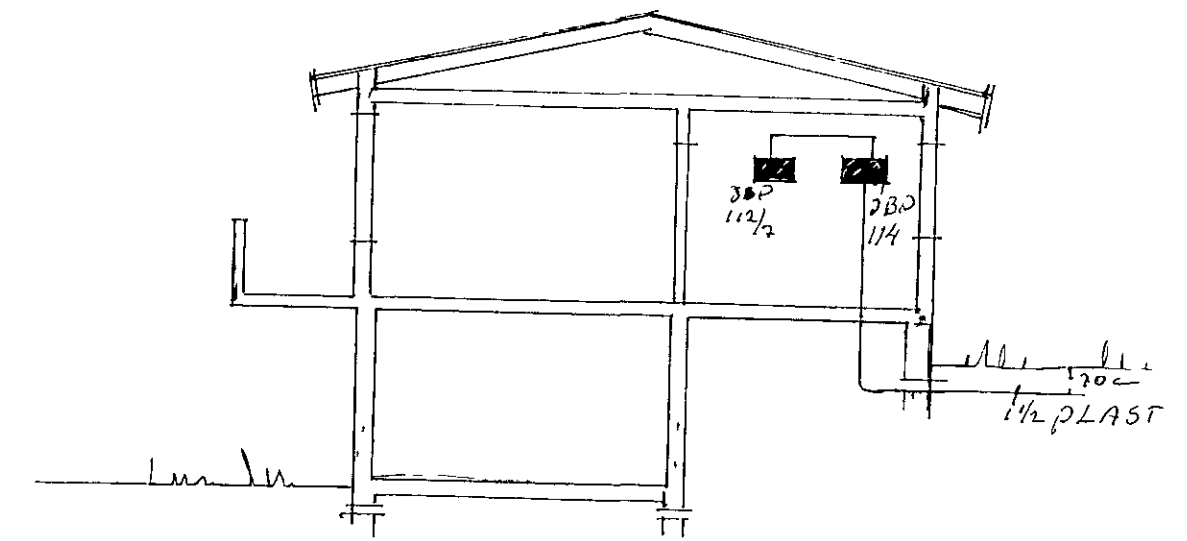

SNID:

HJÖRKEIFUR ÞÓRFARSON	
HRAUNBRUN 15 Hafnarfirði	
MAL	1 50 03 1 00 01 1 00
T. c	80 60
TEIKN	H 11
Bl.	2 1 5 0
RAFLAGNIR	
H B	