
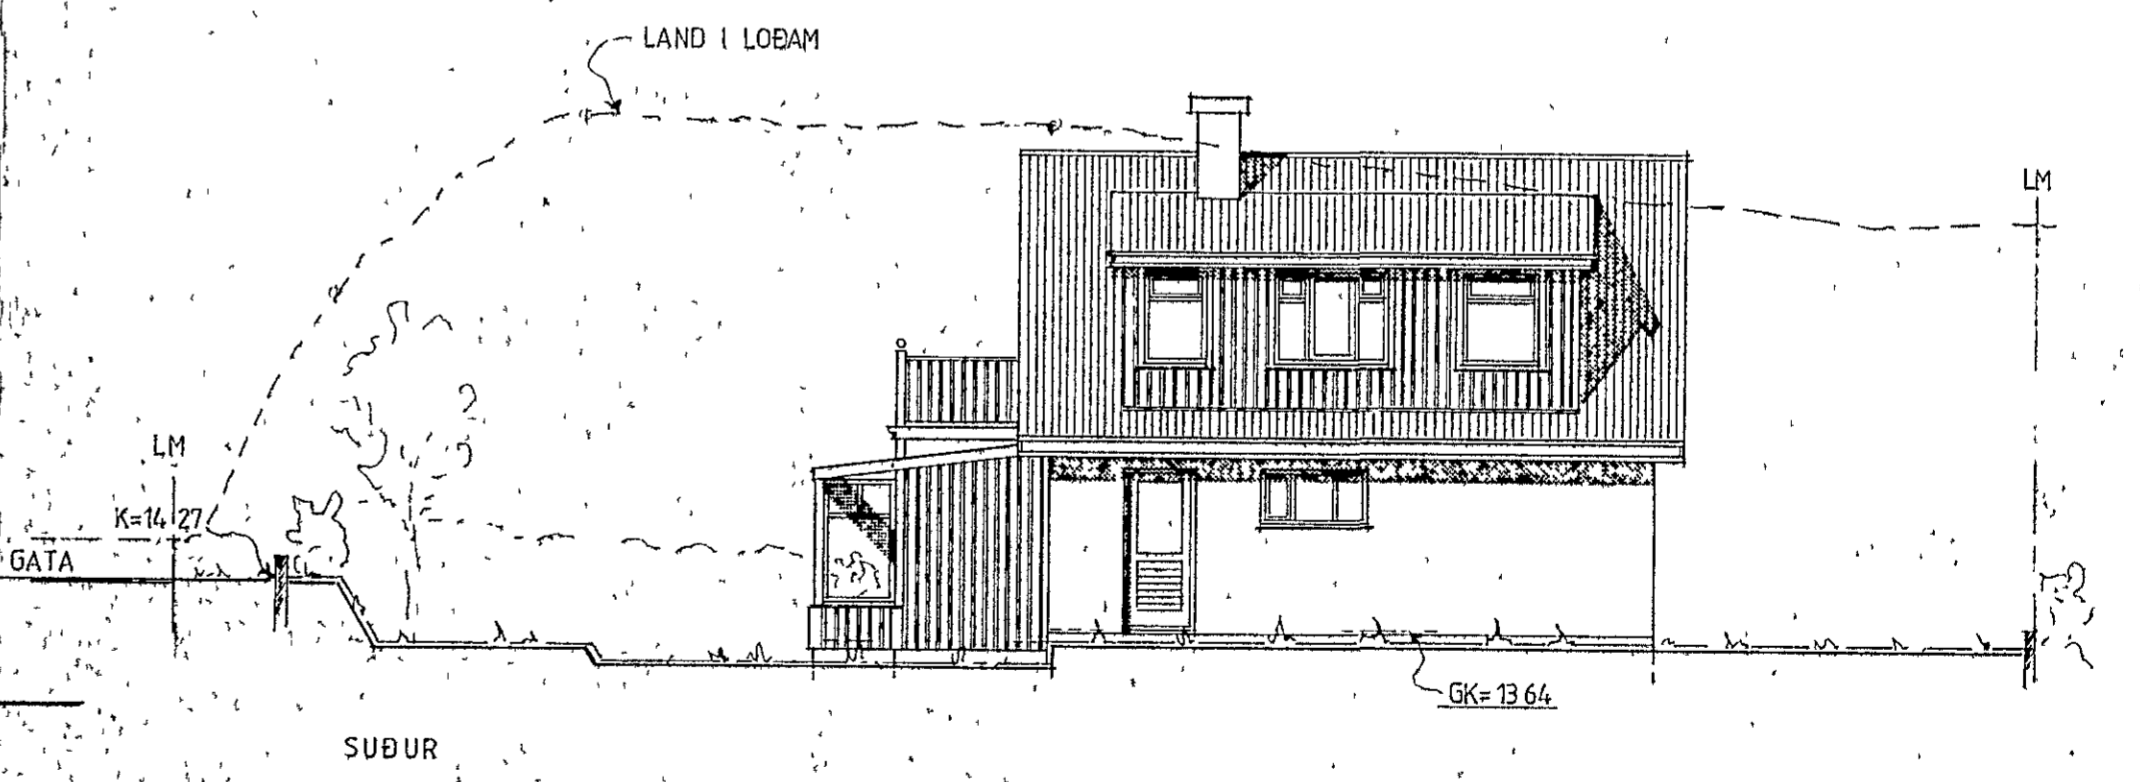
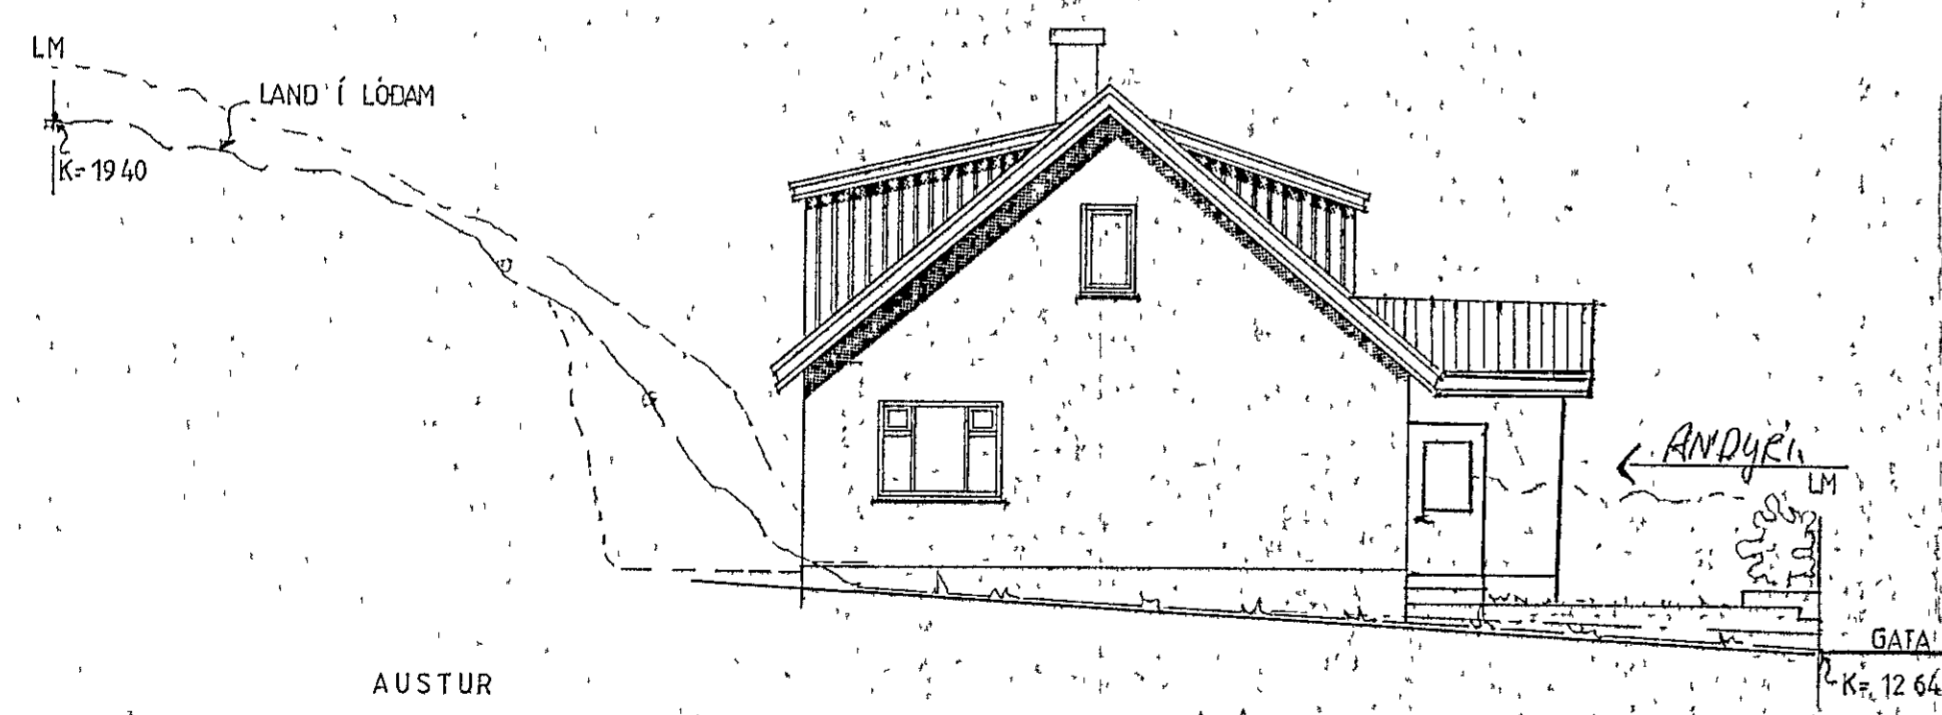
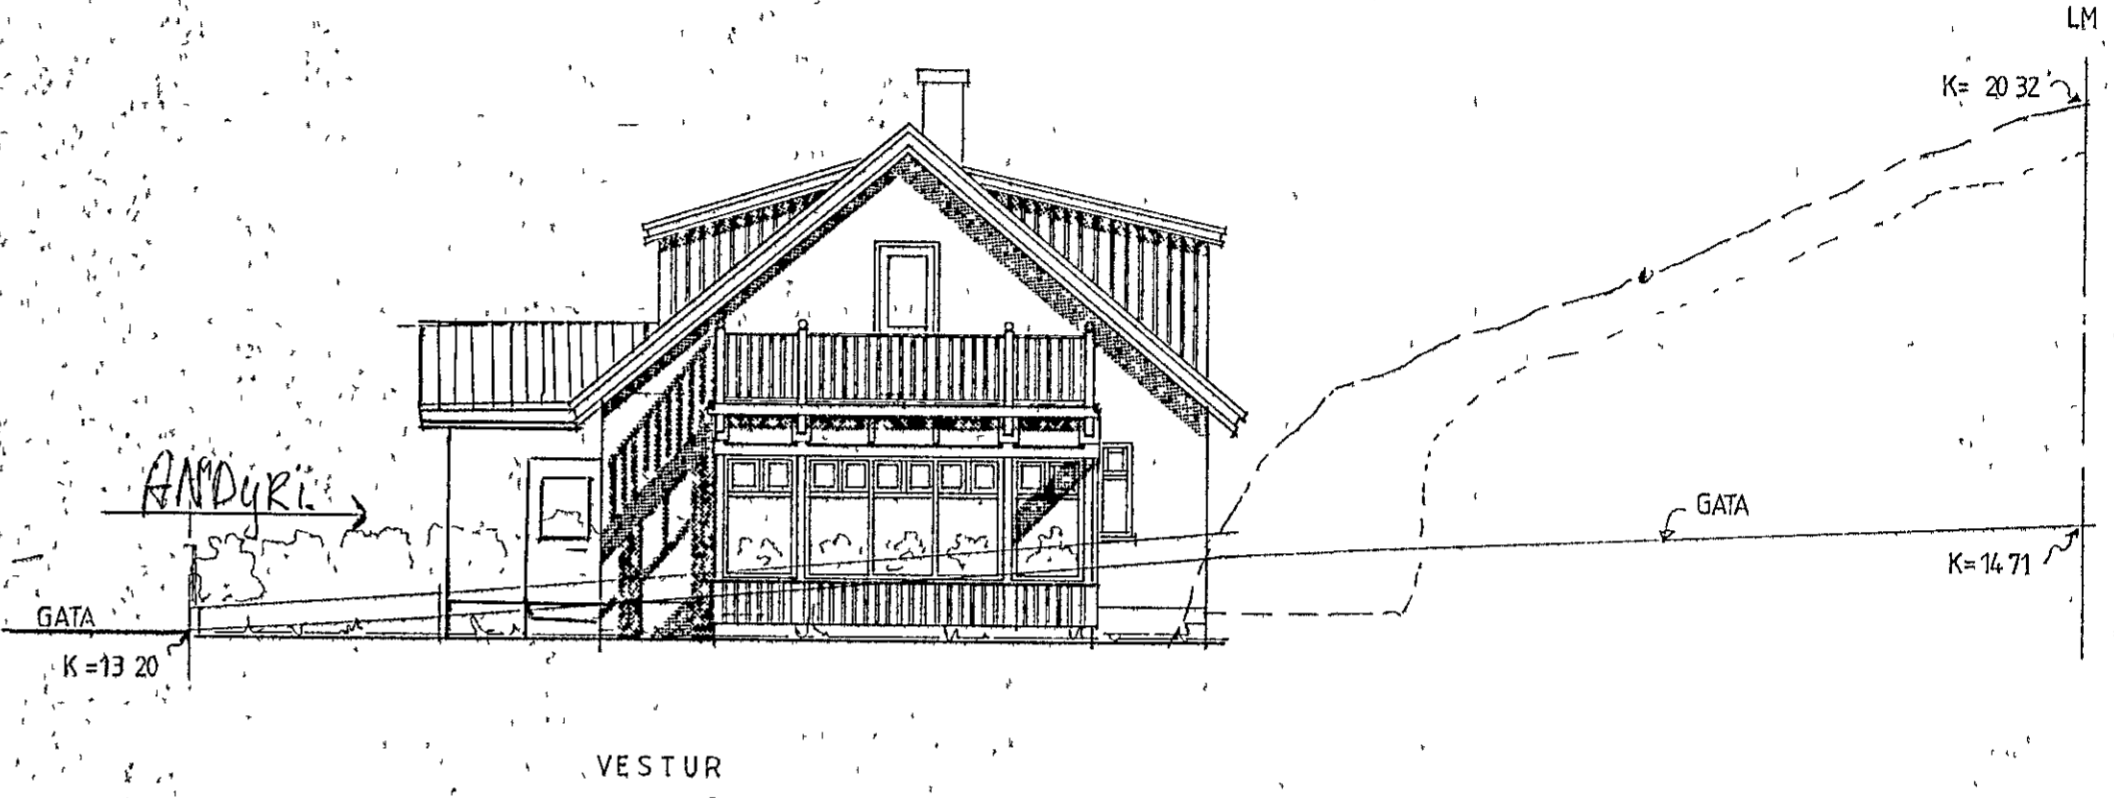


9/6 '85 Fullhúsdurk
 m/ástandingi b.t
 E

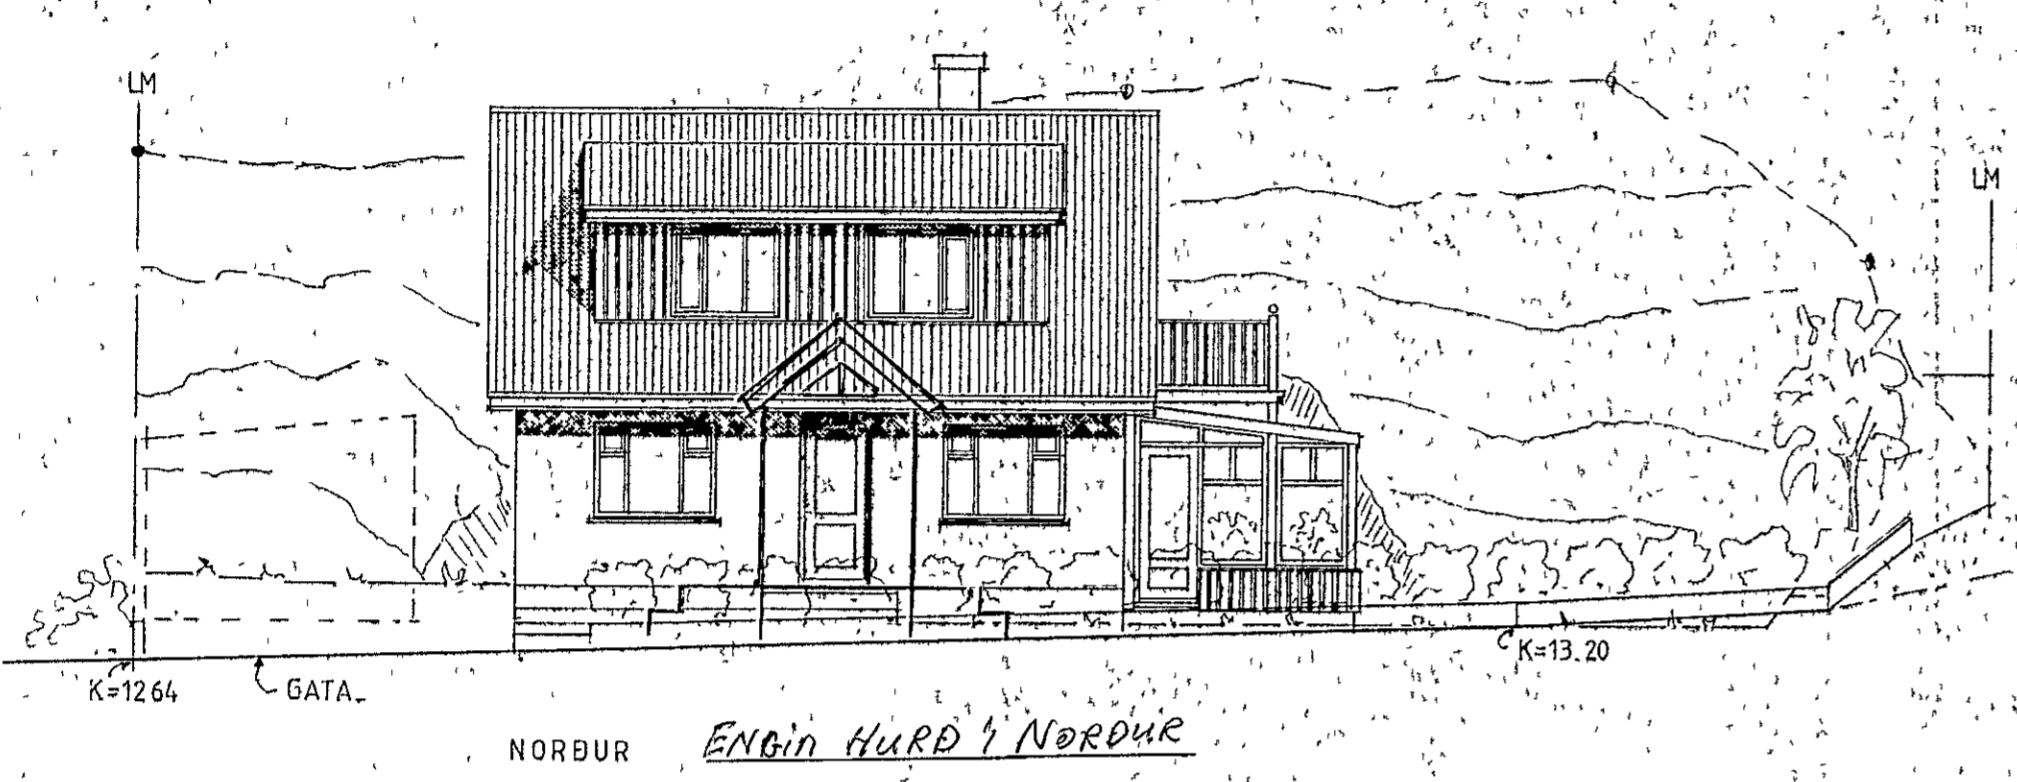

TEIKNISTOFA
 DALSHRAUN
 220 HAFNARFIORDI

Verkefni.	HRAUNBRÚN 26	Vark nr.	8824	Mælikv.	1100
	VIÐBYGGING, GARÐSKÁLI - SVÁLIR	Daga.	JÚNÍ '88	Teikn nr.	
	ÚTLIT	Teikn.	HELGA		T1 02

Stavil Sveinsson

HELGI K. PÁLSSON Innviðsarkitekt FHI sími (91) 522 35