


ARINN BENDIST I ÖRBRUN
 LARÖT LYKKJUR Ø 10 c 25
 AFINNBAK K 8 c 25
 LÖÐRÖTT K 8 c 20
 EINANGRUN 5 CM HRAUNSTEYPUPLÖTUR

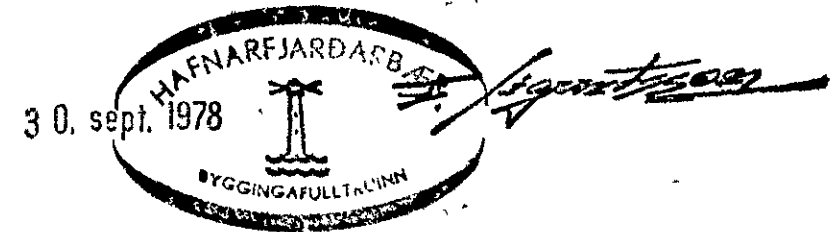

- SKYRINGAR:**
 SJA SKYRINGAR A BL.10
 HLÖFUD. 16 CM
 BÍLSKUR 18 CM

BRÖYTT I SEPT. 1978 *s. v. s. for l. s.*

SPRINGRIMUR TH. ÞORLEIFSSON MTTI		
HRAUNBRUN NR. 29 HAFNARFIRÐI		
MÁL.	1:50	JARNBENT SPEINSTEYLA LÖTFLATA HADAL GRUNNMYND OG SMÍÐ
DAGS.	DES. 1978	
BLAD	11	