


Skýringar

Undirstöður standi á klöpp eða þjappaðri grús $\sigma_j \leq 3.9 \text{ t/m}^2$
 Öll steypa skal vera S200 sigmál 7-10
 Alla steypu skal titra
 Kambstál skal vera ks40
 Neðri sökkuljárn skal tengja saman sem sökkulskaut
 Öll mál eru cm, nema steypujárna
 Yfirlog steypu í sökkli skal vera 2.5cm

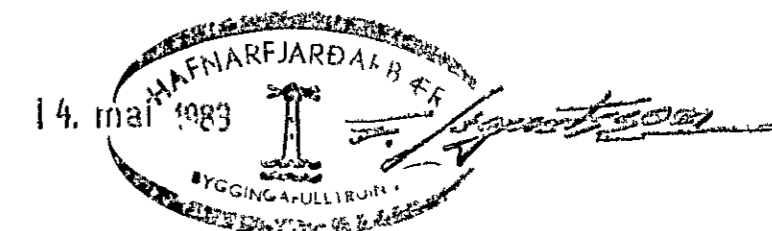

Breytt málum 29-4-83 EÞ

Teikn	101-1			
HRAUNBRÚN 39	maí '83	ES		
Undirstöður				1:50 1:20
Einar Sigurðsson MTFI	s. 52941	ES		