



Árþykt á fundi
síndar þ. 26.2.64
BYGGINGAFUR UNN
HAFNARFIRÐI


Jón Benzon

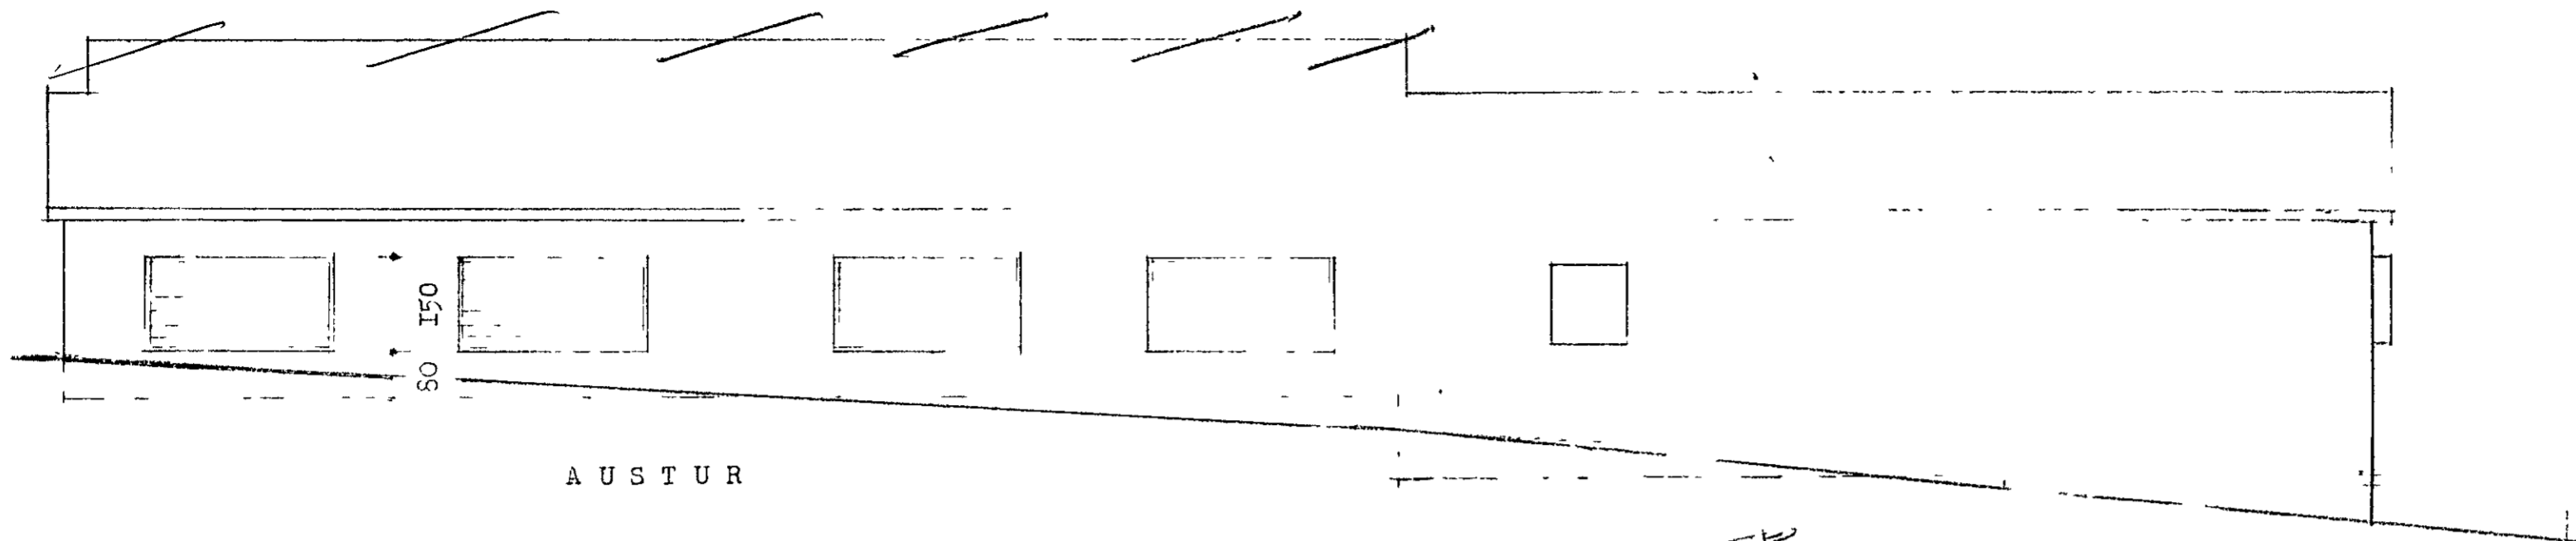


AUSTUR

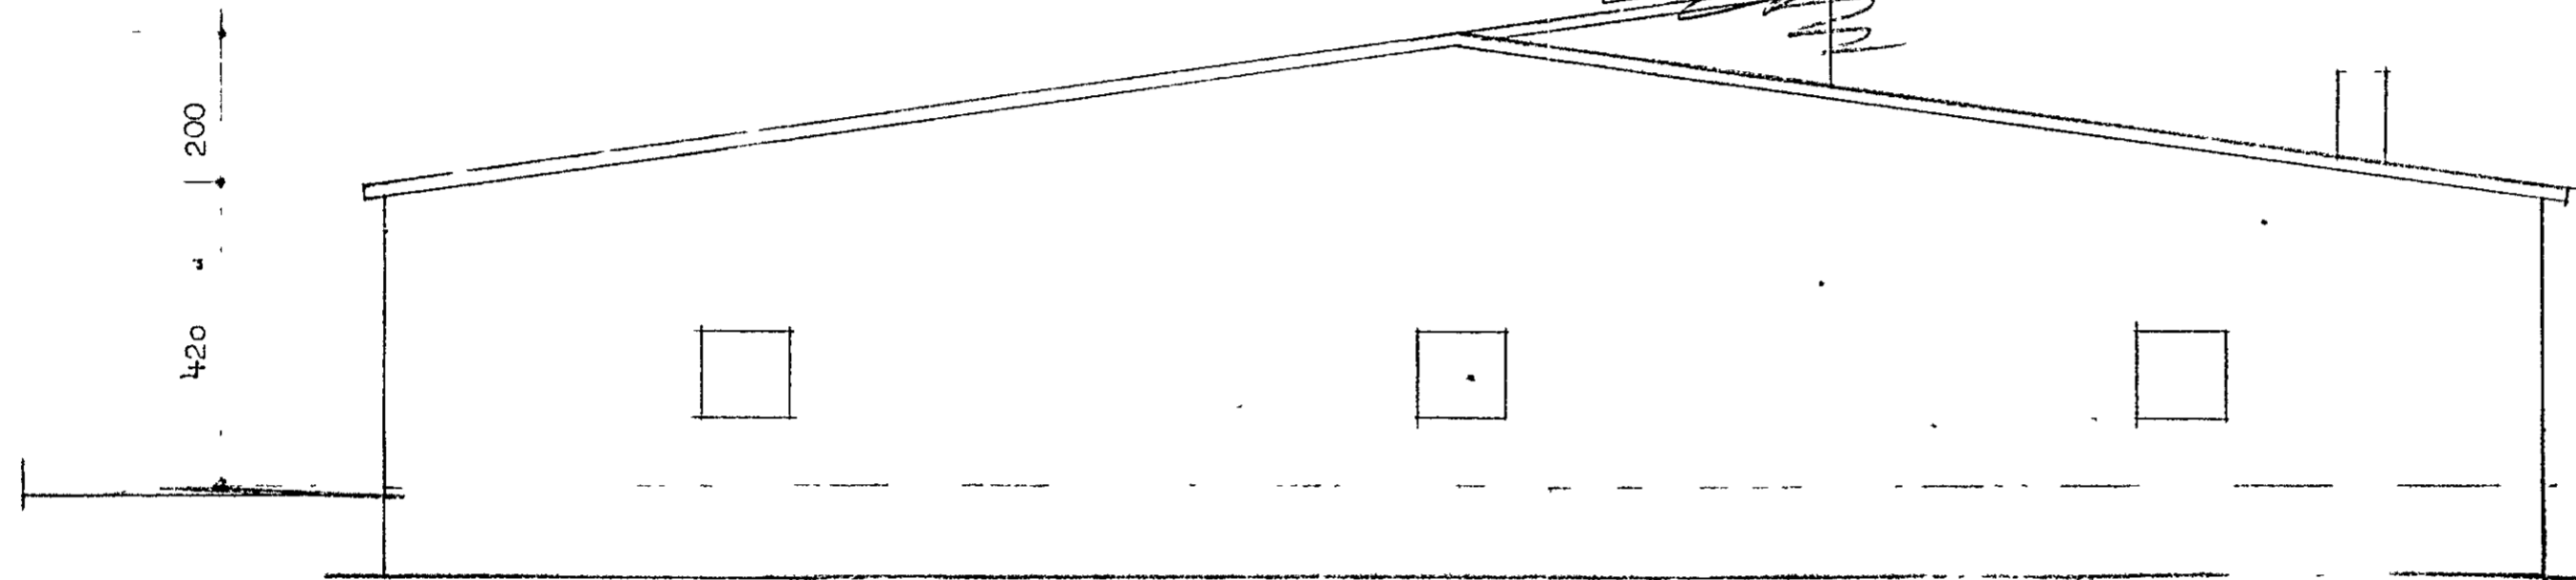

NORDUR

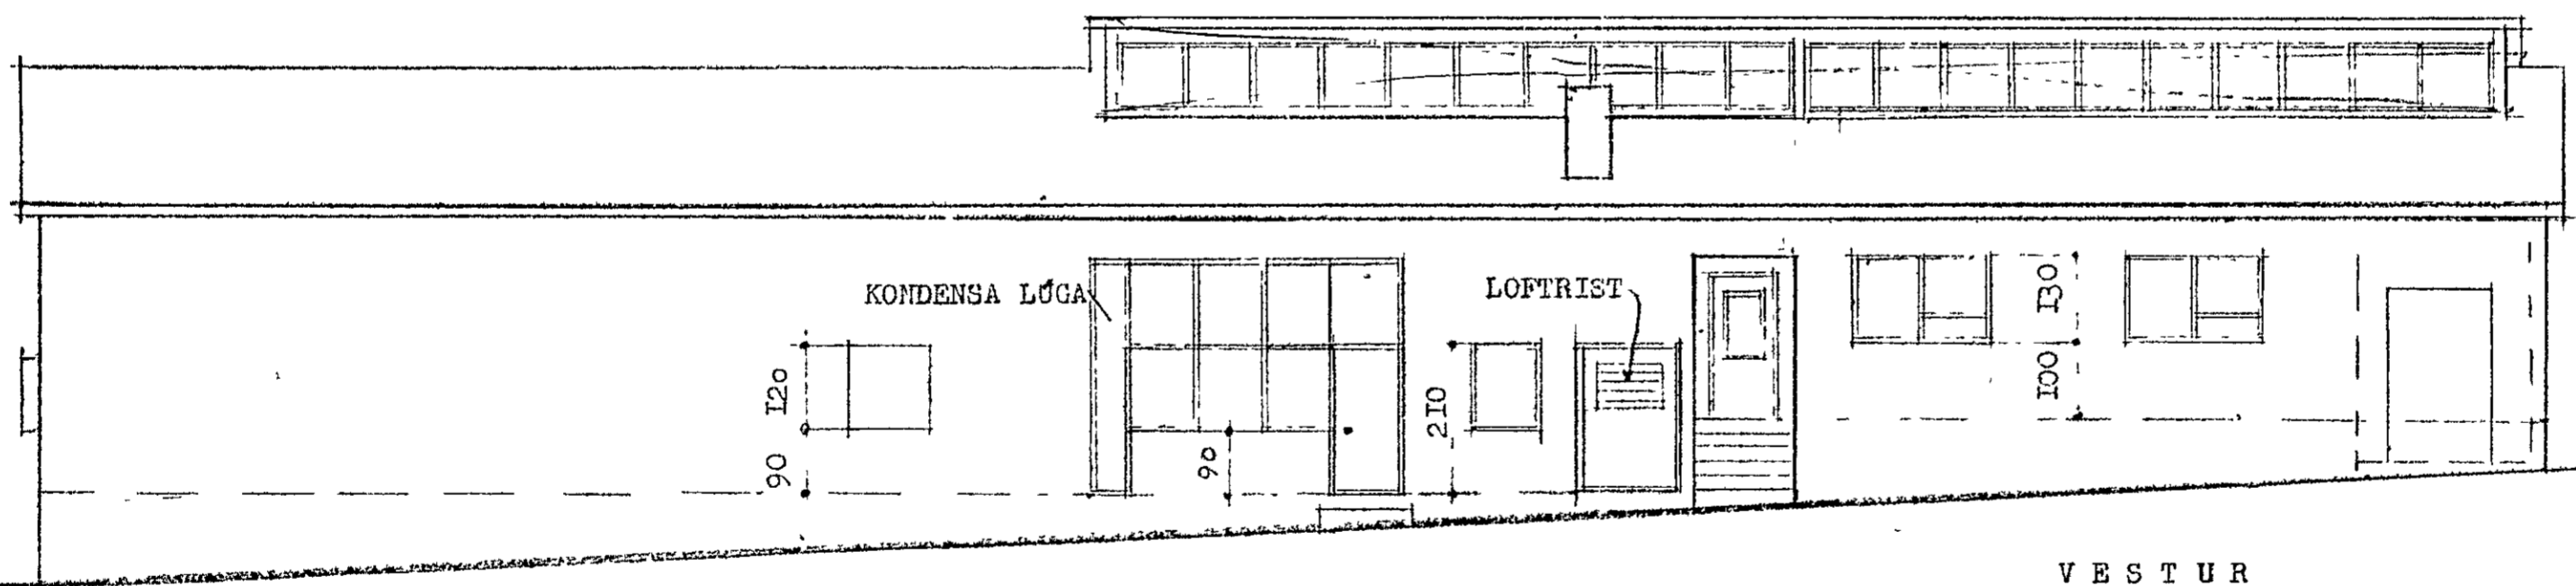

VESTUR

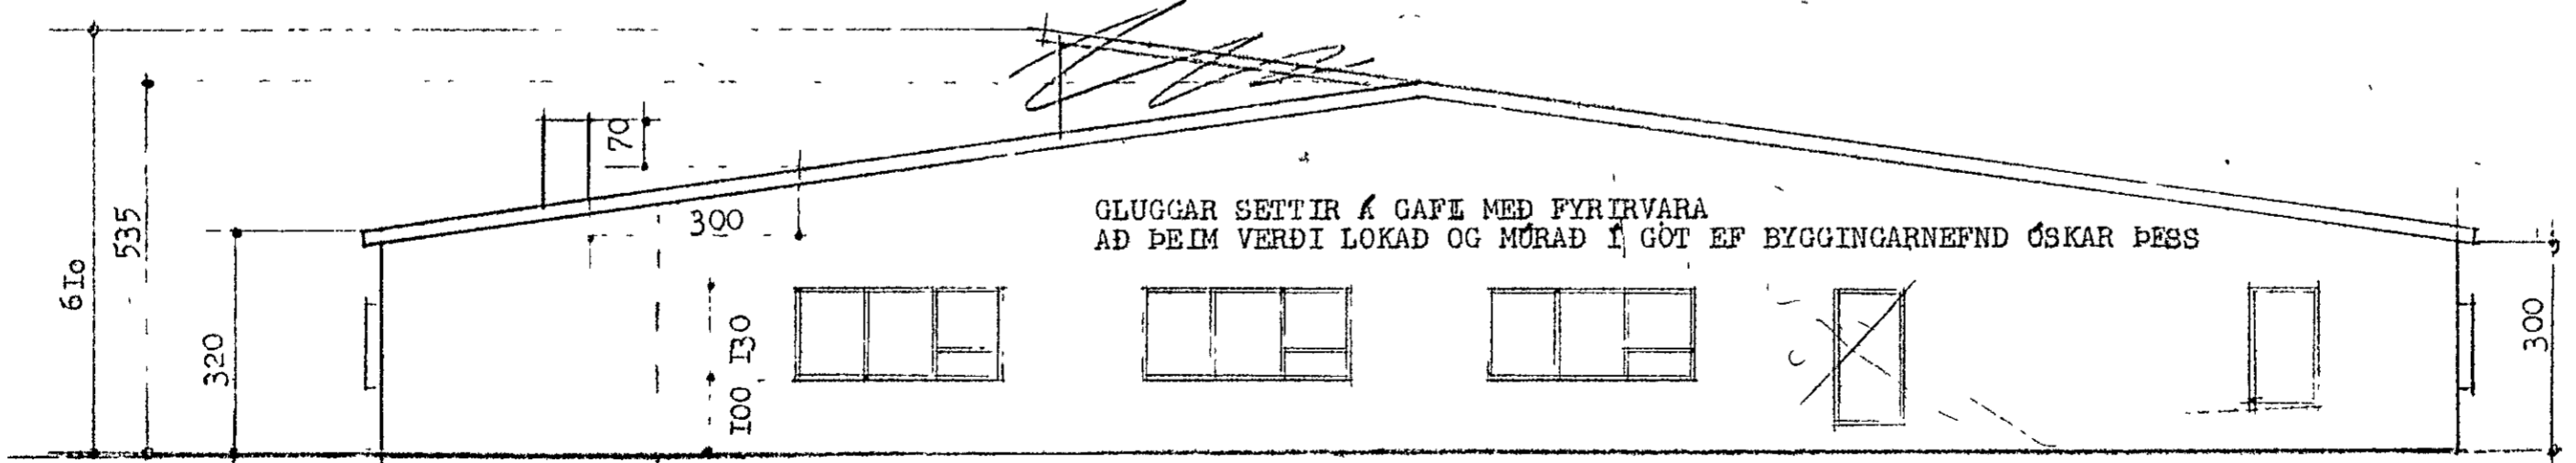

SUDUR

Húsnámsmeistari

Guðni Þorbjörgsson

Múrarameistari

Guðni Steingrímsson

Paplagningarni

BREYTT FEBR 64

TEIKNISTOFA
RÖGNV. JOHNSEN
SÍMI 35370
REYKJAVÍK Í MARZ 1963

RÖGNV. JOHNSEN