


Samþykkt á fundi bygginga-
nefndar þ. 12.6.1978
BYGGINGAFULLTRÚÐIN
Í HAFNARÉIRDI

*Samb. nr. 27/77
Jónin in síðli*

Öllum byggisryfum
skal fullnast.

or samb. nr.
Hafnaréirar

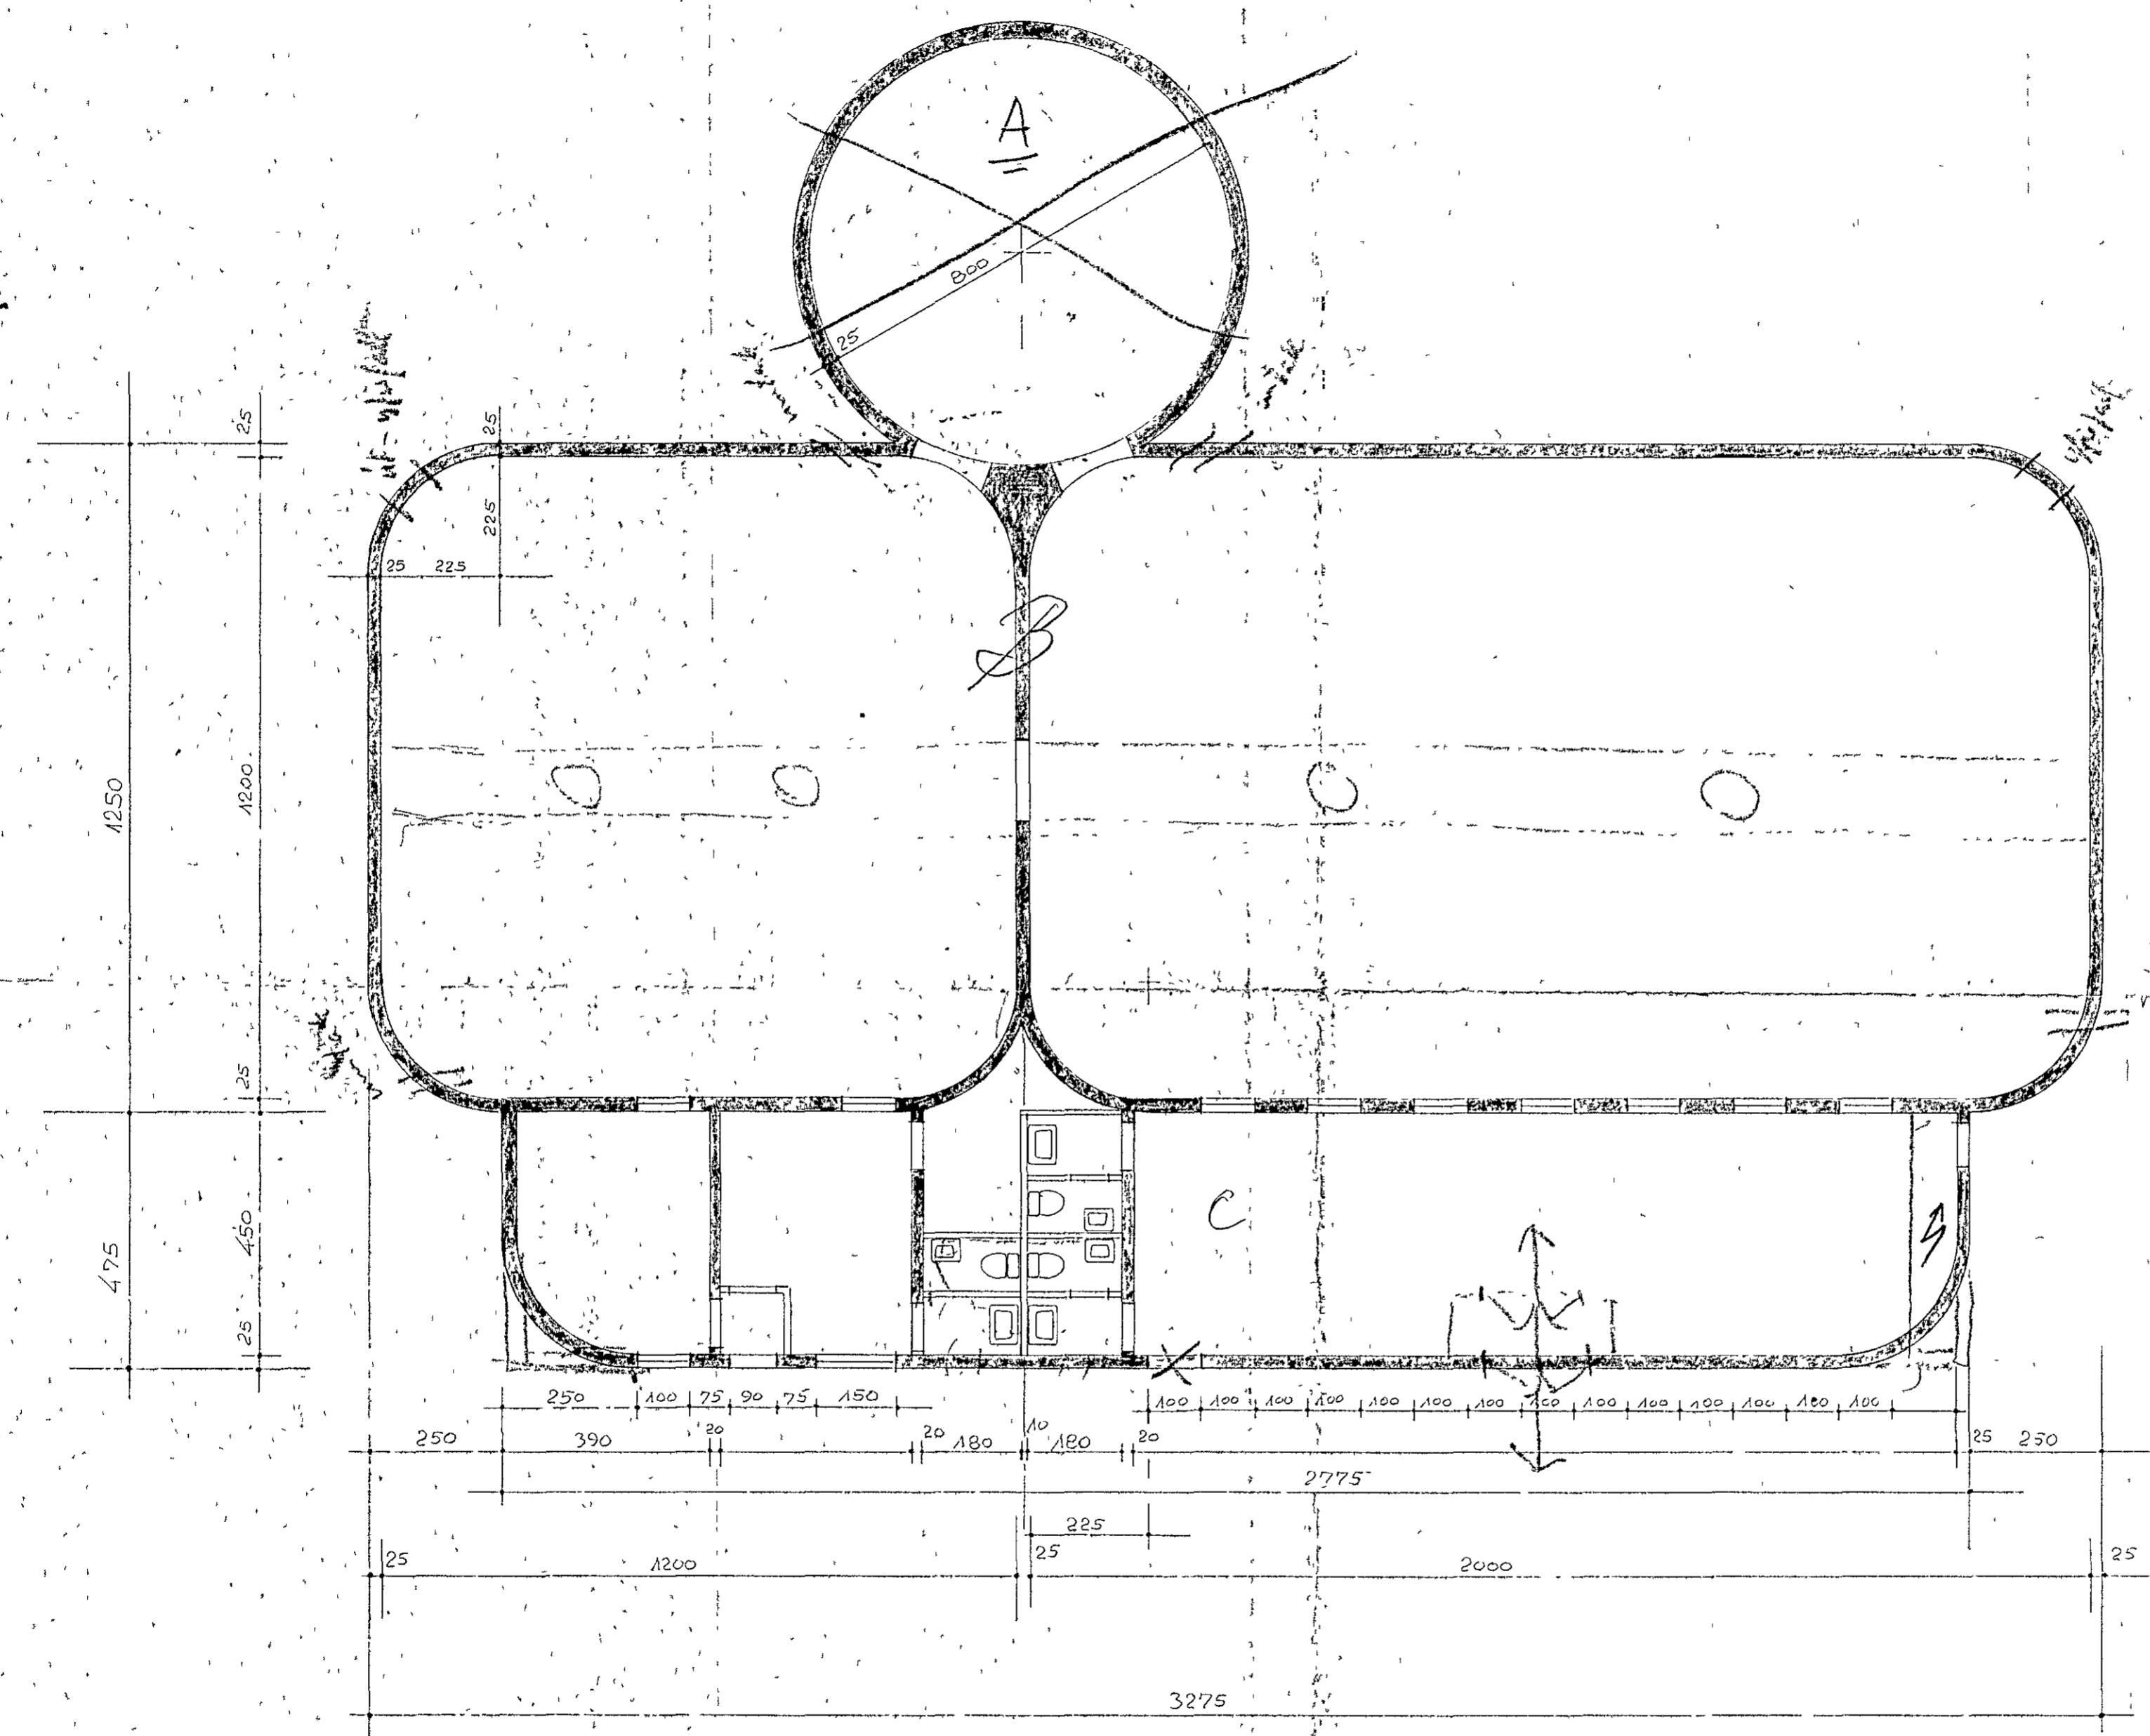

$$A = 4,25^2 \times \pi = 56,7 \text{ m}^2 \times 4,8 = 272 \text{ m}^3$$

$$B = 32,75 \times 12,50 = 409,37$$

$$\div 1,25 \times 8 = 108,398 \text{ m} \times 5 = 1997,9 \text{ m}^2$$

$$C = 27,75 \times 4,75 = 131,8 \text{ m}^2 \times 3,2 = 422 \text{ m}^2$$

$$= 587 \text{ m}^2, 2689 \text{ m}^3$$

$$520,7 \quad 2415 \text{ m}^2$$

DAGS	BREYTING	GJORT
HANNAÐ J	JÓN BERGSSON DIPL. ING.	VERKFR. MVFI
TEIKNAD J	SÆDÝRASAFNIÐ	VERK
YFIRFARID J	HVALALAUG GRUNNMYND	
SAMÞYKKT	M=1:100	DAGS Marz '78