



SNID B 1:10



SNID A 1:10

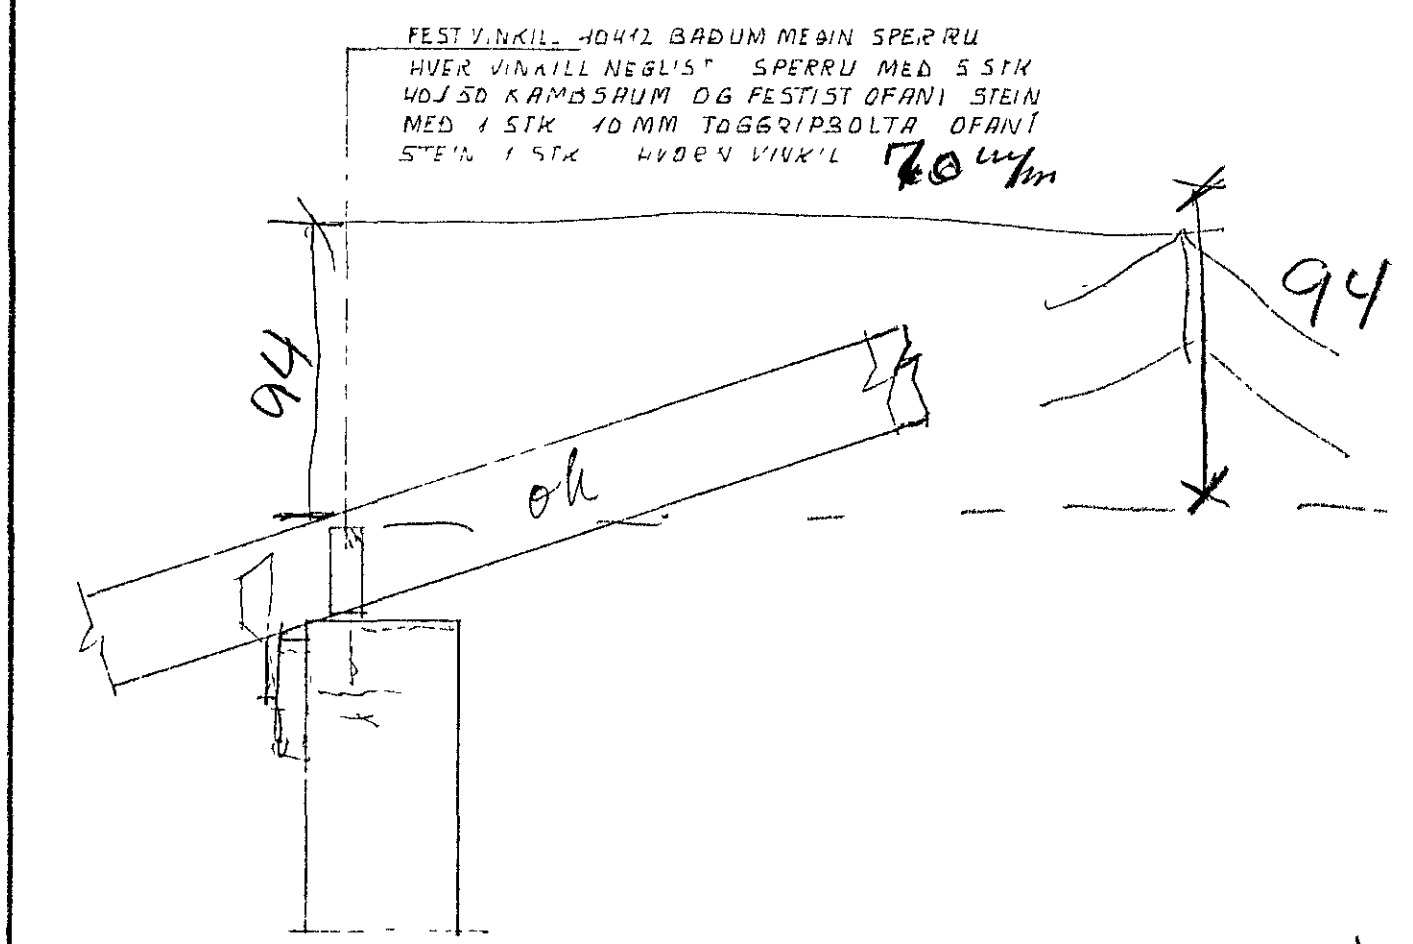

SNID G 1:10

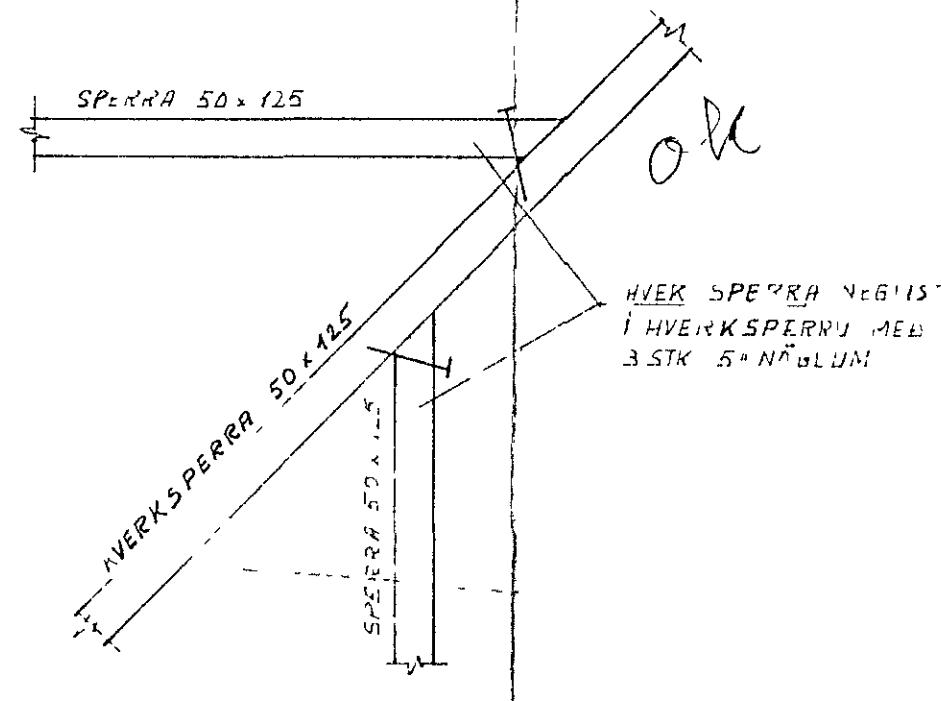

DEILI E 1:10

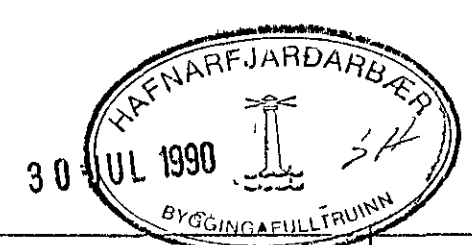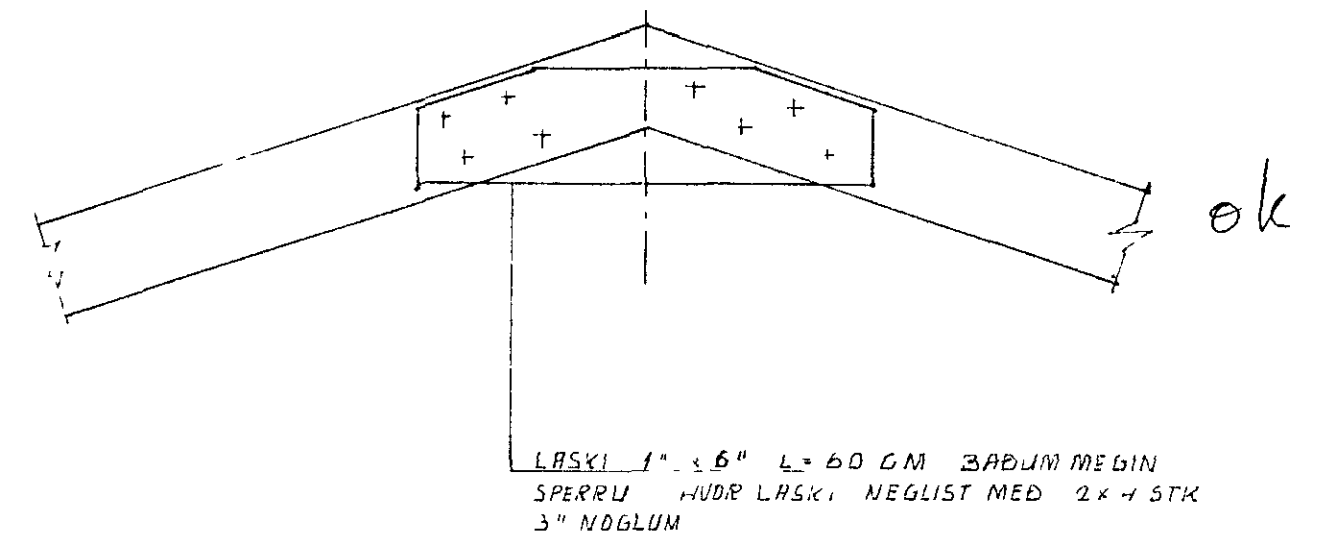

BR NR	DAGS	EDLI BREVINGAR	SIGN
			DAGS JÚN 90
KLETTAHRÁUN 9 HAFNARFIRÐI			HANNAÐ
SÉRMYNDIR I PAKI			TEIKNAD SD G
MÆLIKV 1:50			VERK NR
SIGURÐUR ÞORLEIFSSON TEKNIFRÆÐINGUR F.T.T.I			BLAD NR
STRANDGÖTU 11 HAFNARFIRÐI SIMI 54751			