


JÄRNBENDING GLUGGARARMA
SJA TEIKN NR 1.5

BITI B11
TEIKN 1.5

A1
SJA TEIKN NR 1.5

GRUNNMYND — HÆÐAR 1:50

BREYTING
SLEPPT PLOTU YFIR STOFU

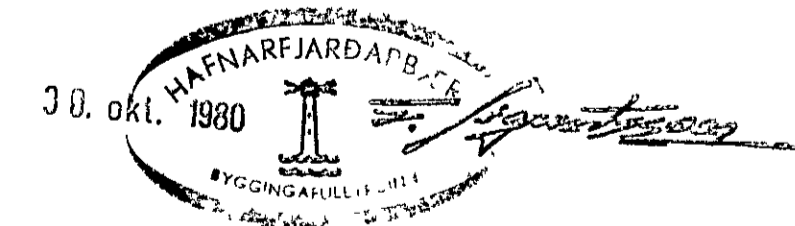

SKÝRINGAR SJA TEIKN NR 10

HÚS A

KLAUSTURHVAMMUR 1	MÆLIKVARDI 1 50	VERK 800 1	TEIKN NR 1.4
PLATA YFIR 1 HÆÐ	Hanna Sk. Teiknað	Yfirfarir Samp	DAGS MÁI '80
JÓHANN GUNNAR BERGPÓRSSON STRANDGÖTU 11 — HAFNARFIRDI — SÍMI 53315	BREYTT OKT '80		