


A1
SJÁ TEIKN NR 1.5

GRUNNMYND — HÆÐAR 1:50

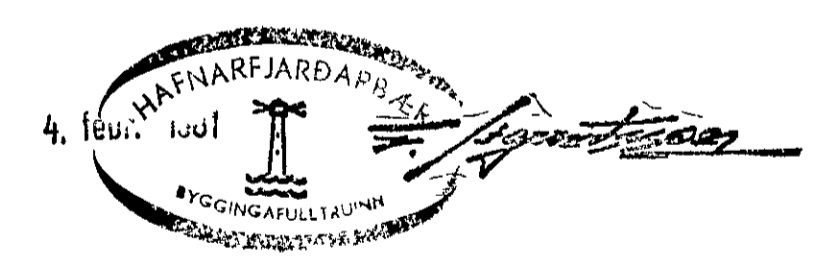

BREYTING
SLEPPT PLOTU YFIR STOFU

SKÝRINGAR SJÁ TEIKN NR 1.0

HÚS A

KLAUSTURHVAMMUR 3	MÆLIKVARÐI 1 50	VERK 800 1	TEIKN NR 14.
PLATA · YFIR 1 HÆÐ	Hanna Teiknað	Ylirfar Samb	DAGS MÁÍ '80
JÓHANN GUNNAR BERGPÓRSSON VERKFR MVFI STRANDGÖTU 11 — HAFNARFIRÐI — SÍMI 53315	BREYTT 01.11.80		