

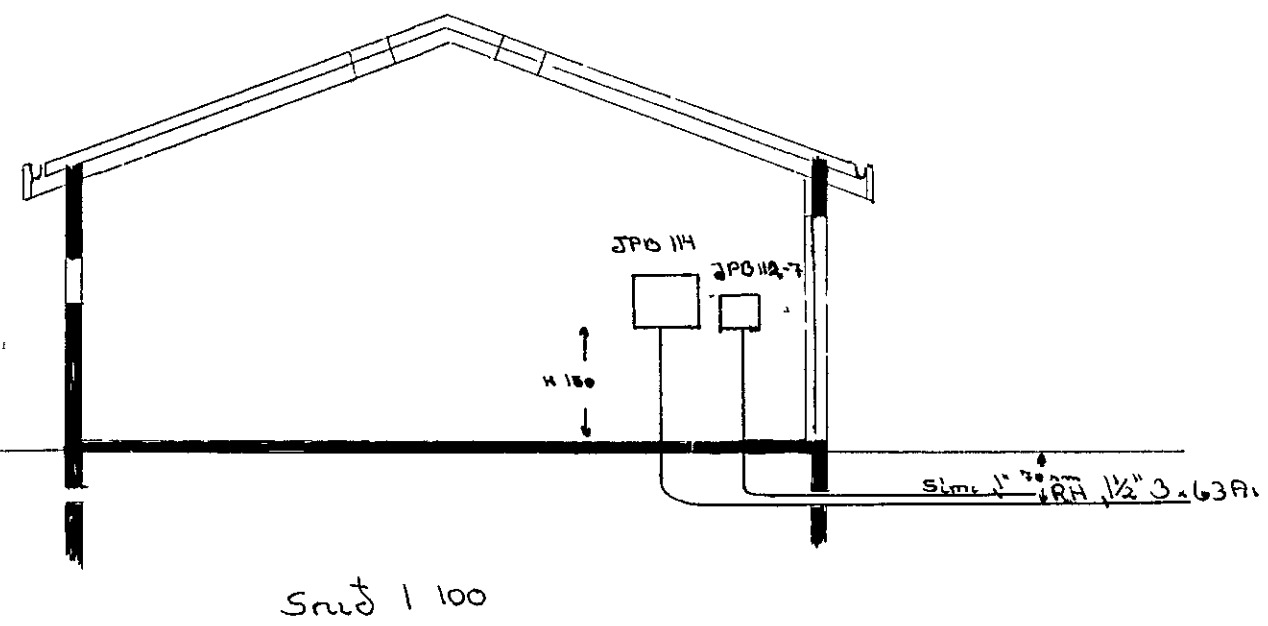


Efnlinamynd

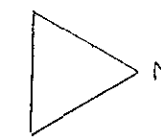

Húsnúmer 3039
 Samskipti 31.7.84
 2309
 1.84
 E. H. RAUFVEITU HAUFNARFIJARDAR

Lauslökk samskipti 31.7. 1984
 Albert Austriðsson

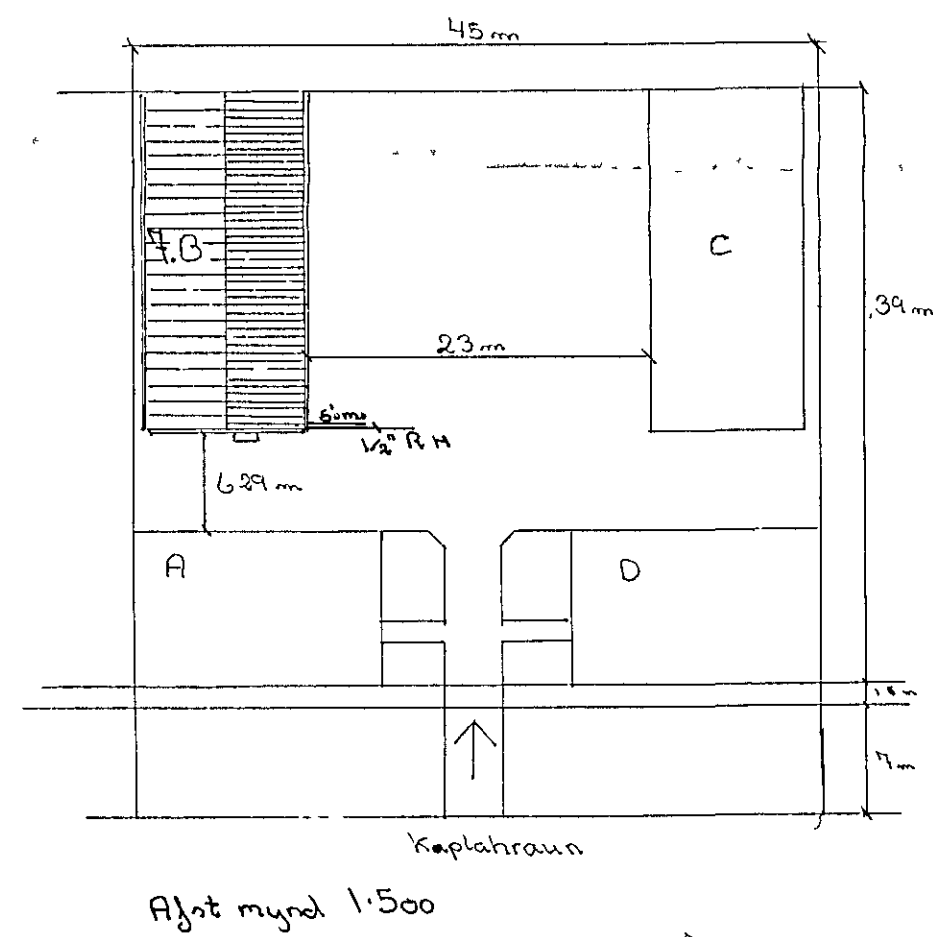

Luther Einarsson	Kaplaraun 7 B
Samp:	Efnlinamynd Snúðmynd Afst mynd
Mkr. 100, 150	
Blad 2 af 2	