



SÚLLJÁRN 8 x K10
GJARNIR
2 x KS 10 1/2 18


X-X 1:20

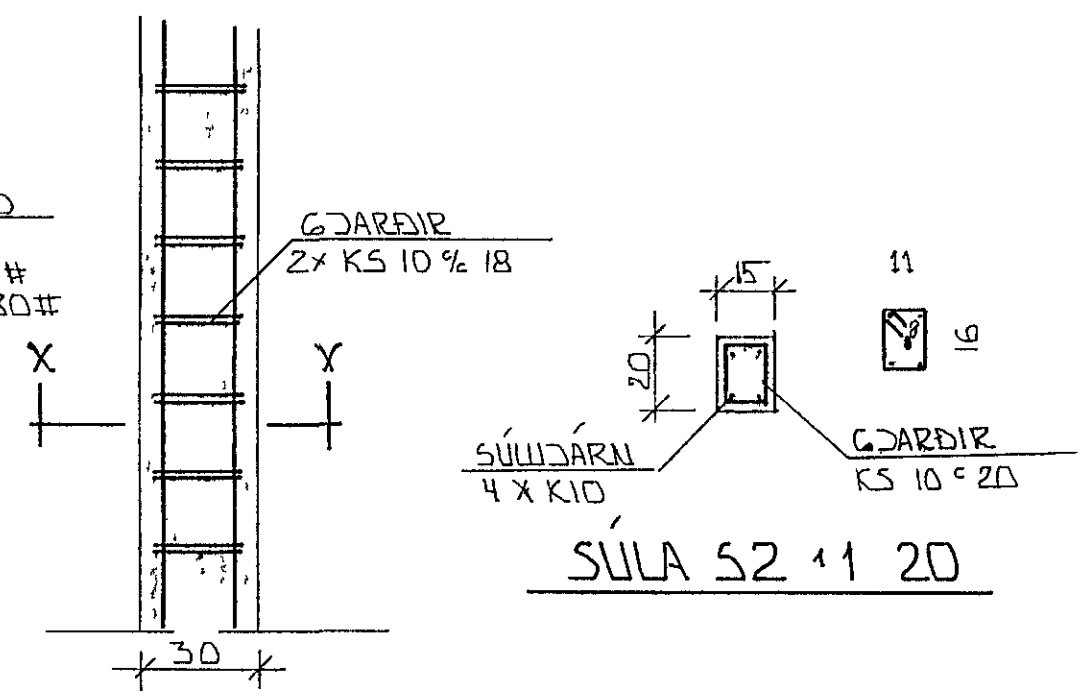

SÚLA S1 1:20

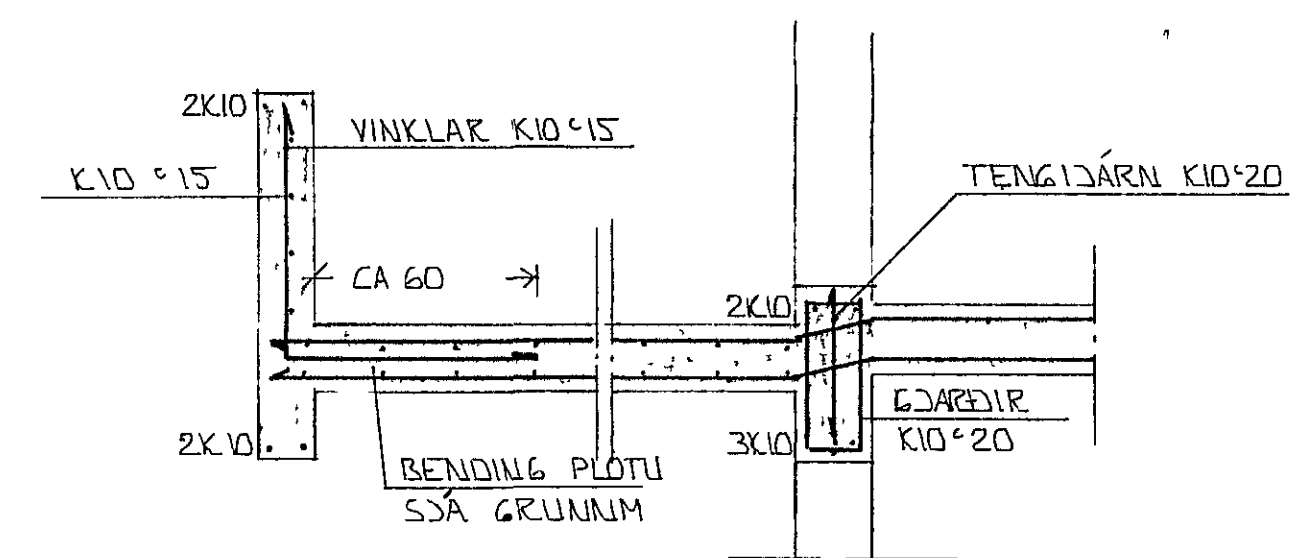

SNID 5-5 1:20

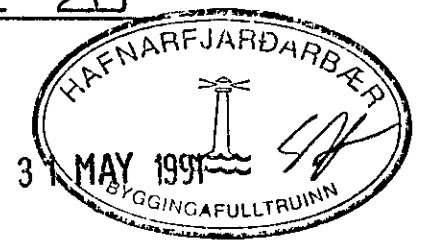

GRUNNMYND 1:50

STÆIPA
S > 250
VS ≤ 0.5
LOFT ≥ 6%
SEMENT ≥ 300 KG/M³

SKÝRINGAR

ALMENNAR SKÝRINGAR SÁ BL NR 1-01

02	MÁI '91	GAT Í PLOTU BILGEYMSLU	4/21
01	MÁI '91	SETT BENDING Í SVALIR VIÐ ANDD	GH
BR NR	DAGS	EDLI BREVTINGAR	SIGN
		LÆKJARBERG 17 HAFNARFIREÐI	DAGS ÁGÚST '90
		BENDING VEGGJA Á JARÐHEÐ	HANNAÐ
		BENDING PLOTU YFIR JARÐHEÐ	TEIKNAD GH
		MELIKV. 1:1 50	VERK NR 8945
		SIGURÐUR ÞORLEIFSSON TEKNIFRÆÐINGUR F.T.F.I.	BLAD NR 1-04
		STRANDGÖTU 11 HAFNARFIREÐI SÍMI 54751	