




SNID G-G

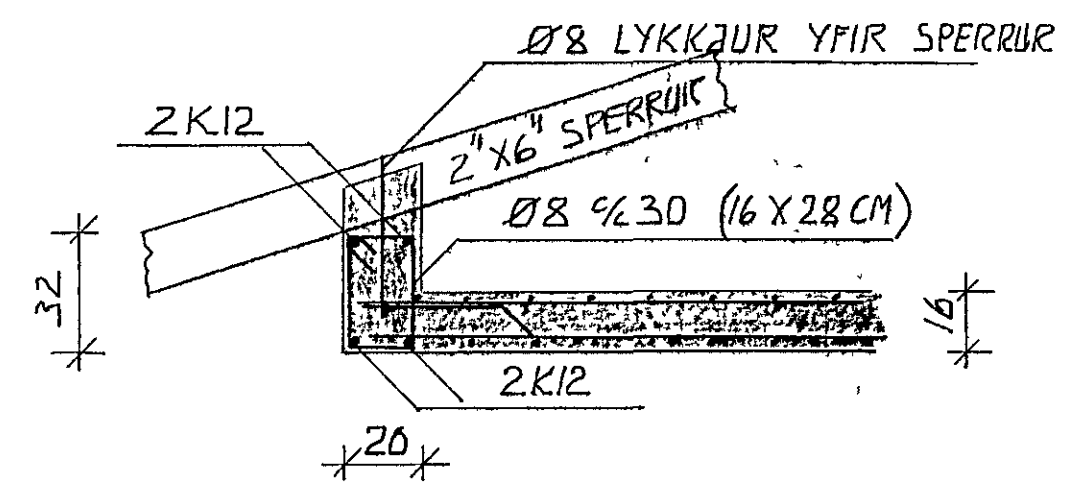


SNID H-H

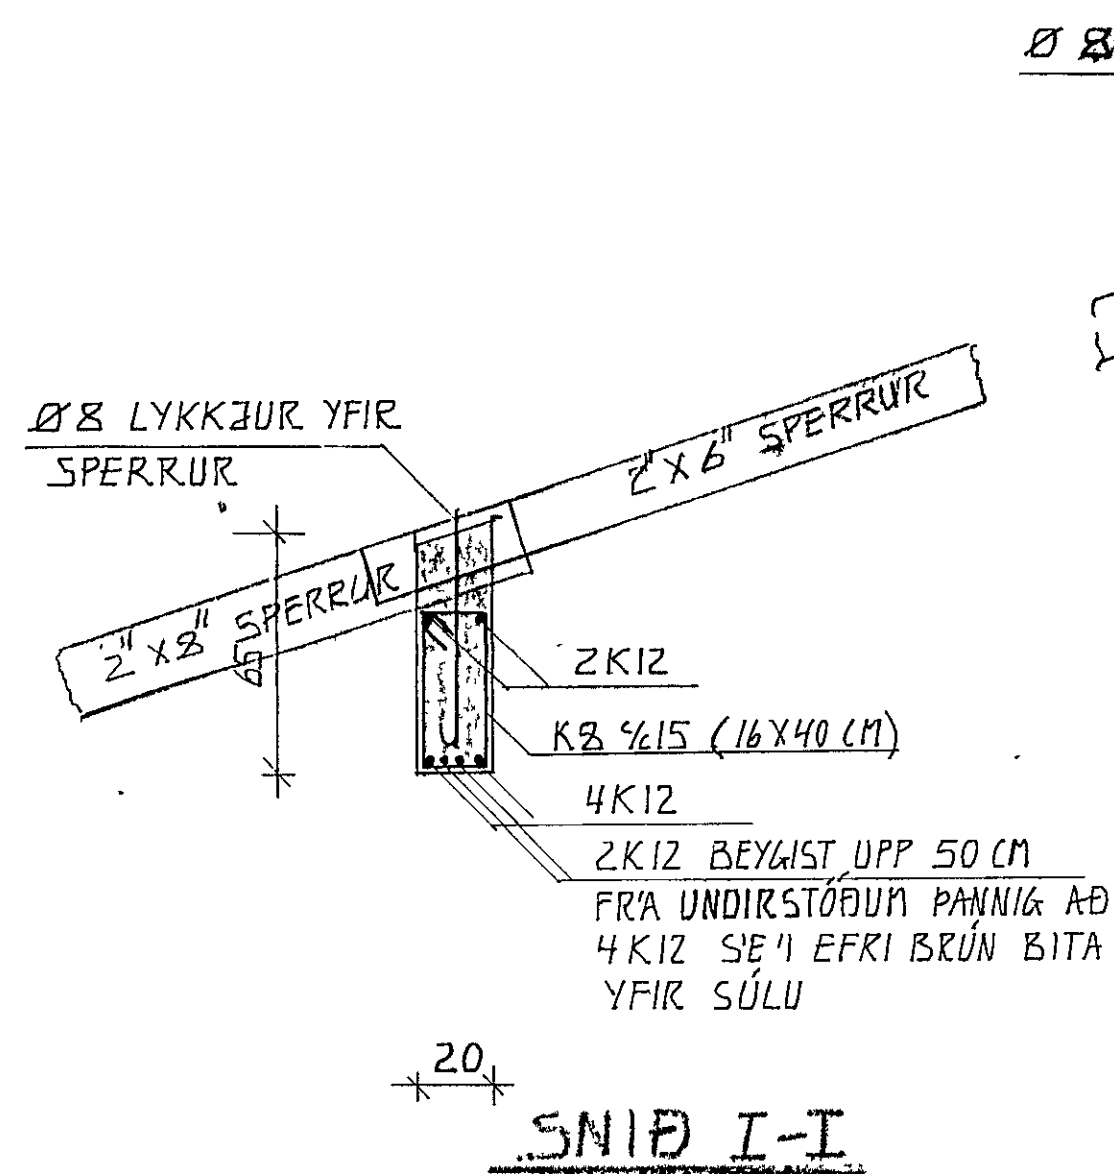


SNID I-I

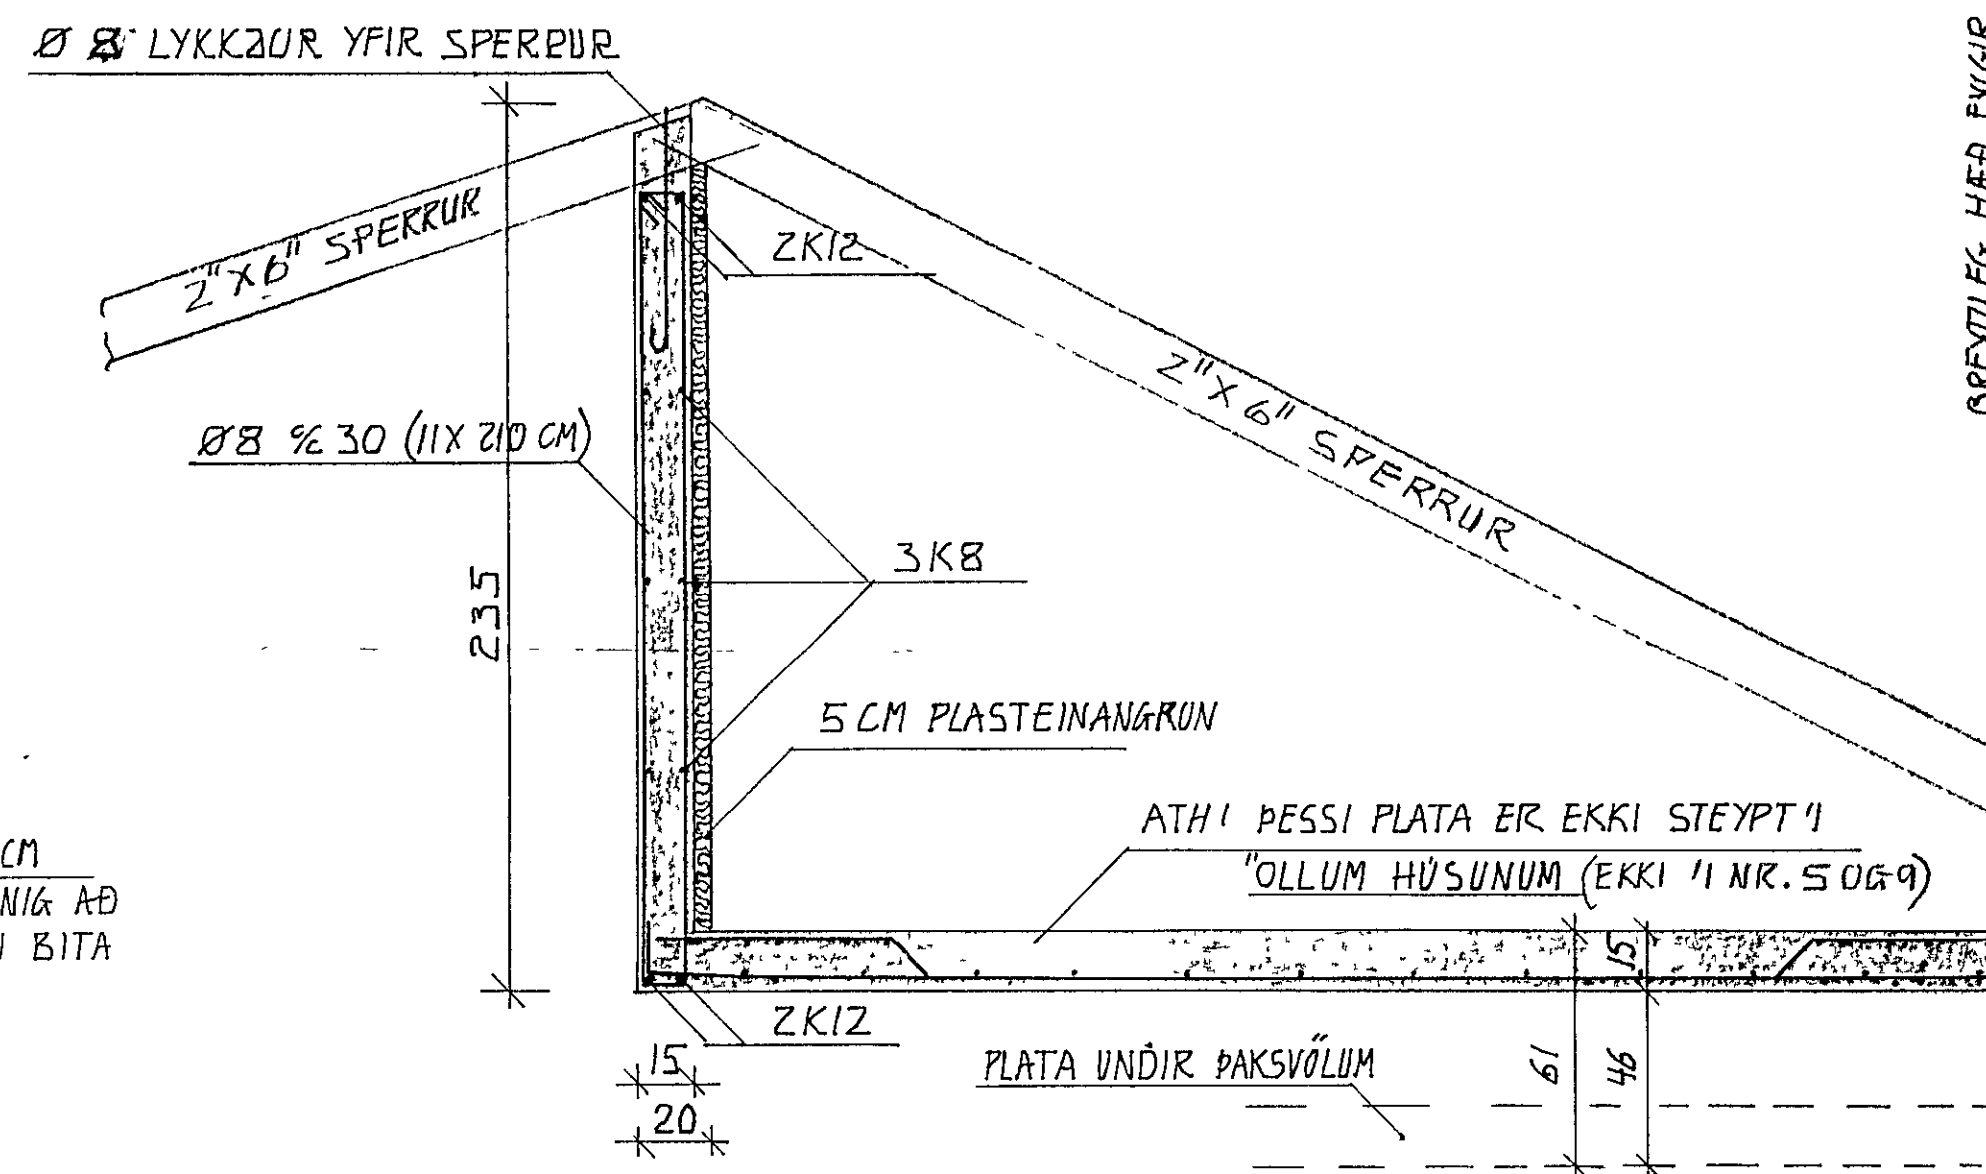


SNID J-J

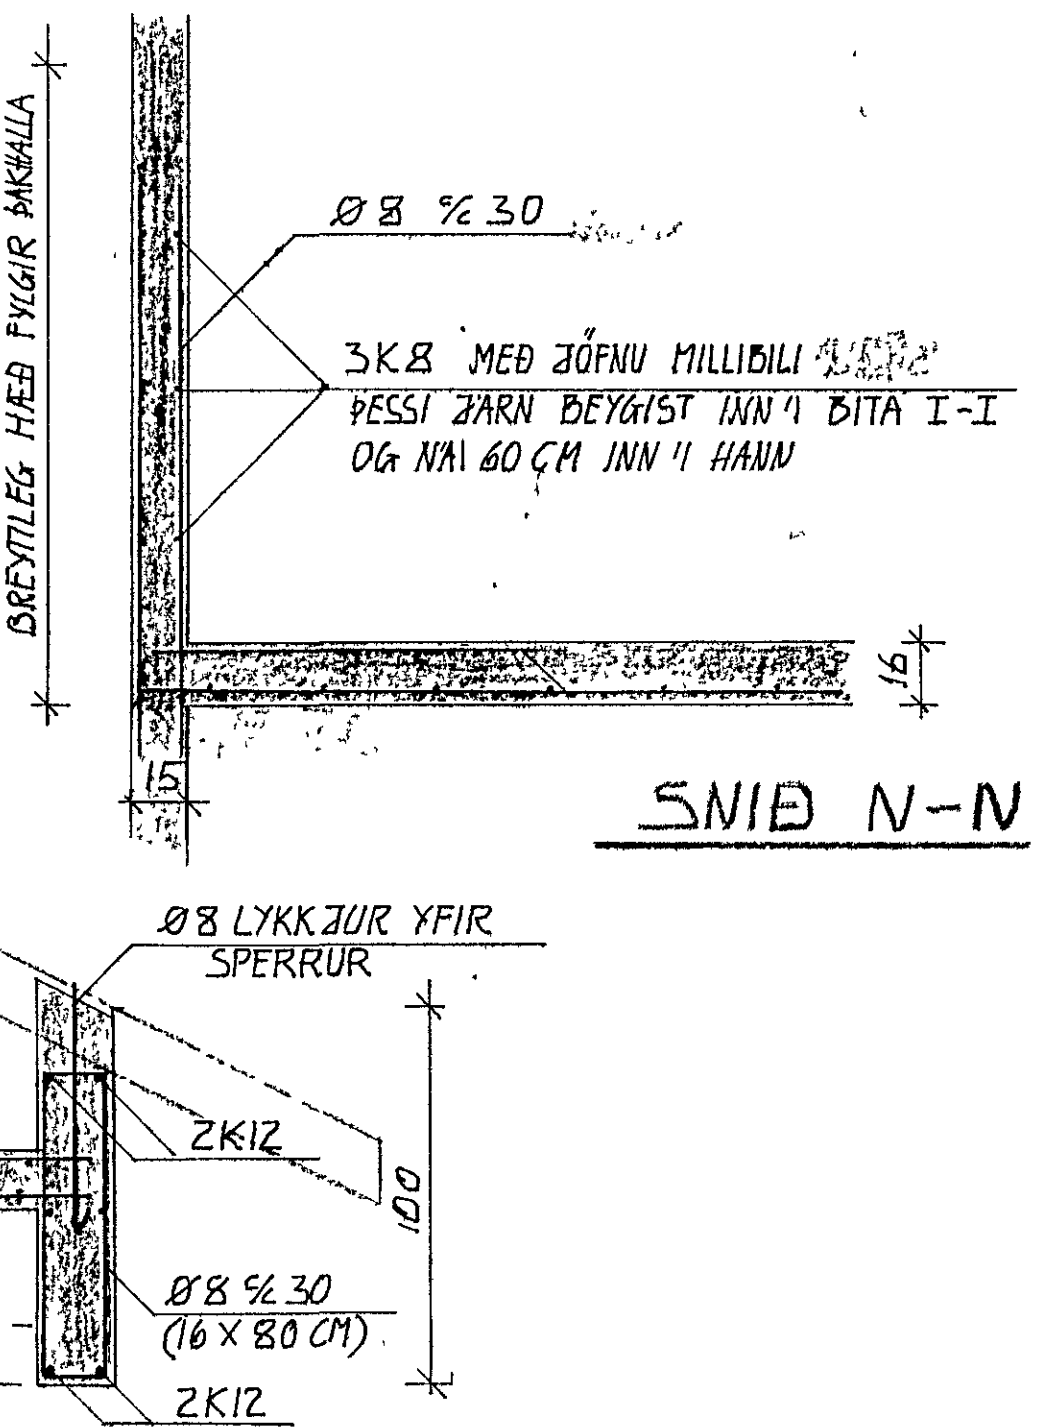


SNID N-N

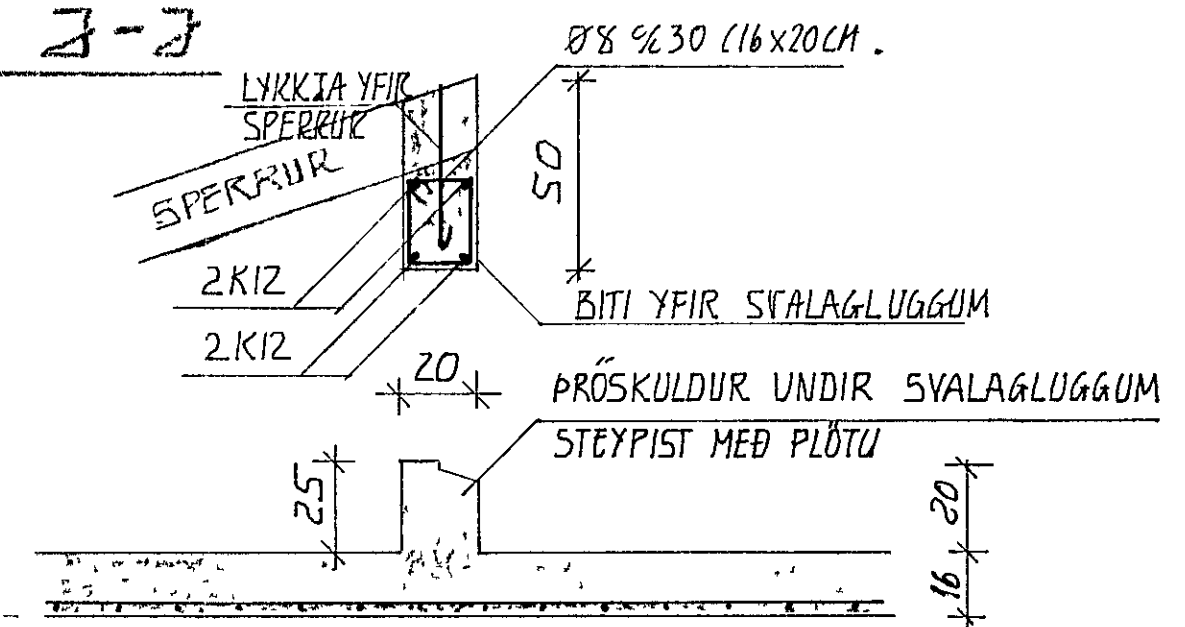

SNID K-K

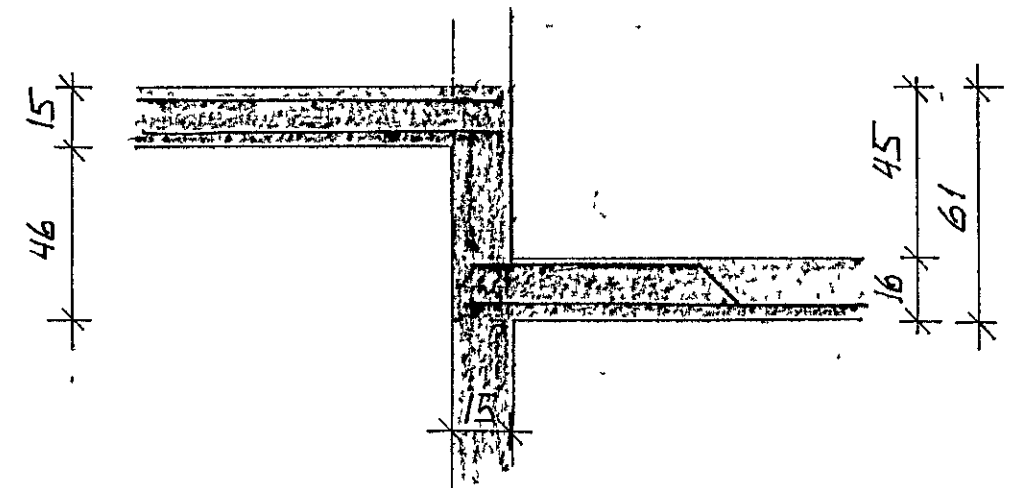

SNID L-L  
(KEMUR EKKI FYKIR I HÚSI NR 5069)

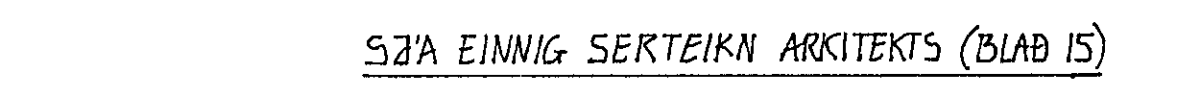

SNID M-M



SJA EINNIG BLAÐ B08

*Gunnar Ingi Ragnarsson*

BREYTING A SNIDI I-I JÚLÍ 1980 gkr

LEKJARHYMMUR	HAFNARFIRÐI	VERKNR 117
JARNATEIKNING	SNID I BITA OG PLOTU, EFRI	M. 1.20
HEDAR	EINNIG SNID BITA UNDIR SPERRUM	
GUNNAR INGI RAGNARSSON	FVFI	B09
LAUFASVEG 54	REYKJAVIK	S. 16908
		FEB 1980