




ÚTLIT SUDUR  
 1 100

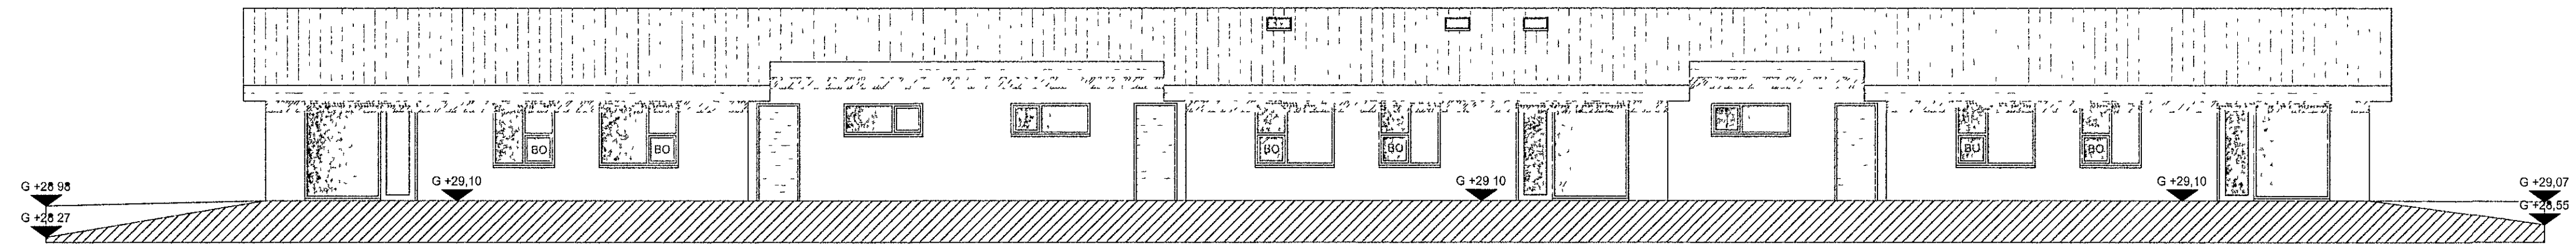


ÚTLIT NORDUR  
 1 100

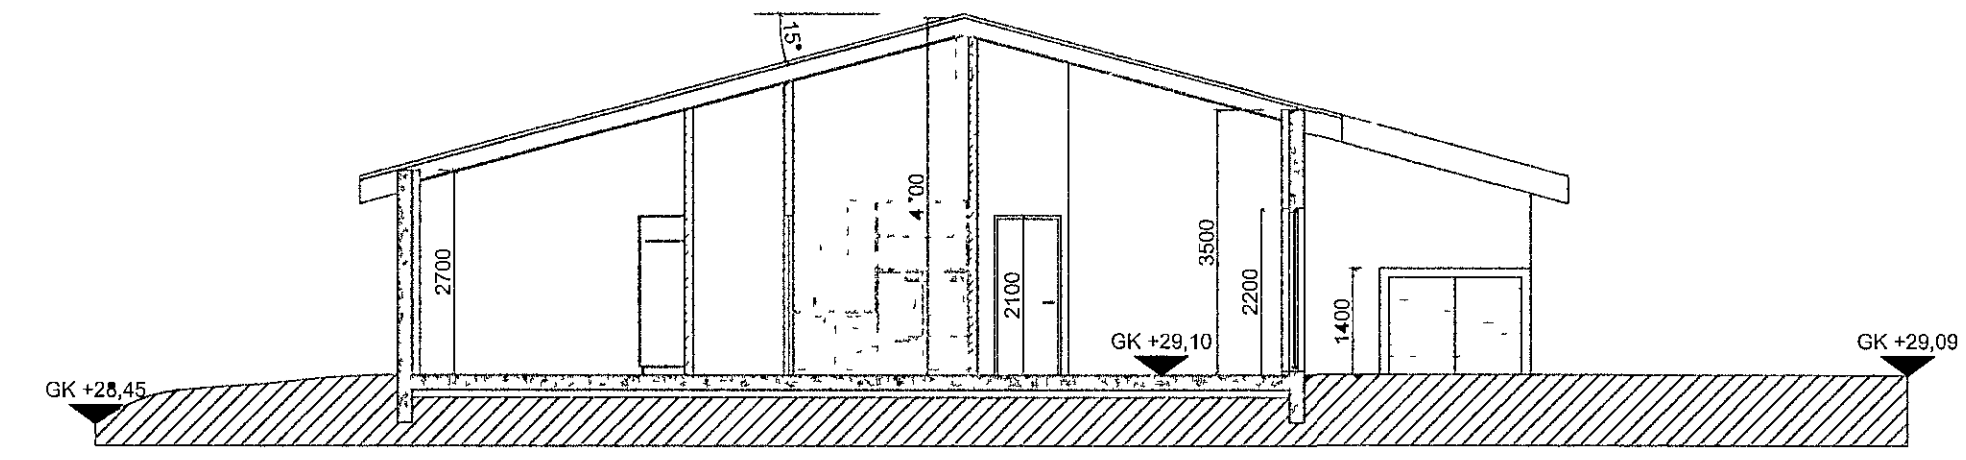


SNEIÐING A-A  
 1 100

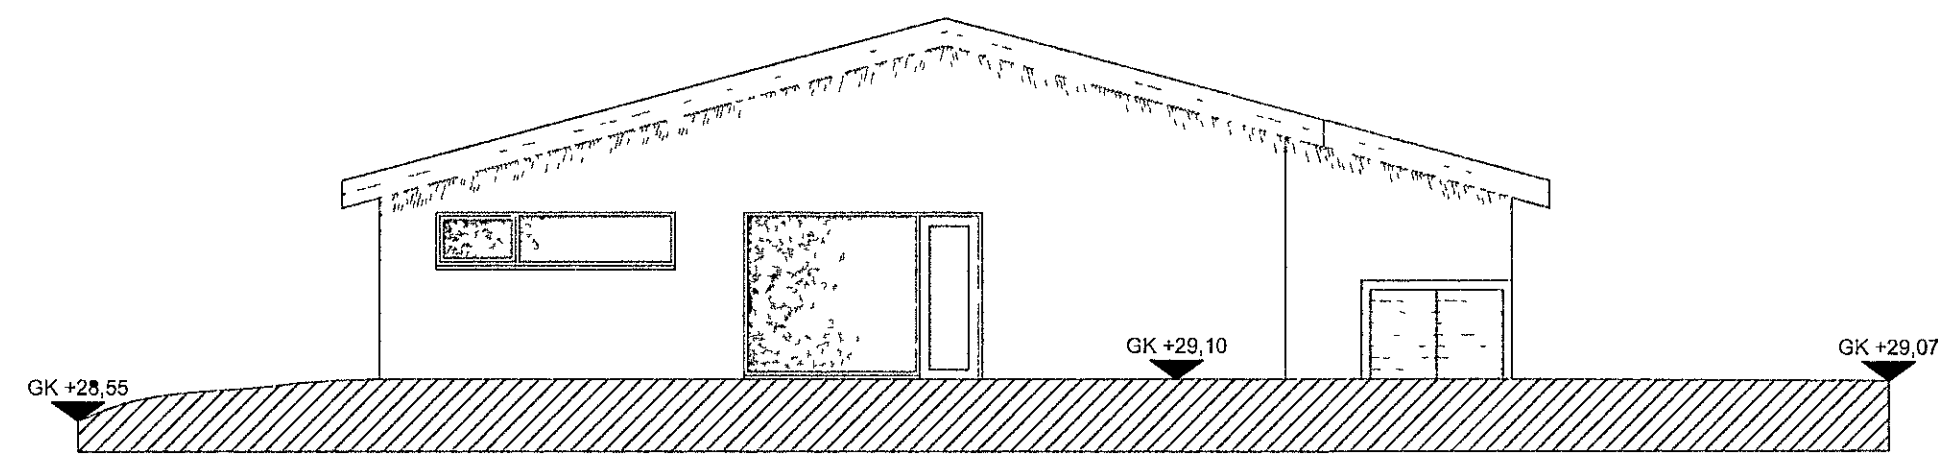


ÚTLIT VESTUR  
 1 100

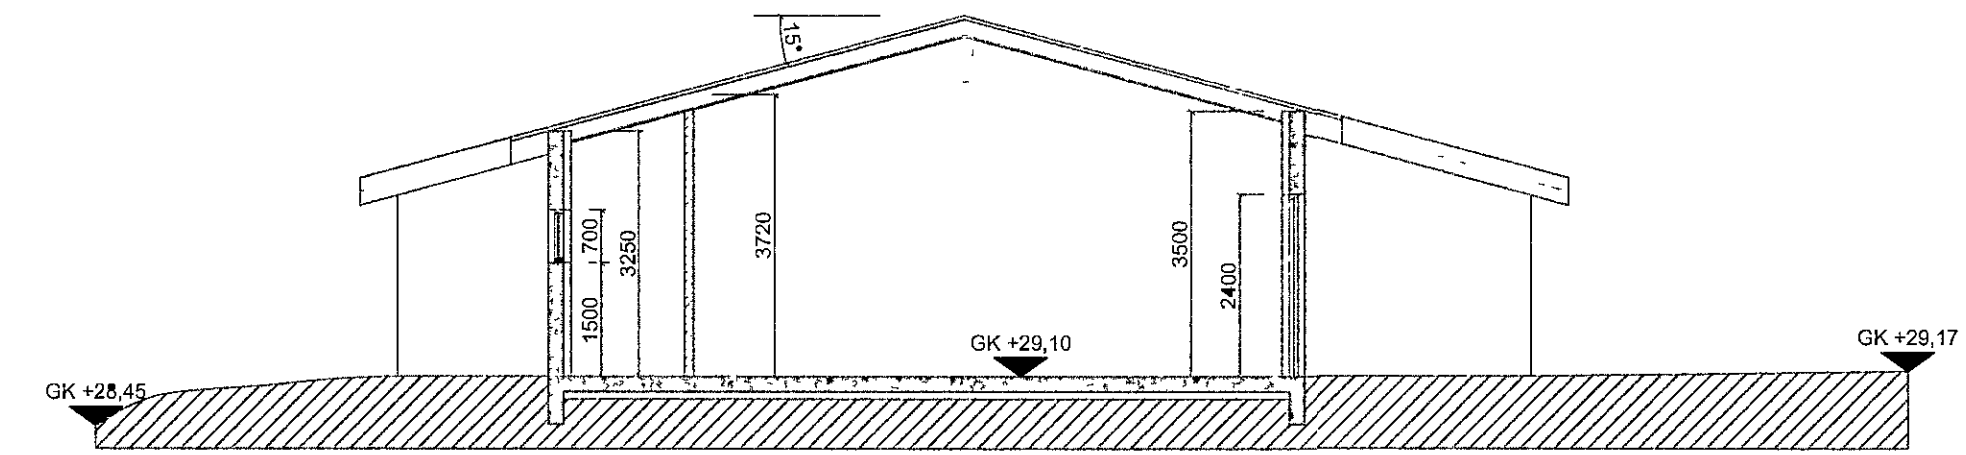


SNEIÐING B-B  
 1 100

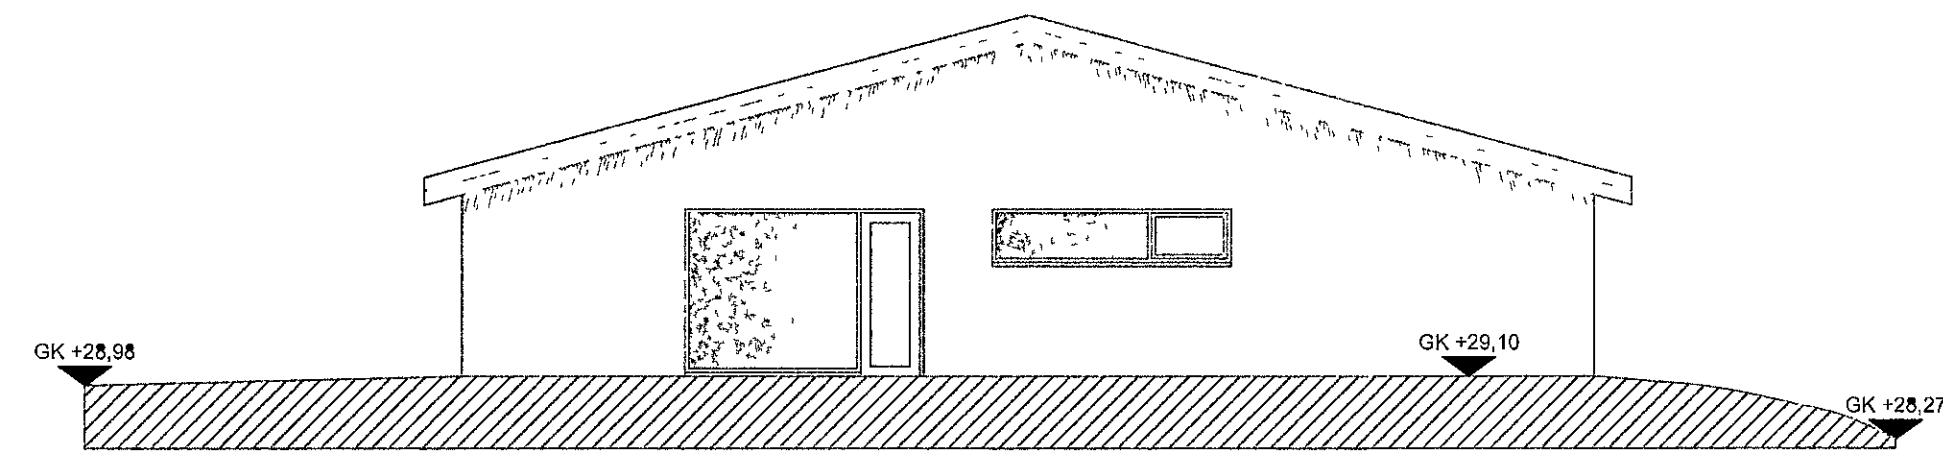

ÚTLIT AUSTUR  
 1 100

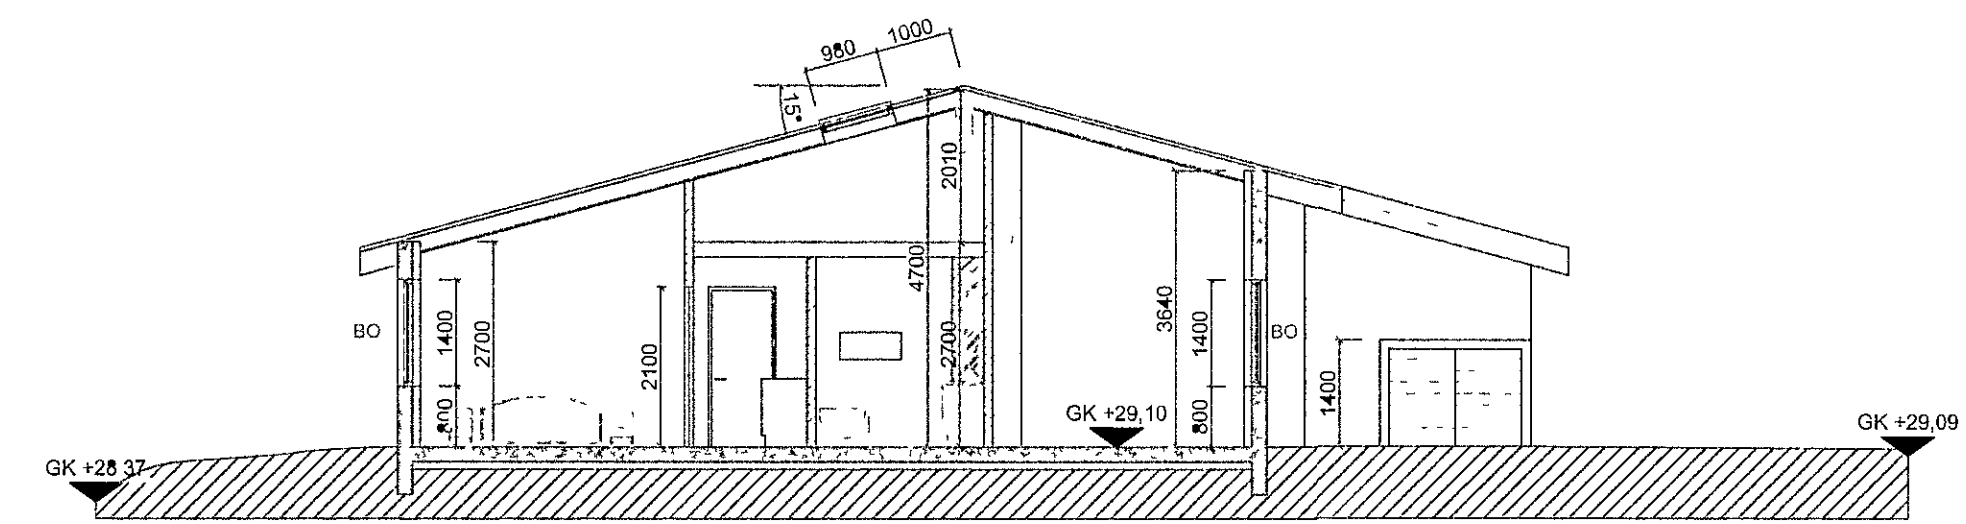

SNEIÐING C-C  
 1 100

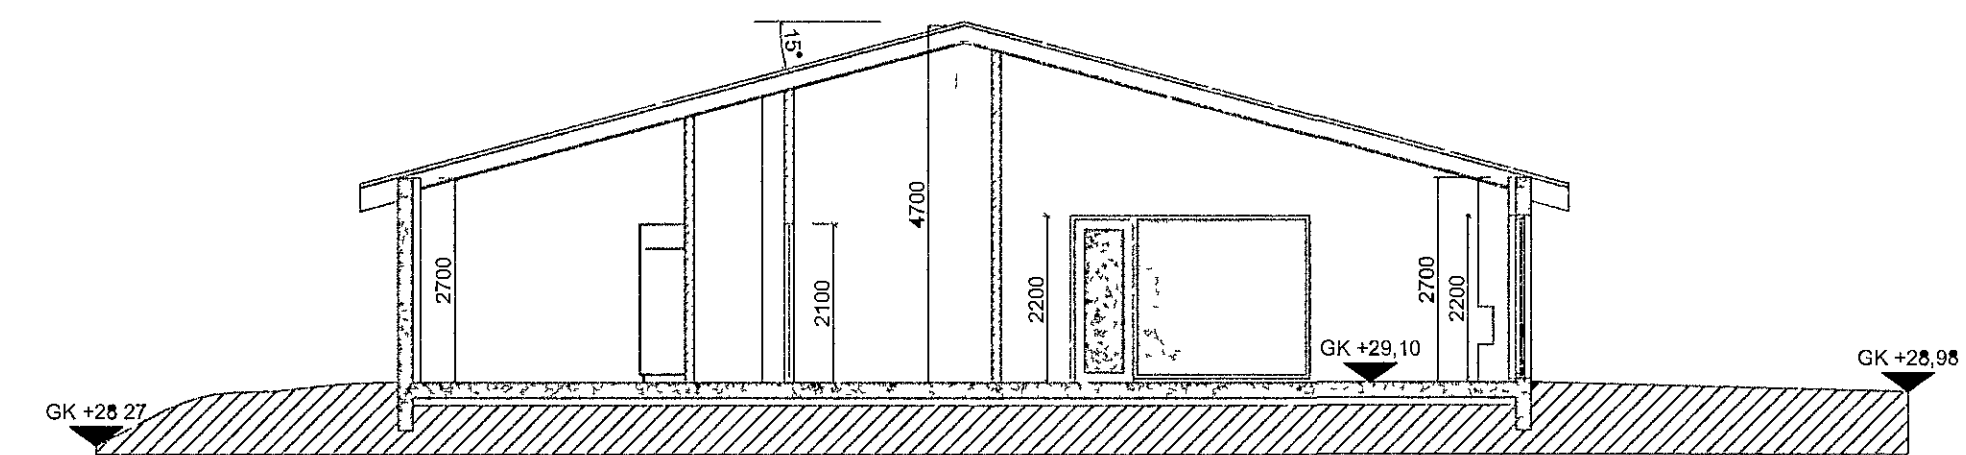

SNEIÐING D-D  
 1 100

NR.	DAGS	BREYTING	SP.
1	10 04 2007	breytingar a innri skipulagi nr 16	
2	09 06 2007	breytingar a innri skipulagi nr 14	
3	22 09 2014	reindartekning hus nr 14	
4	06 10 2014	antun tekni ut hus nr 14	
5	06 10 2014	stigi a millifott tekni ut hus nr 14	

R. J. HONNUN EHF.  

HONNUN - SKIPULAG RADGJOF  
 1. HAFNARFIRÐISBYGGINGA- OG  
 2. HAFNARFIRÐISBYGGINGA- OG

SAMBÝKKT  
 VERK

TEIKNING

KVARÐI

DAGS TEIKNING NR.

TEIKNAD AF