



Fyrir breitingu.

Nönnustigur 3. H.f.

1913

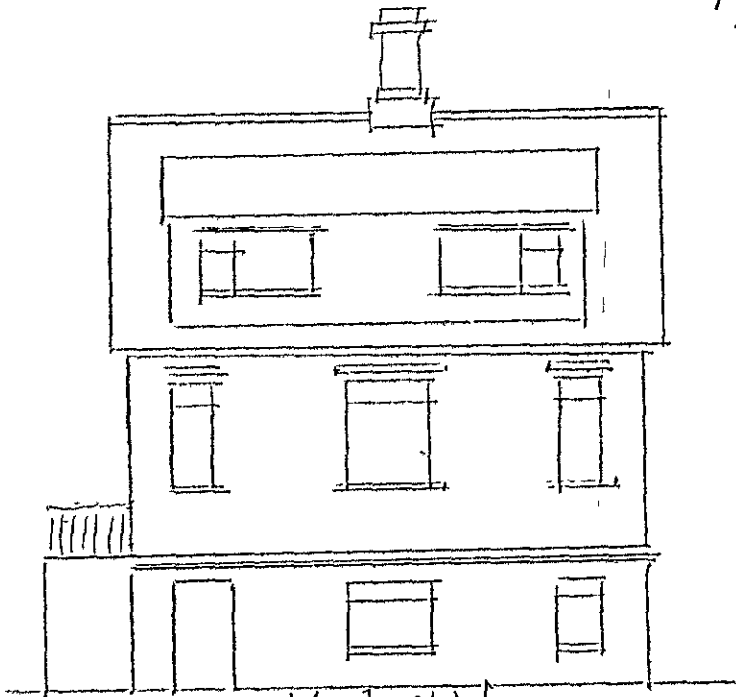


Vesturhlid

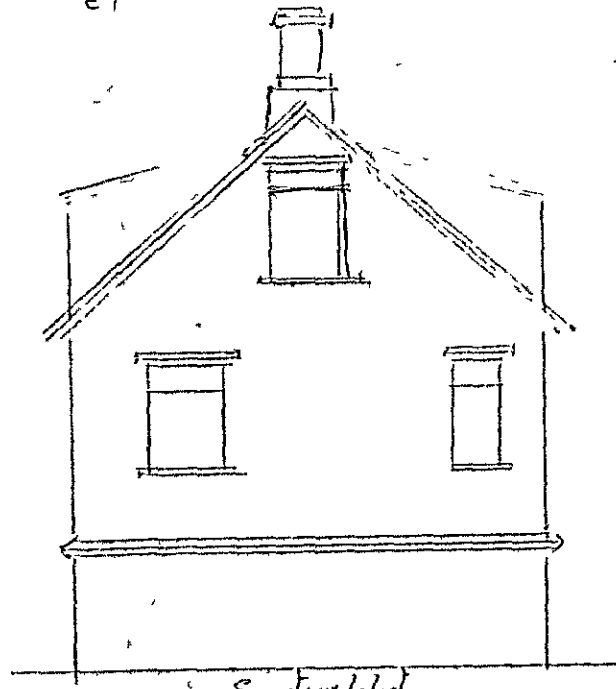


Sudurhlid

Eftir breitingu.

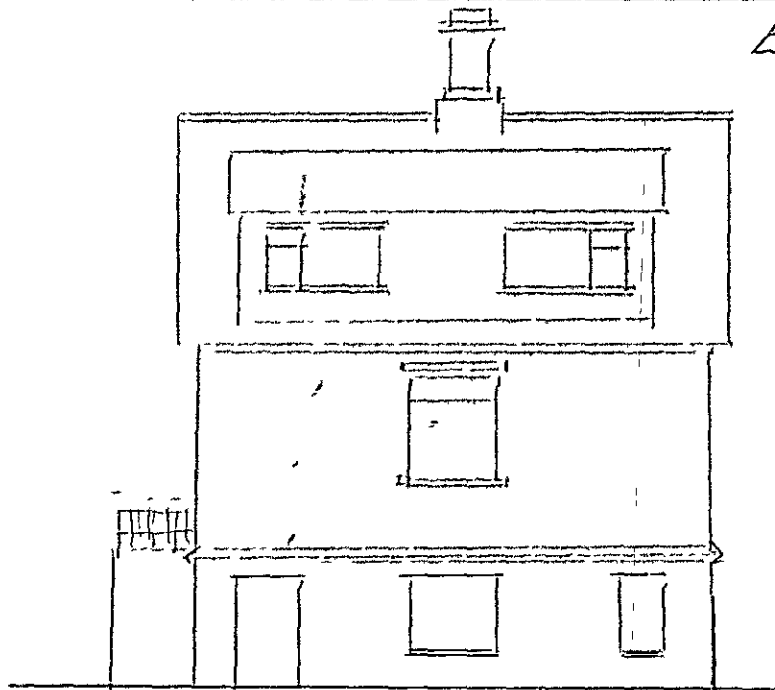

Vesturhlid.

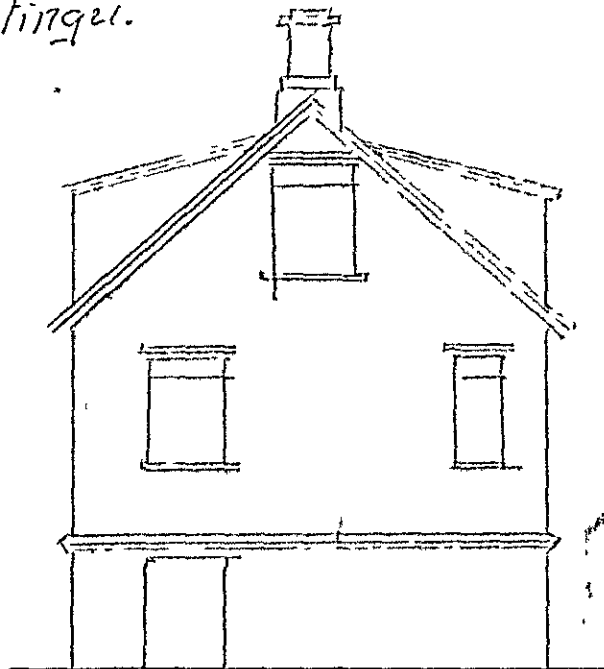

Sudurhlid

Summa 28/5 75