


Bilskur
Egils Jónssonar.
Reykjavíkurveg 16

Matkv. 1:100






Götuhl.

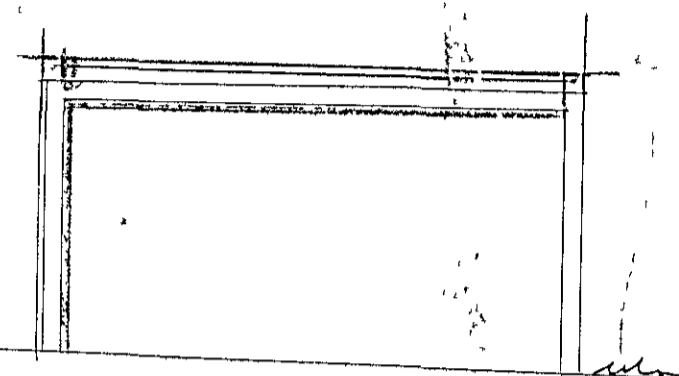


Samþykkt á fundi bygginga-
nefndar þ. 17.5.1960
BYGGINGAFULLTRÚINN
L.h. HAFNAEIRDI
F. Gunnarsson


Húðam
Múrarnam

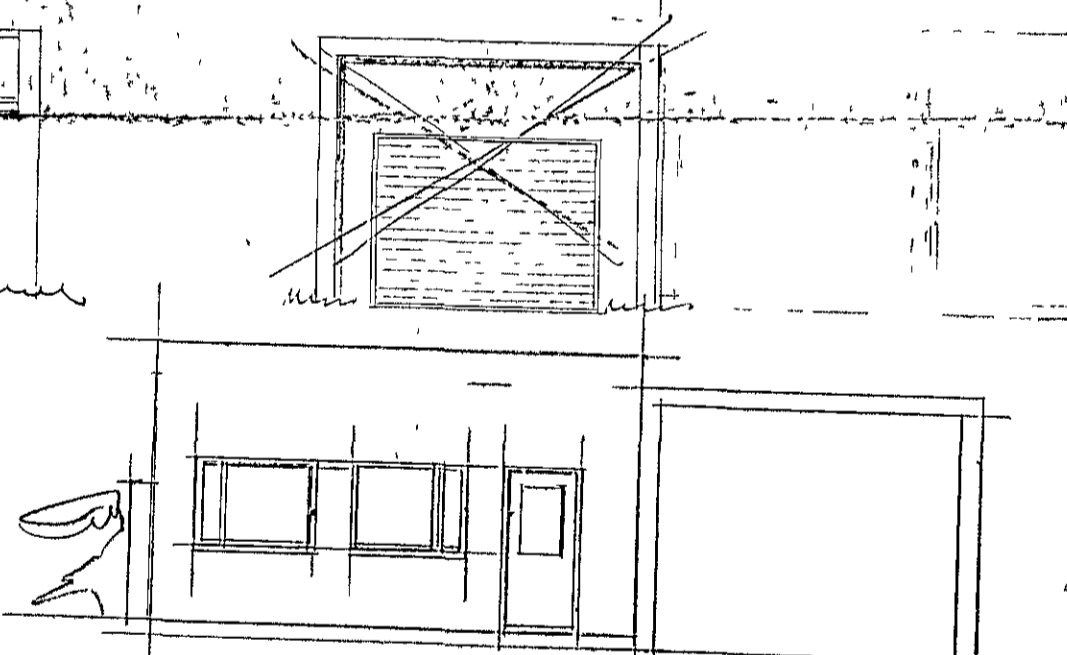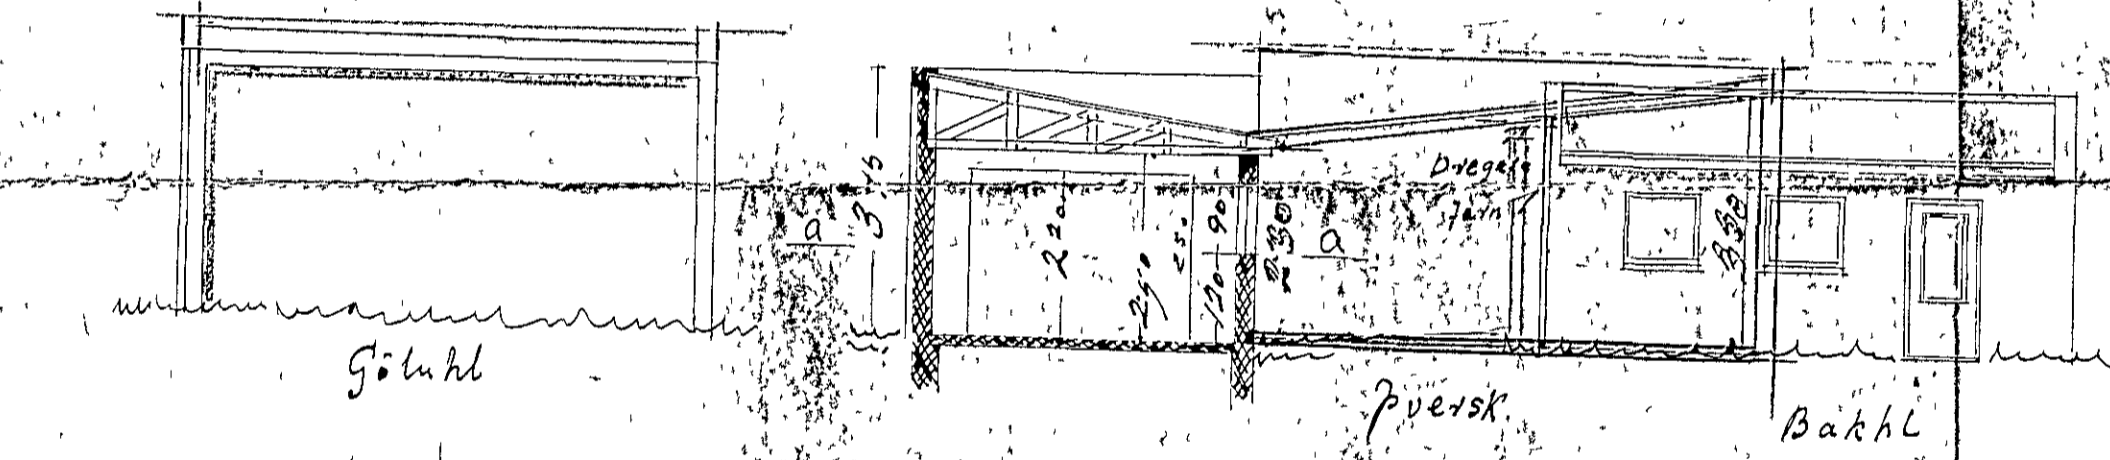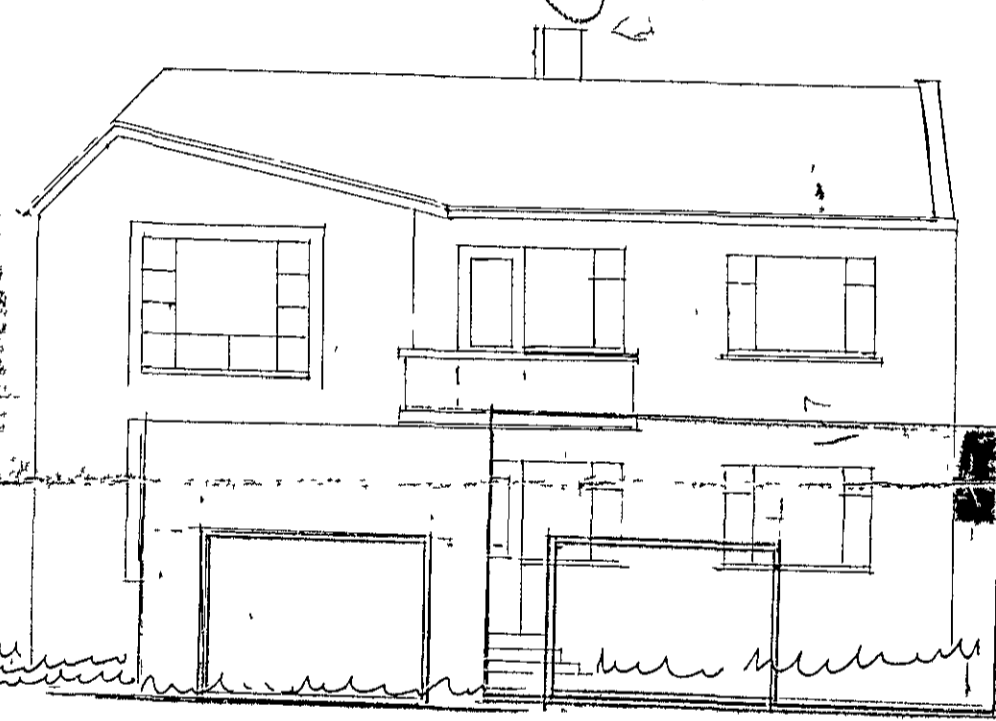

Afstöðumynd. 1:500

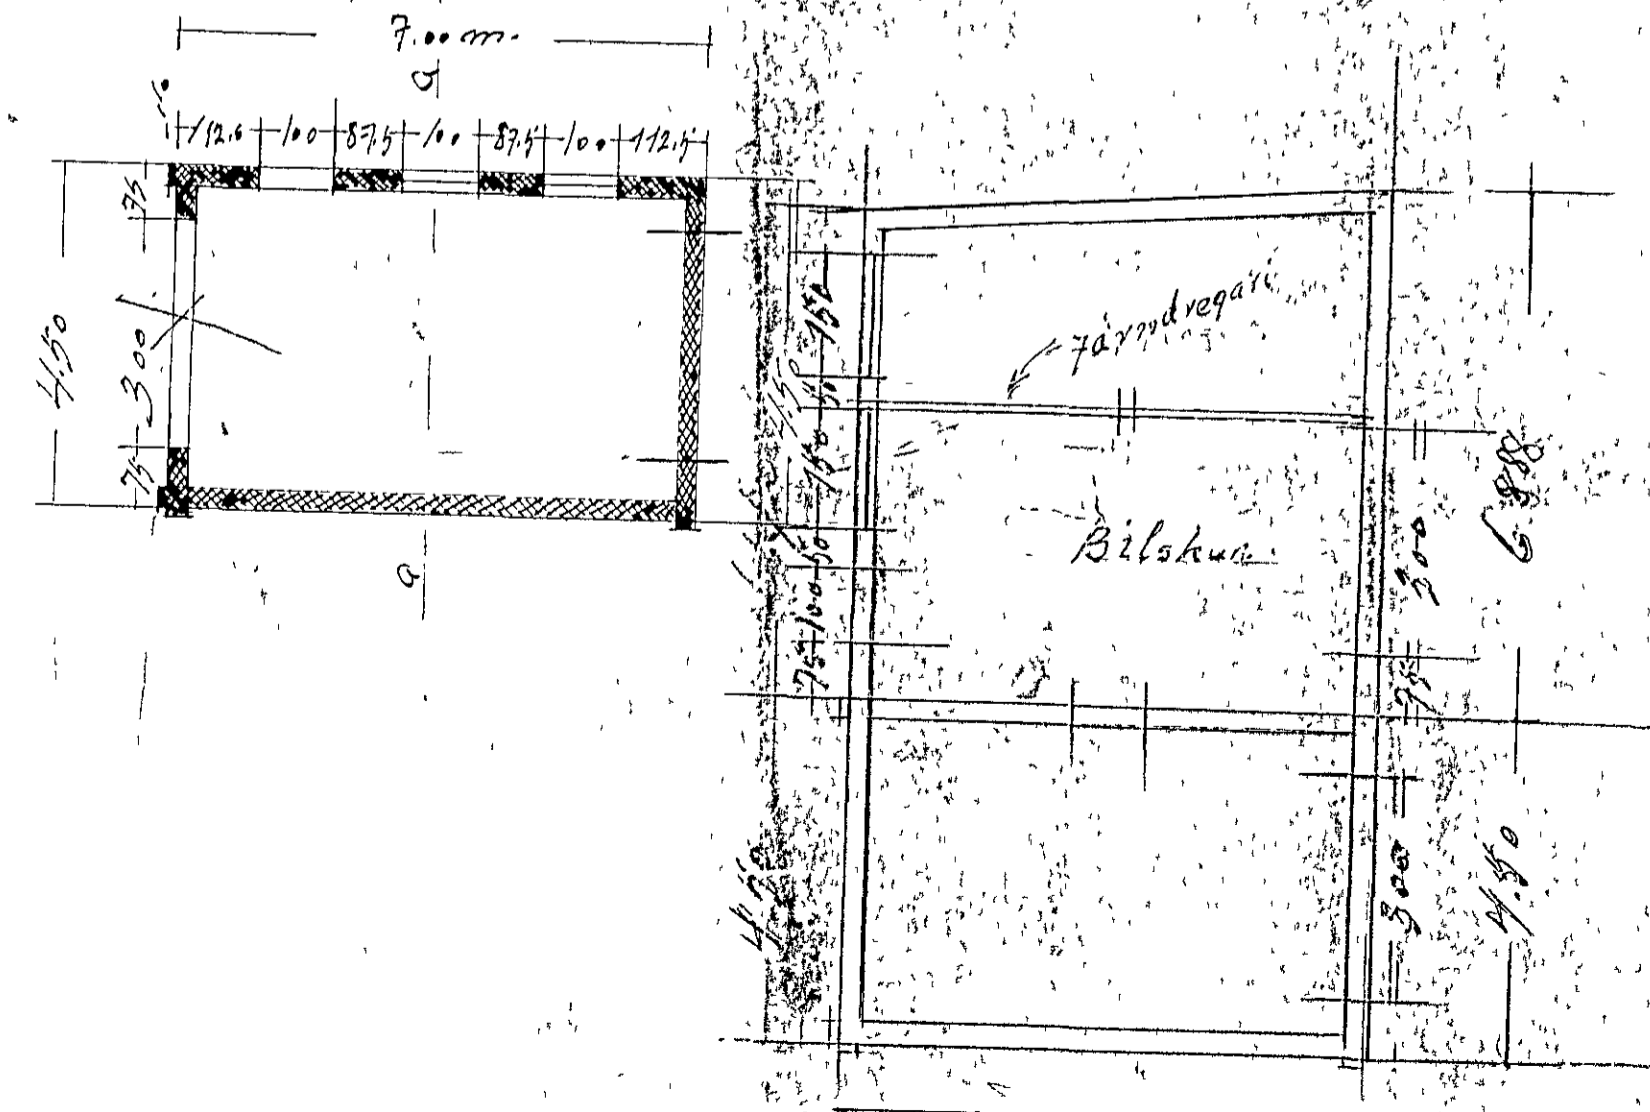

Húðarnam

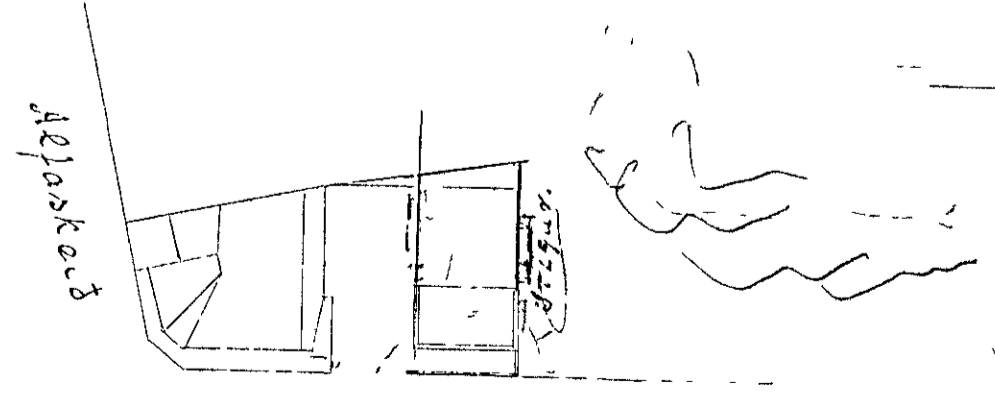

Reykjavíkurvegur.

Breyting.

= Bilskur
= Hafnaefir 7-21/64.
= Sigmar Guðmundsson

Hafnaefir 20/4 1960
Sigmar Guðmundsson