



0

STÁLSKYGGNI YFIRLITSMYND

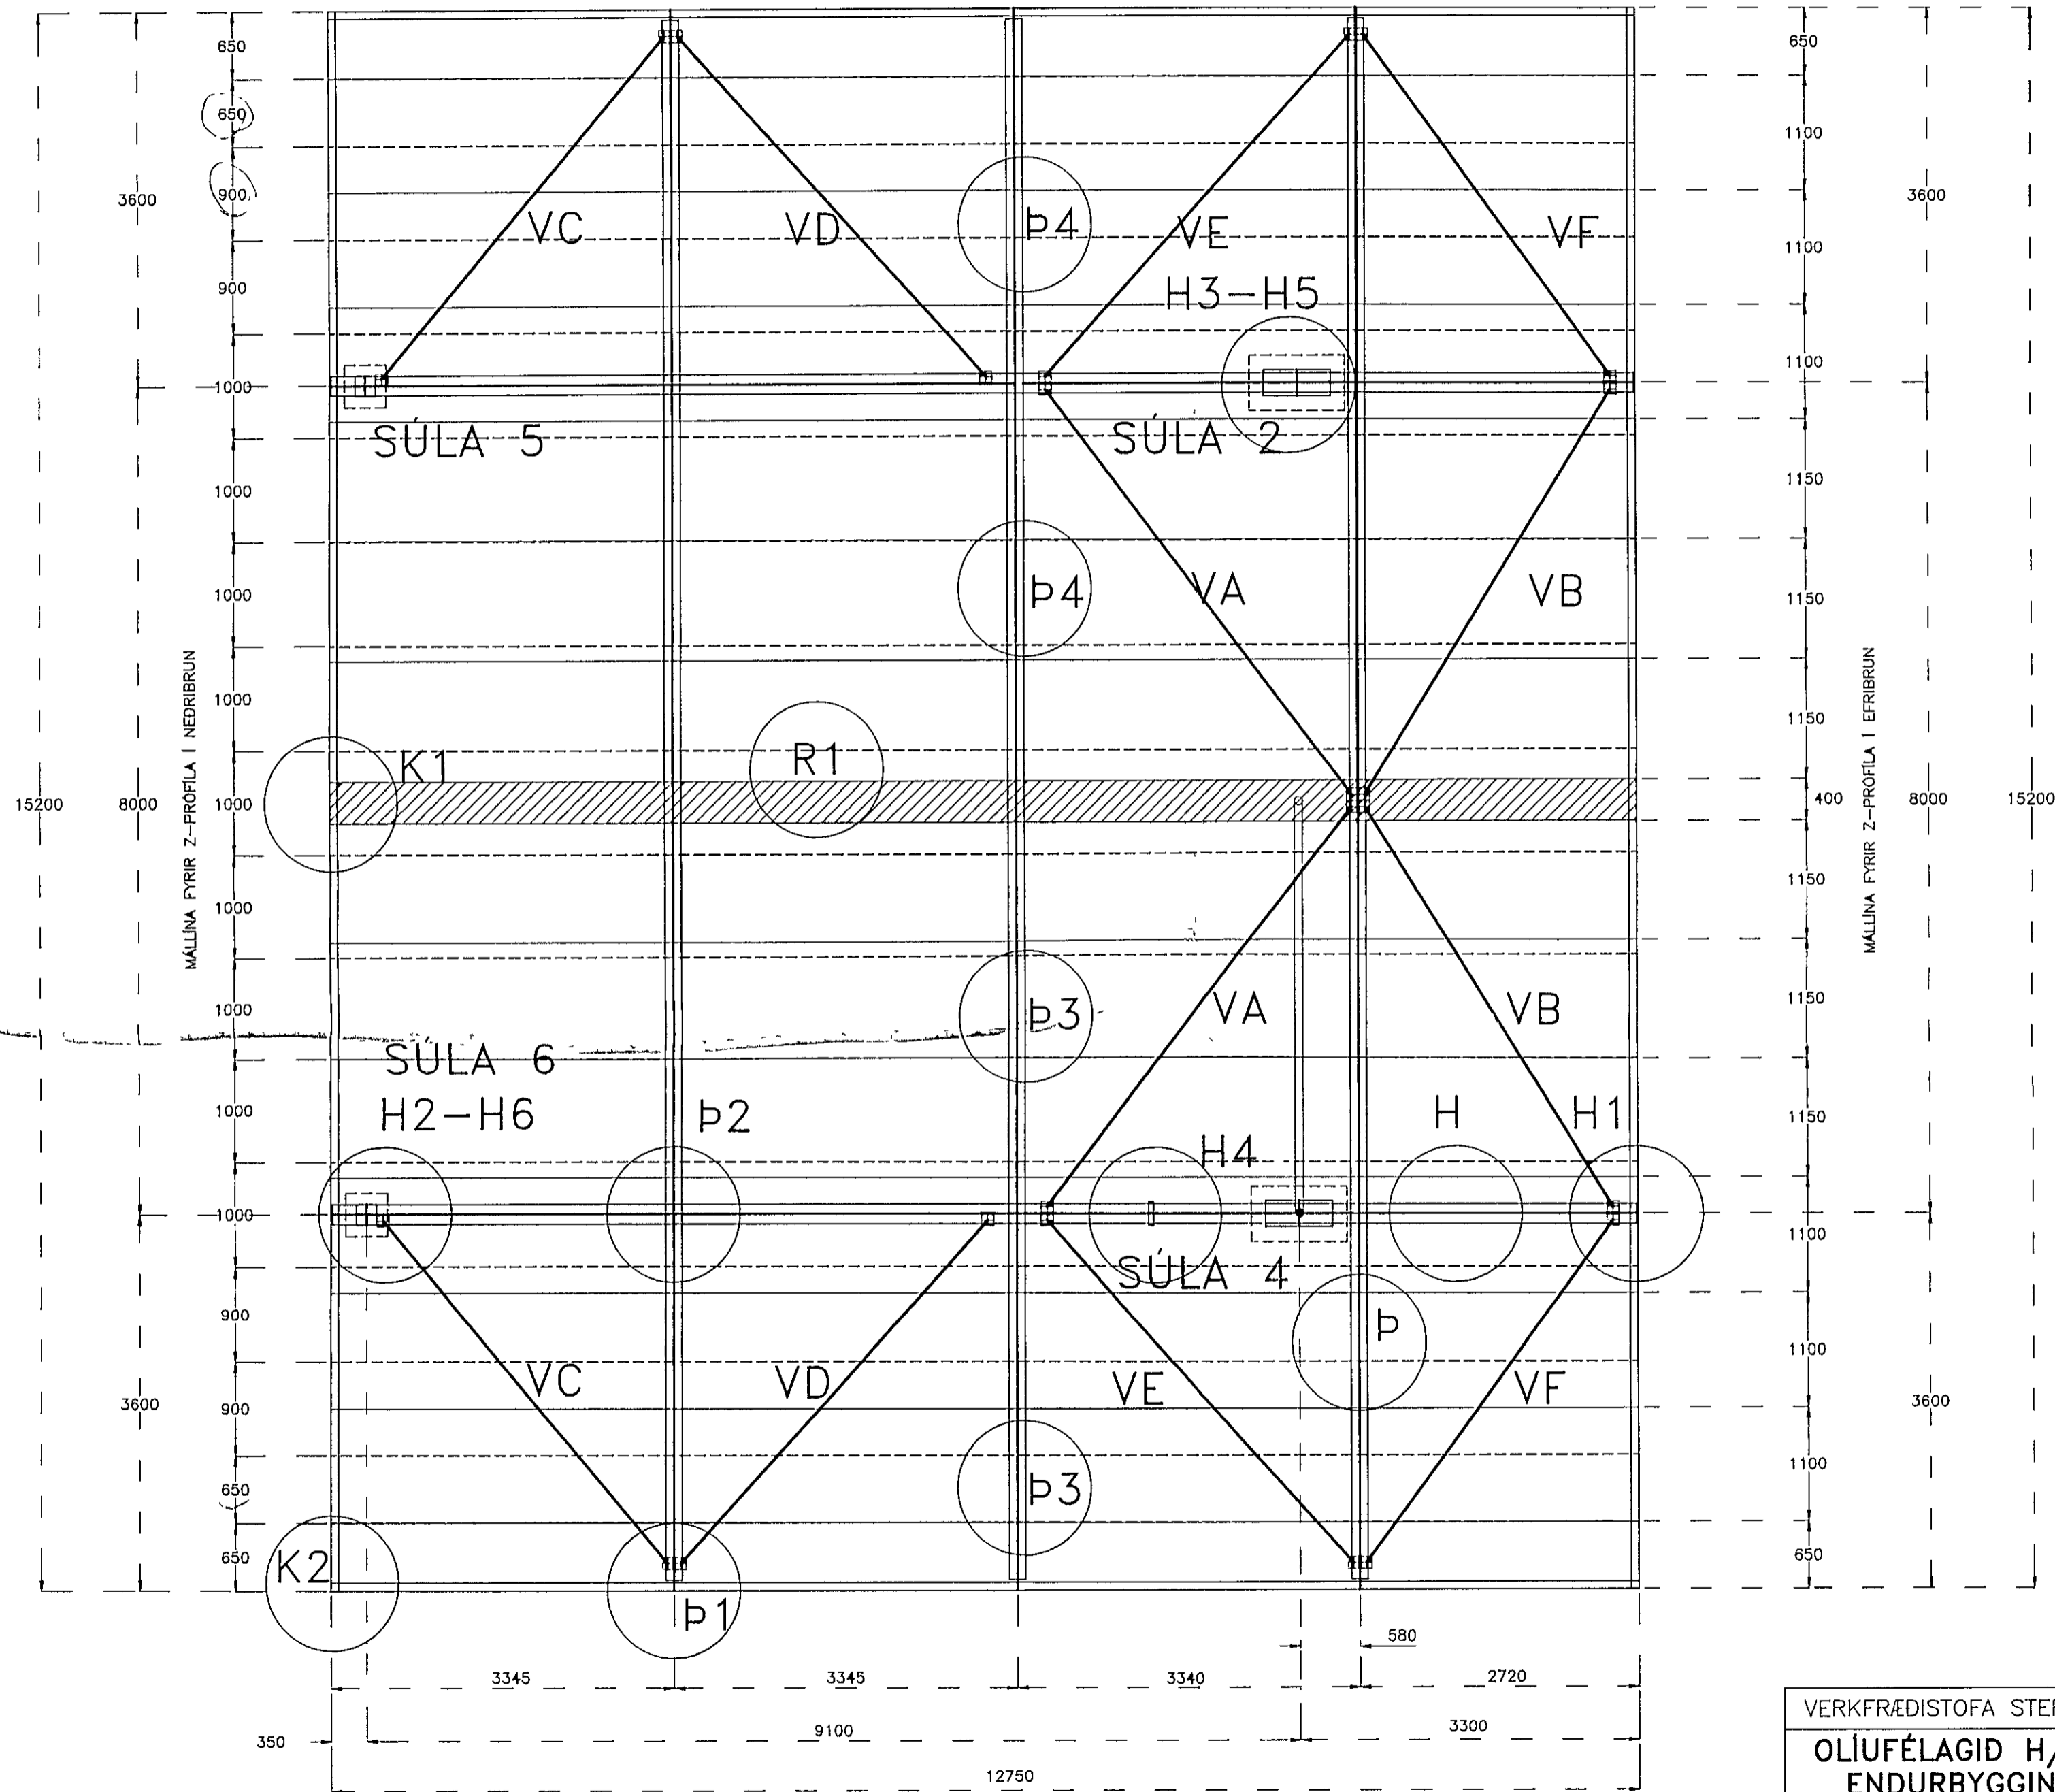

- Z-PRÓFILL VID EFRIBRUN
- - - Z-PRÓFILL VID NEDRIBRUN
- VINDSTÍFUR

EFNI SÉ STÁL 37 OG ALLIR BOLTAR 8 8

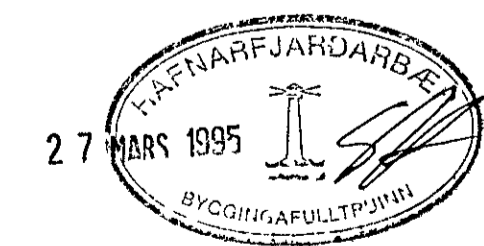

VERKFRÆDISTOFA STEFÁNS GUÐBERGSSONAR, SÍÐUMULA 33, S 681590			
OLUFÉLAGIÐ H/F-REYKJARVÍKURVEGI 54-HAFNARFI.			
ENDURBYGGING - BENSINSTÖÐVAR-STÁLSKYGGNI			
STÁLSKYGGNI YFIRLITSMYND			
SKRÁ 2161YF11	MÆLIKVARÐI 1:50	VERKN 95-216	TEIKN 1
DAGS 27-01-95	HANNAÐ <i>de S</i>	TEIKNAD <i>de S</i>	SAMP <i>de S</i>