


Breytt til samræmis við stíð IS (Blas 2)
 Skv samtal við Hermann Isib. 30.11.89

[Handwritten signature]

30.11.89

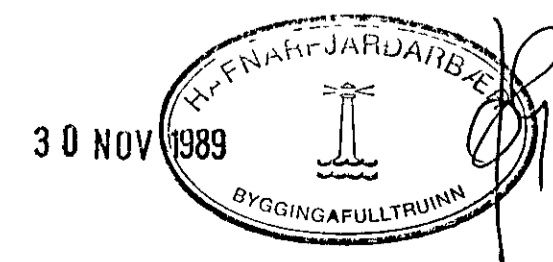

PROJ. N. 101	1:50	BYGGINGAFULLTRUINN
DRÖG. N. 21, 1. FL. 1989	1989	
FL. 1	1	<i>[Handwritten signature]</i>