


Gólfplötur eru bjarnberntar
 fylling þjappist m tilliti til þess.
 gólfplata
 1 plötuleypu blattidisl polyestertréffar
 "Fibrin 25" 0,91 kg pr m² skeypu
 Fylgja skal fyrirmatum framleiðarinnar
 um efni og meðhöndlun.

K:32.10


K:32.00

Undirstöðubotn er hraunplöt,
 $E \approx 100 \text{ kg/cm}^2$ $N \approx 30 \text{ t/m}^2$
 steinleypa 3250 gement 300kg/m³
 signdi 8-10cm \sqrt{s} 0,55-0,6 loft 5-7%
 fjárl loft 0,25 mm.

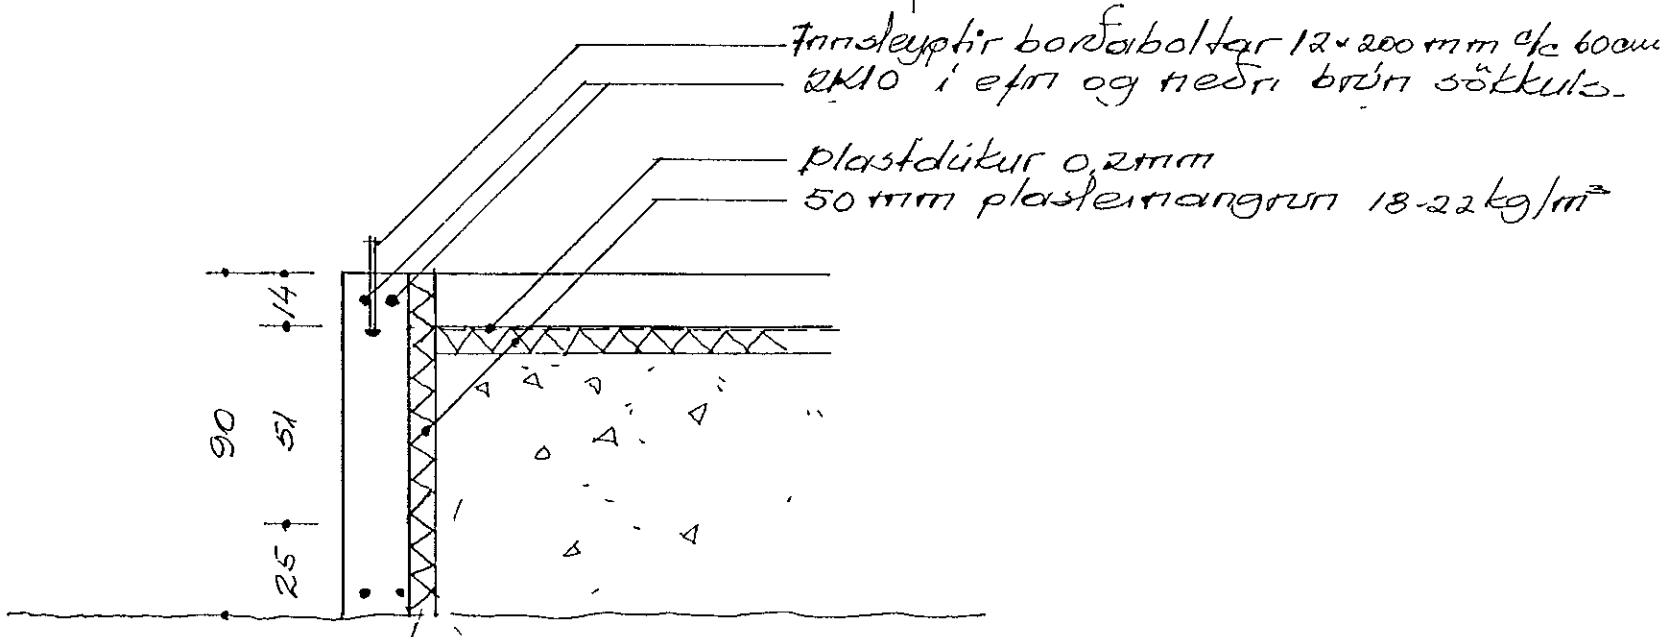

SKURÐUR A 1:20

ÁSKILID, ELDRÍ
 TEIKNING ÓGILD

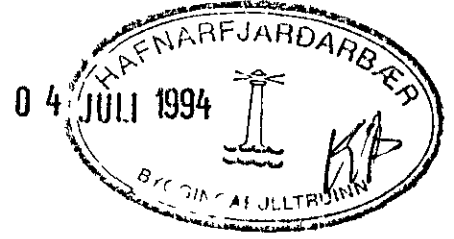

Þreytt 23.6.94 gólfplata, kótar, smangrun undirstöðub.

ÚTHLID 8 HAFNARFIRÐI	
Lögelfur Pálsson M.T.F.I. Baldur Þimarsson MBFI	UNDIRSTÖÐUR