

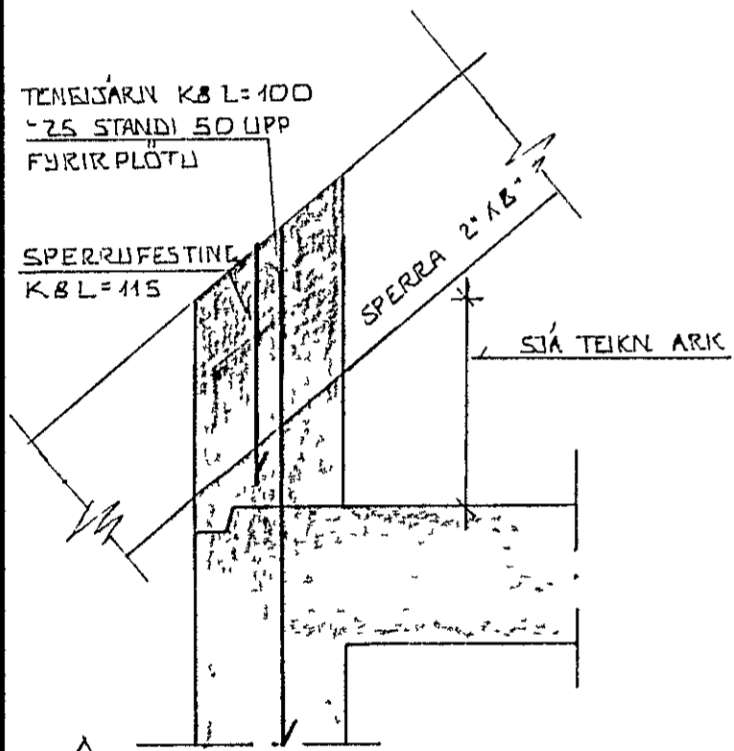
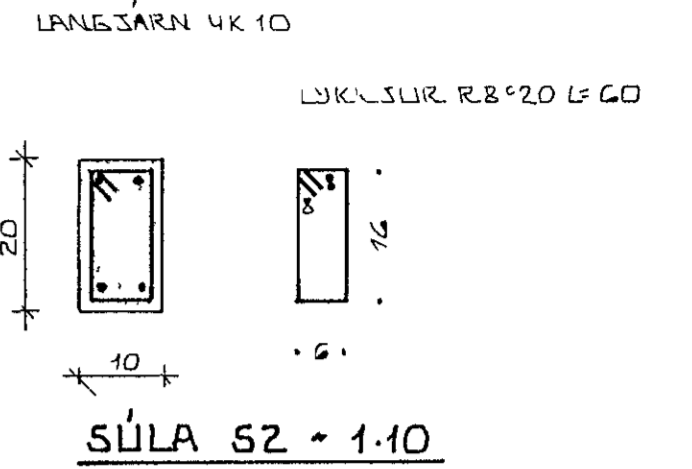
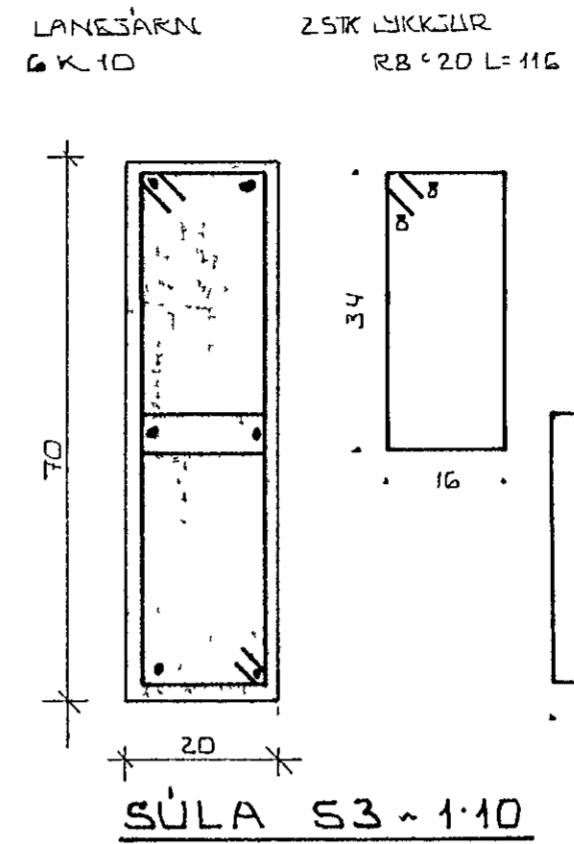



SNID D-D ~ 1:50  
SJA TEIKNARK

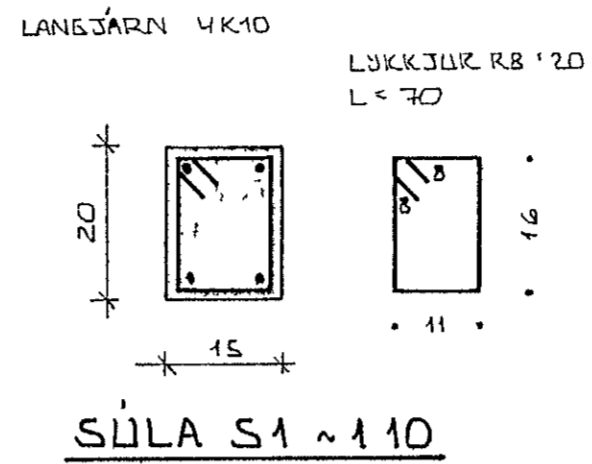


SERMUND I ~ 1:10

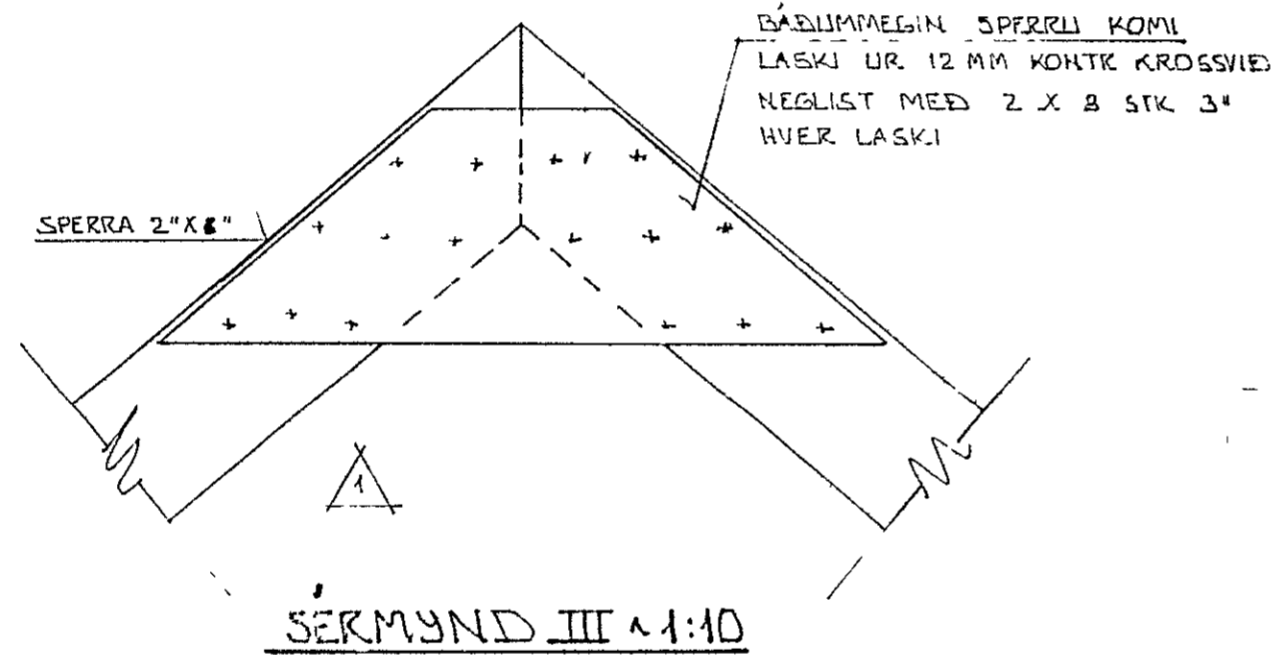


SERMUND III ~ 1:10

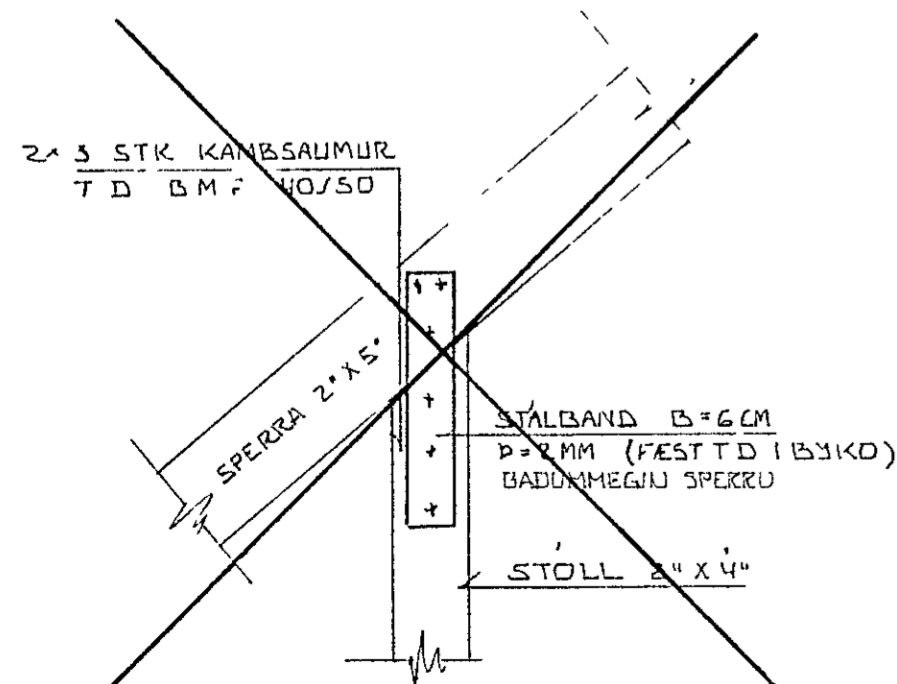

SERMUND II ~ 1:10

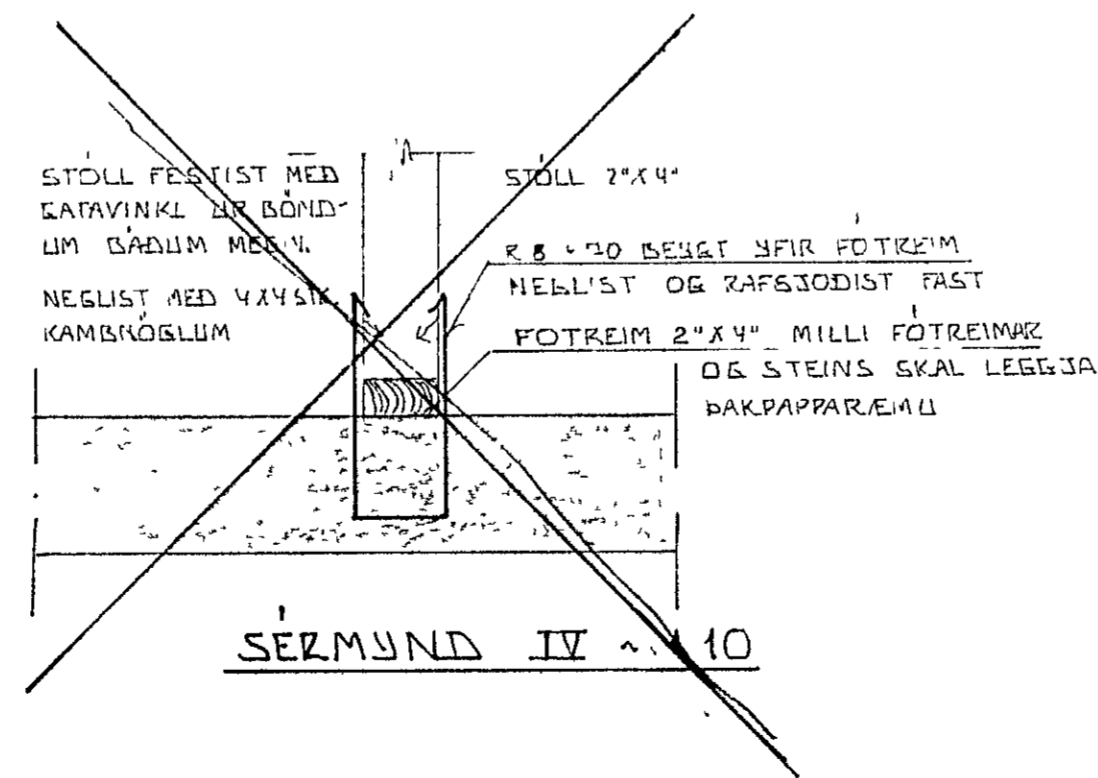

SERMUND IV ~ 1:10

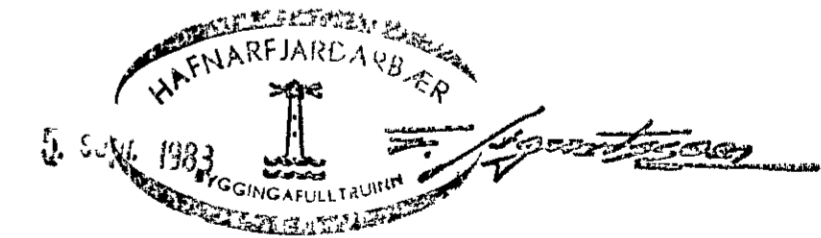

BR NR	DAGS	EDLI BREVINGAR	SIGN
	2. SEPT'83	PAKI FOLFT	
VALLARBARÐ 18 HAFNARFIRÐI			DAGS JAN'83
BURÐARYIRKI - SNID OG SERMUNDIR			HANNAÐ <i>[Signature]</i>
MÆLIKV. ~ 1:50 ~ 1:10			TEIKNAD
SIGURÐUR ÞORLEIFSSON TEKNIFRÆÐINGUR F.T.F.I			VERK NR 8232
STRANDGÖTU 11 HAFNARFIRÐI SIMI 5475119			BLAD NR 06