


NR 10

NR 12

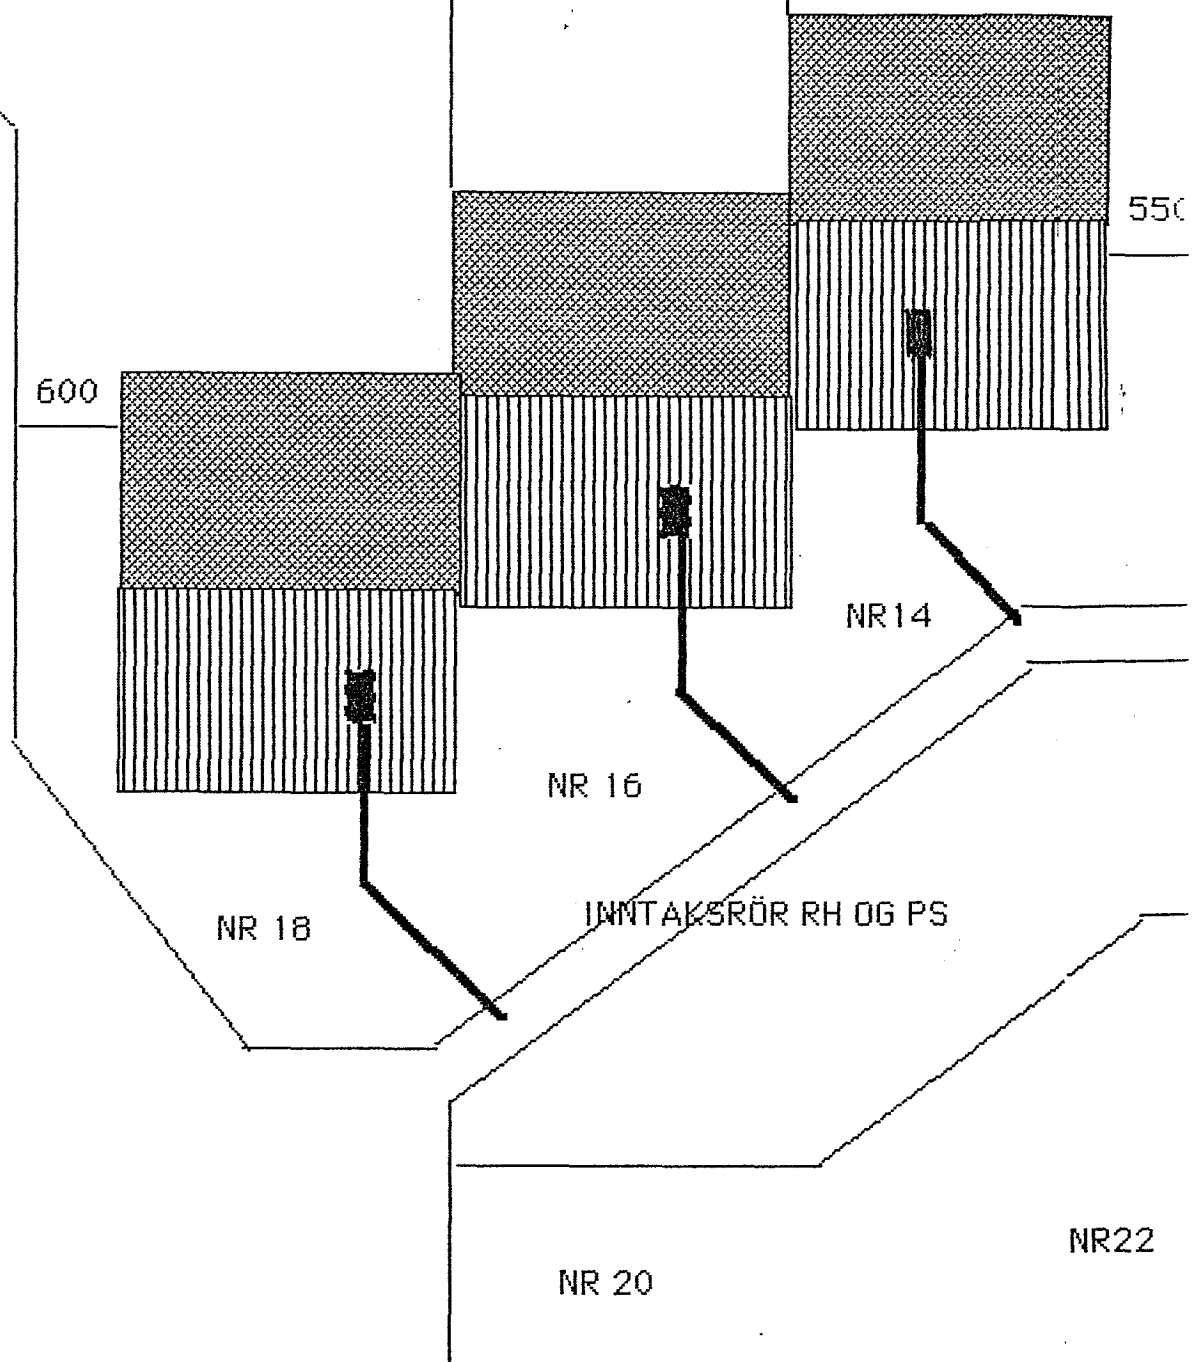

AFSTÖÐUMYND MKV 1:50

LINDARBERG 14-16-18 HAFNAF

SNID OG AFSTÖÐUMYND

TEIÐ

JÓNAS STEFÁNSSON RAFVERKTAKI S-6531993