


SNID A-A Í INNTAK M.1:100

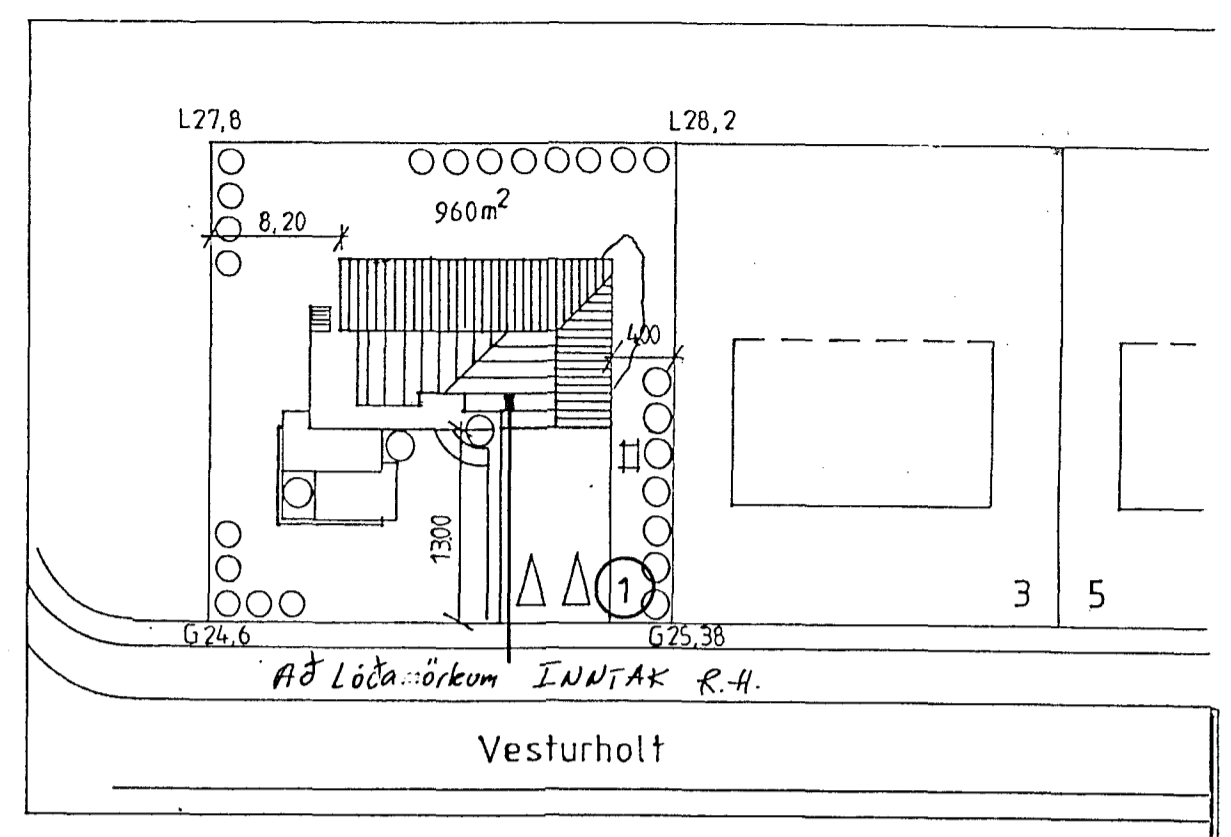


AFSTÖÐUMYND M.1:500

Sambykkt 19.91
VEGNA FULLNADARFRÁBANGS
Alfred Guðmundsson
f.h. Hafsteinn Hafsteinsson


Inntök samþykkt 6.11.1991
f.h. RAFVEITU HAFNARFJARDAR
Albert Muistinnsson

HÚSVEITA TENGIST Á FASA R

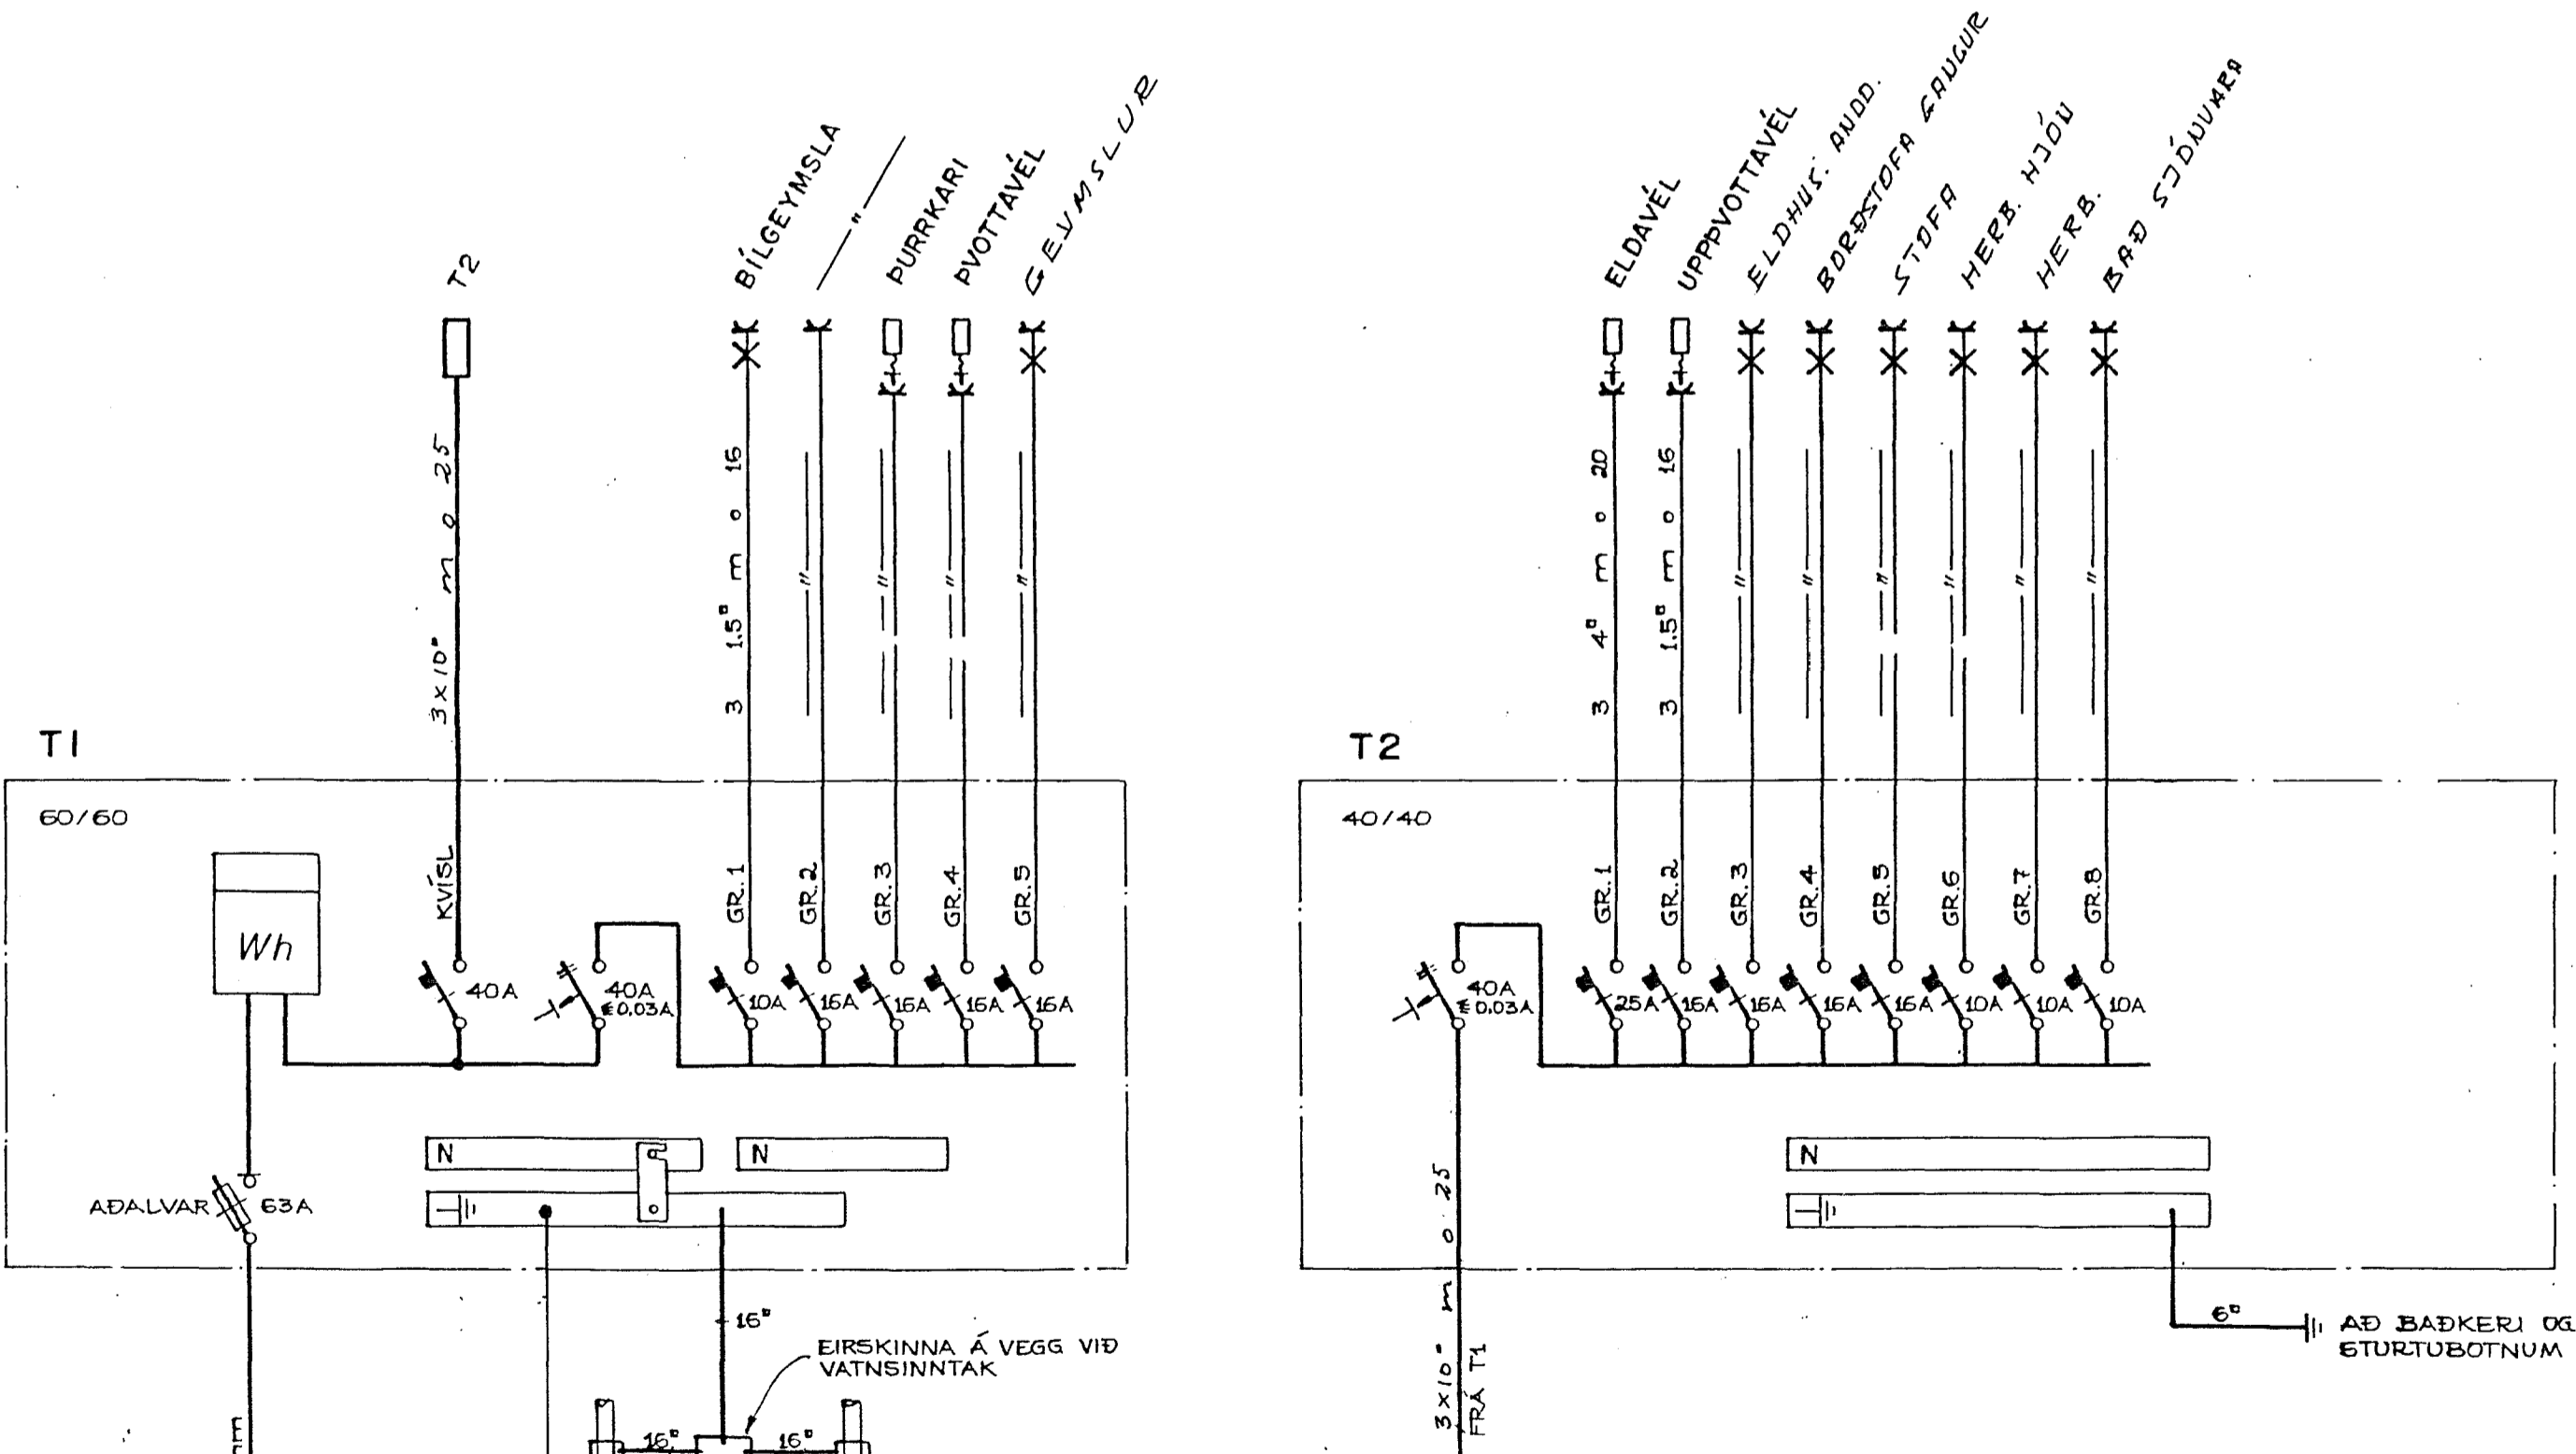

SKÝRINGAR:
LAGNIR ERU HULDAR 16mm PÍPULAGNIR OG TAUGAR 3x1,5².
HÆÐ Á ROFUM SÉ 105sm.
HÆÐ Á TENGLUM SÉ 20sm.
MÁLSTRAUMUR ROFA SÉ 10A, EN TENGLA 16A.
DS= DYRASÍMI, F= BÆJARSÍMI, L= LOFTNET.

TEIKNING NR. 2982

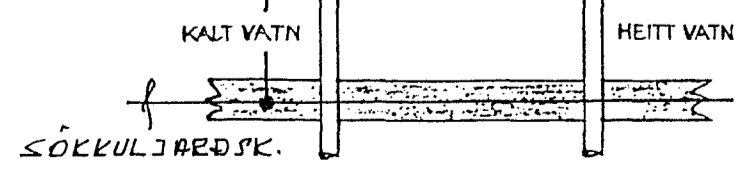

UTG.	DAGS.	VINNUTEIKNING	T.S.	T.S.	<i>Trausti Sævi-Þorsteinsson</i>
A	'89.11.01	VINNUTEIKNING	T.S.	T.S.	<i>Trausti Sævi-Þorsteinsson</i>
UTG.	DAGS.		TEIKN.	HANNAÐ	SAMÞYKKT

VESTURHOLT 1 HAFNARFJRDÍ
AFSTÖÐUMYND, SNID A-A Í INNTAK,
EINLÍNUMYNDIR OG SKÝRINGAR.

TERA RAFMAGNSVERKFRÆDISTOFA
 TRAUÐI SVEINBJORNSSON RAFM IDNFR SÍMI 887390
 EDMUND BELLERSEN RAFM TEKNFR SÍMI 887385
 RAGNAR D. STEFANSSON RAFM VERKFR SÍMI 887835
 AGUST ÞORHALLSSON RAFM VERKFR SÍMI 887805

MKV.	1:500; 1:100; 7.	
TEIKN NR.	1	
NÆSTA TEIKN NR.	2	
VERKNR.		
BL.	1	AF 3
UTG.	A	
GÆMMSLURNR.		