


*dýrlífa forlaga*

*Sammenne 70x120  
63m sumu KHZ 200.  
140m ud.*

*Kalle us Bullen*

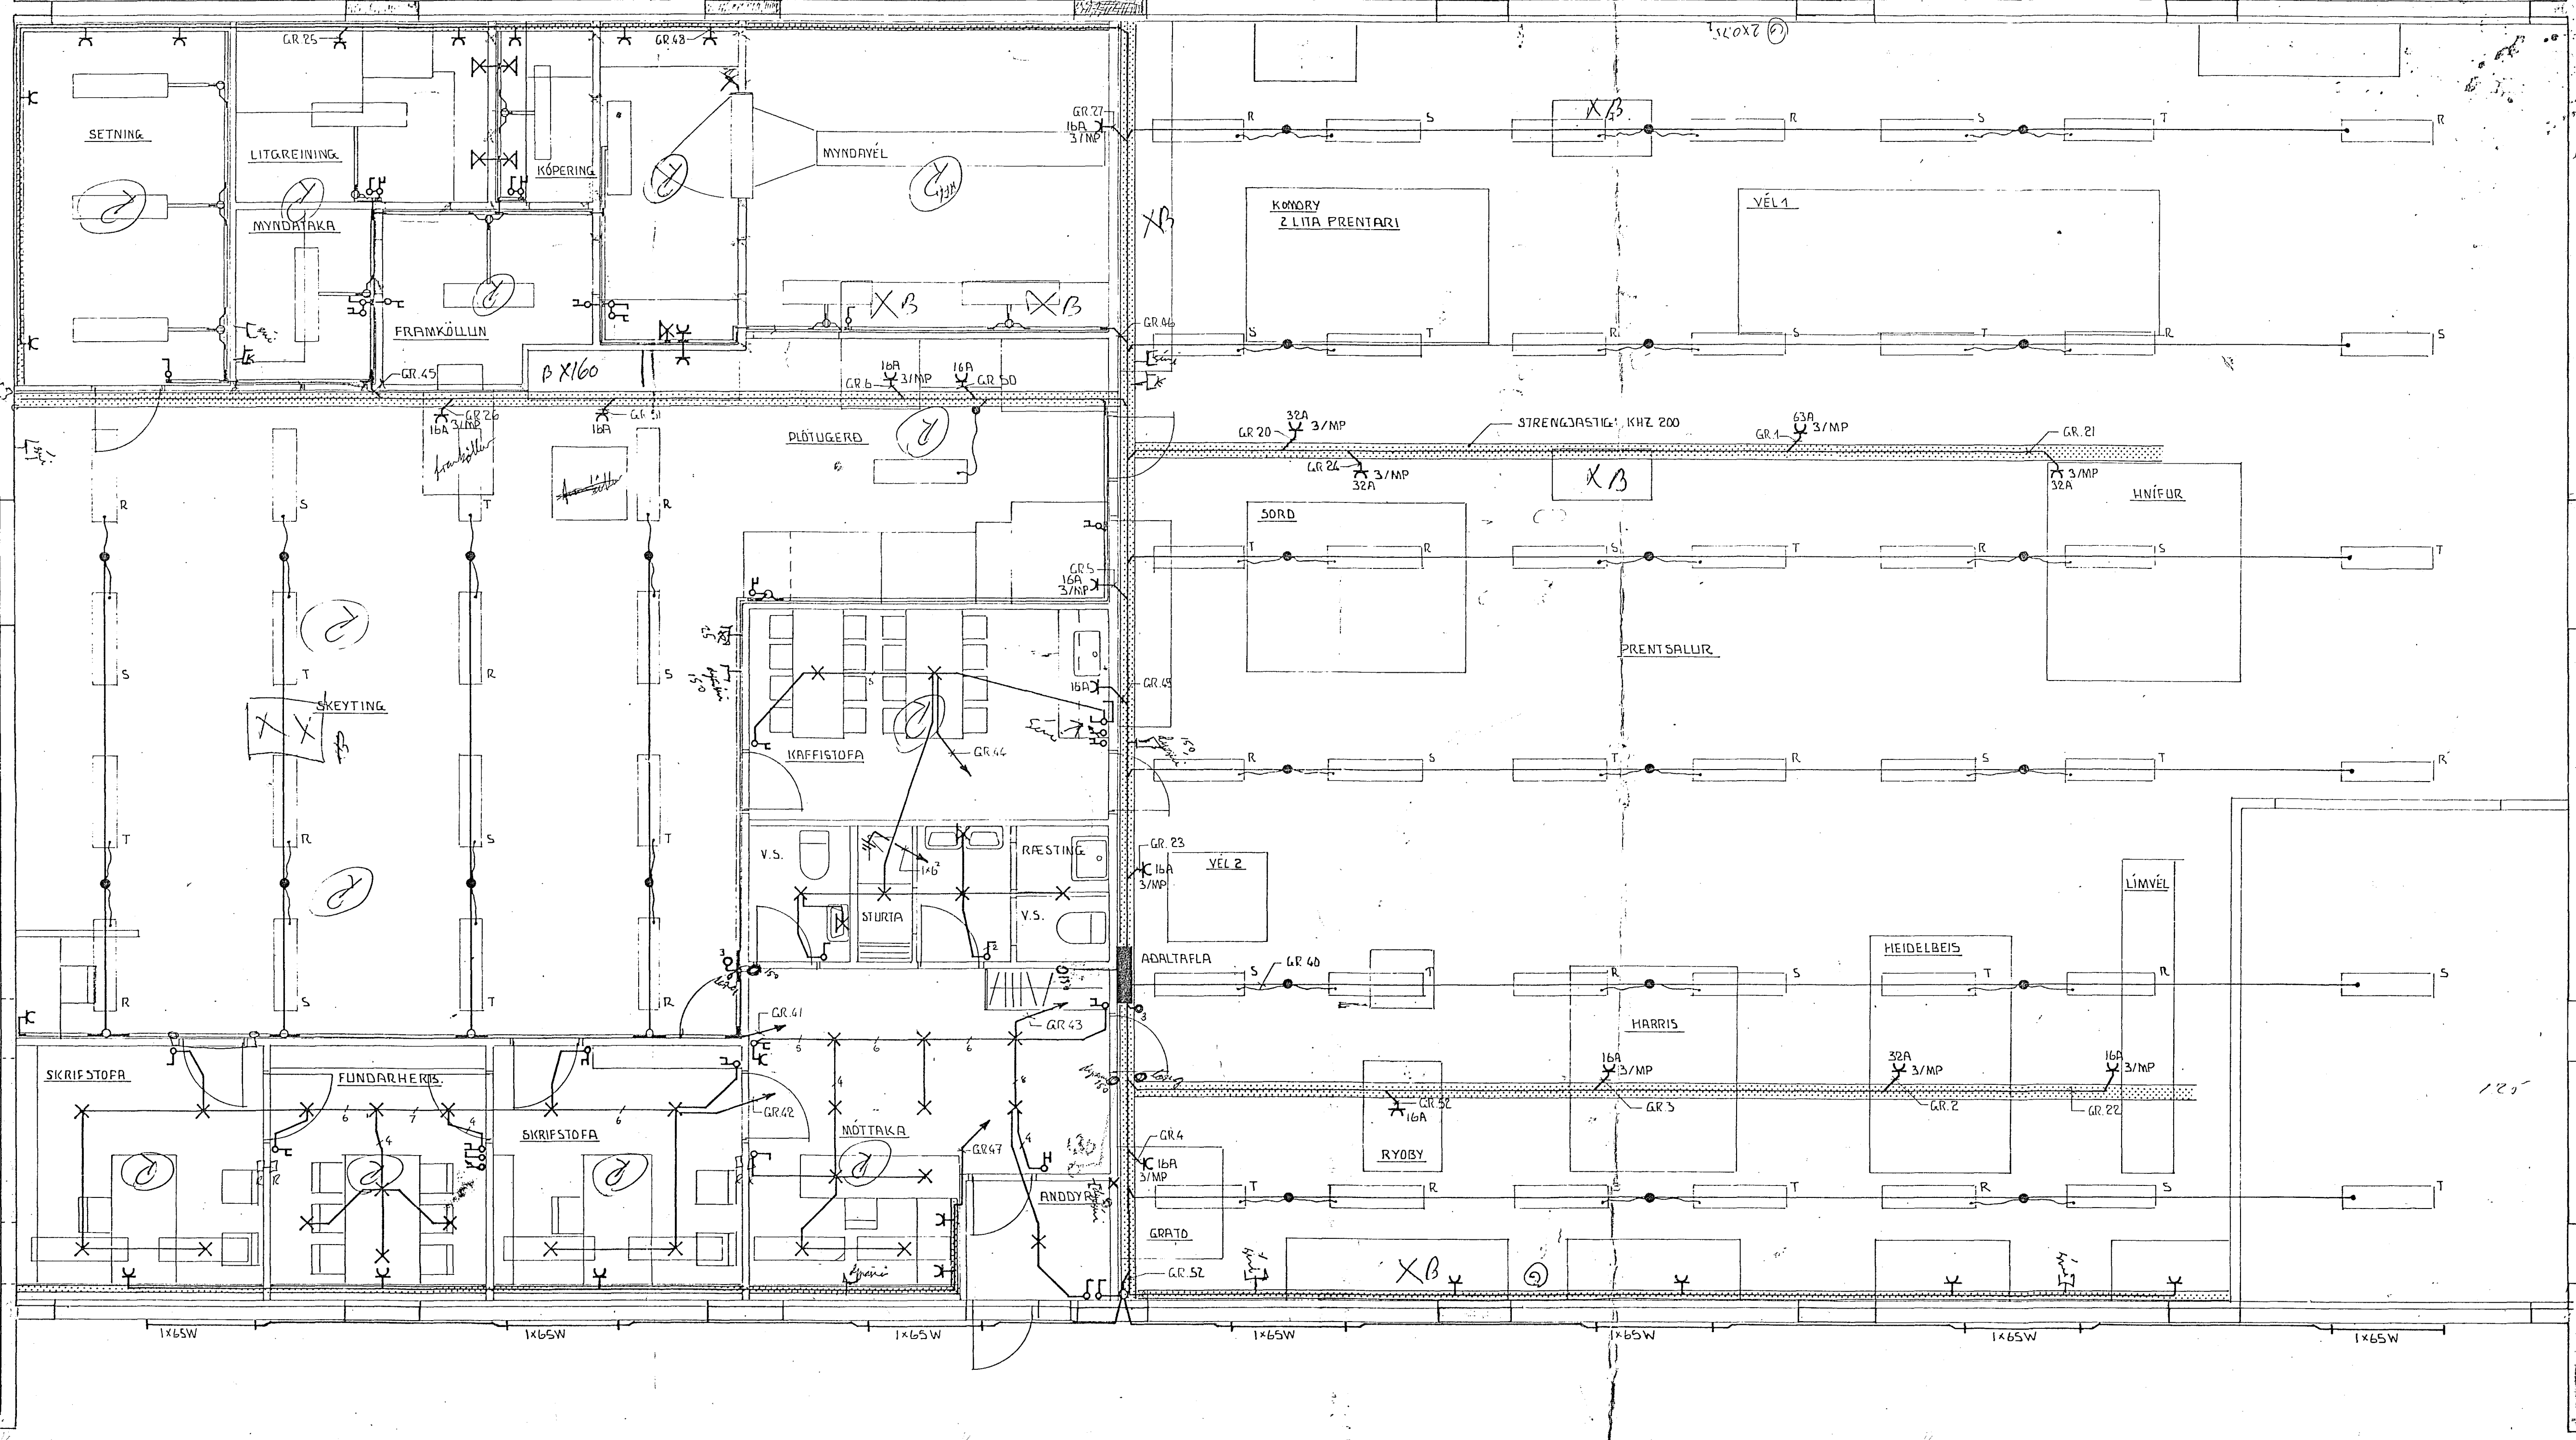

BR. DAGS		BREYTING		BÆJARHAUN 24 HAFNARF.	
				PRISMA 1.ÁFANGI	
				GRUNNMYND	
				RAFLDGN	
TÆKNIJÓNUSTAN SF.				HÁNNAD PÍK	KVAÐI 1:50
LÁGMÓLA 5 - 105 REYKJAVÍK - Sími 83844				TEIKNAD.ÁK	DAGS. MÁI '85
<i>Sig. L. Óðmúen</i>				YFIRFARID	Nr. BL. 2/5
				AF.	