



HÆÐ

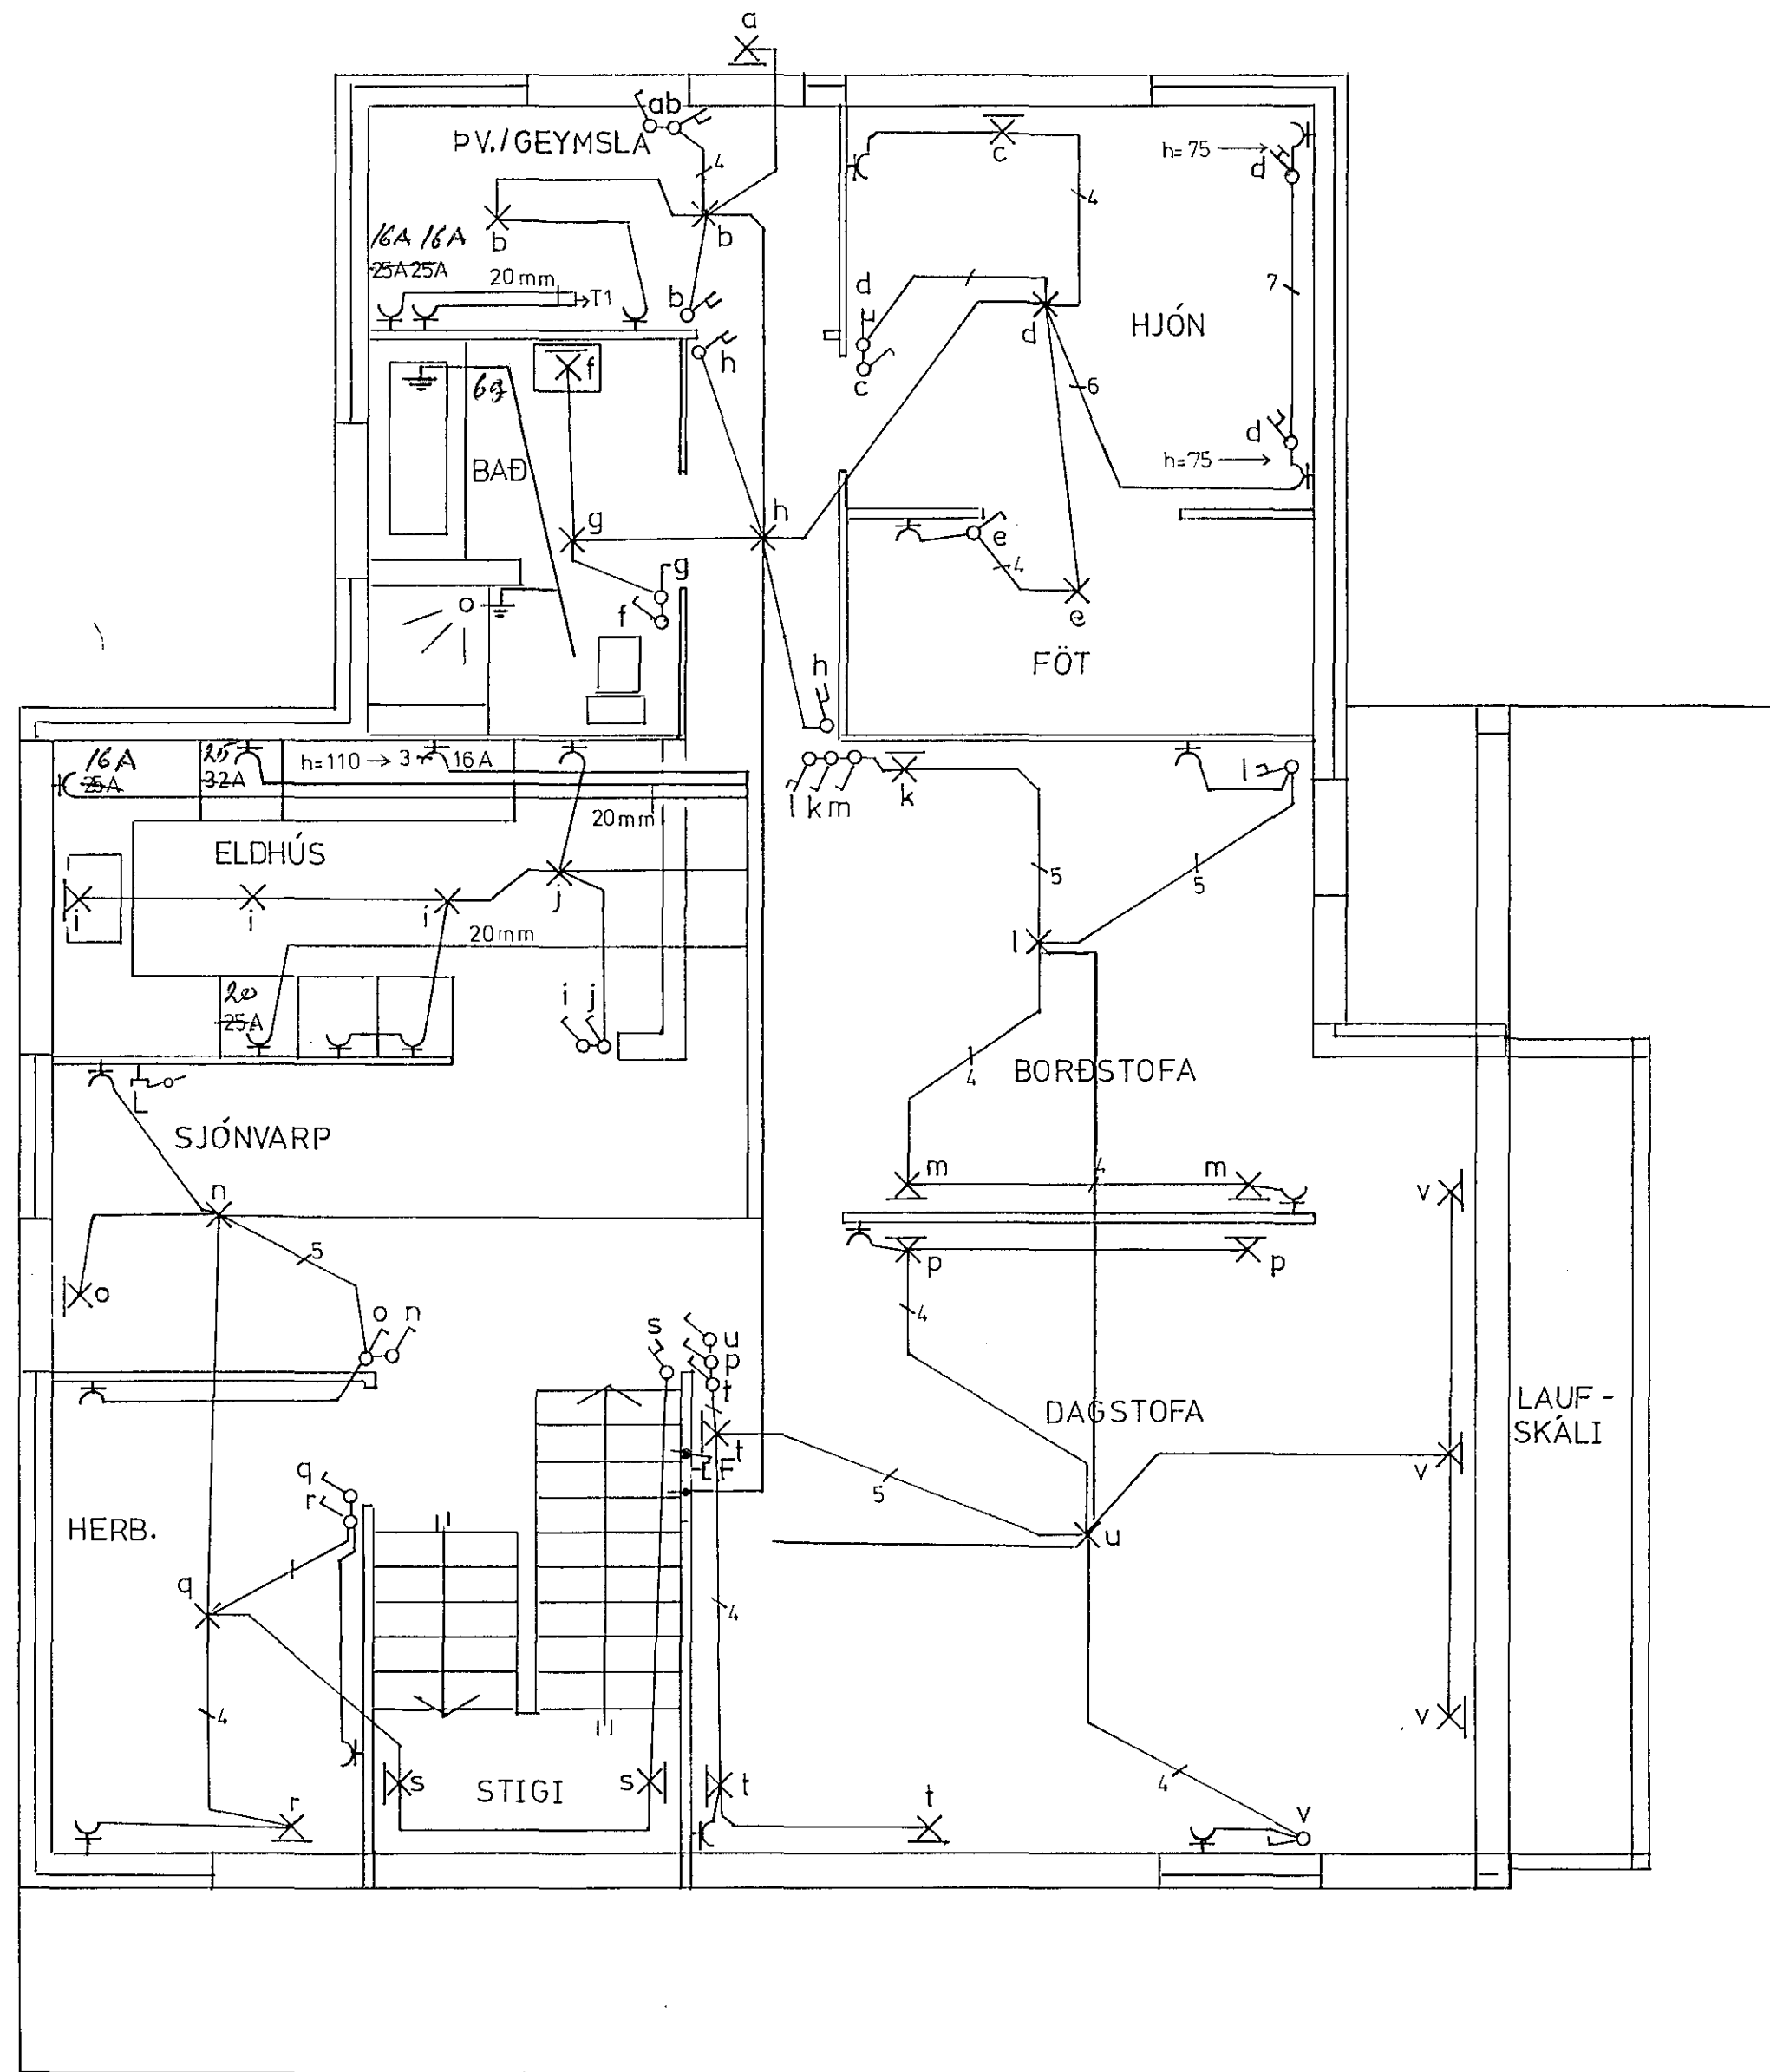

KJALLARI

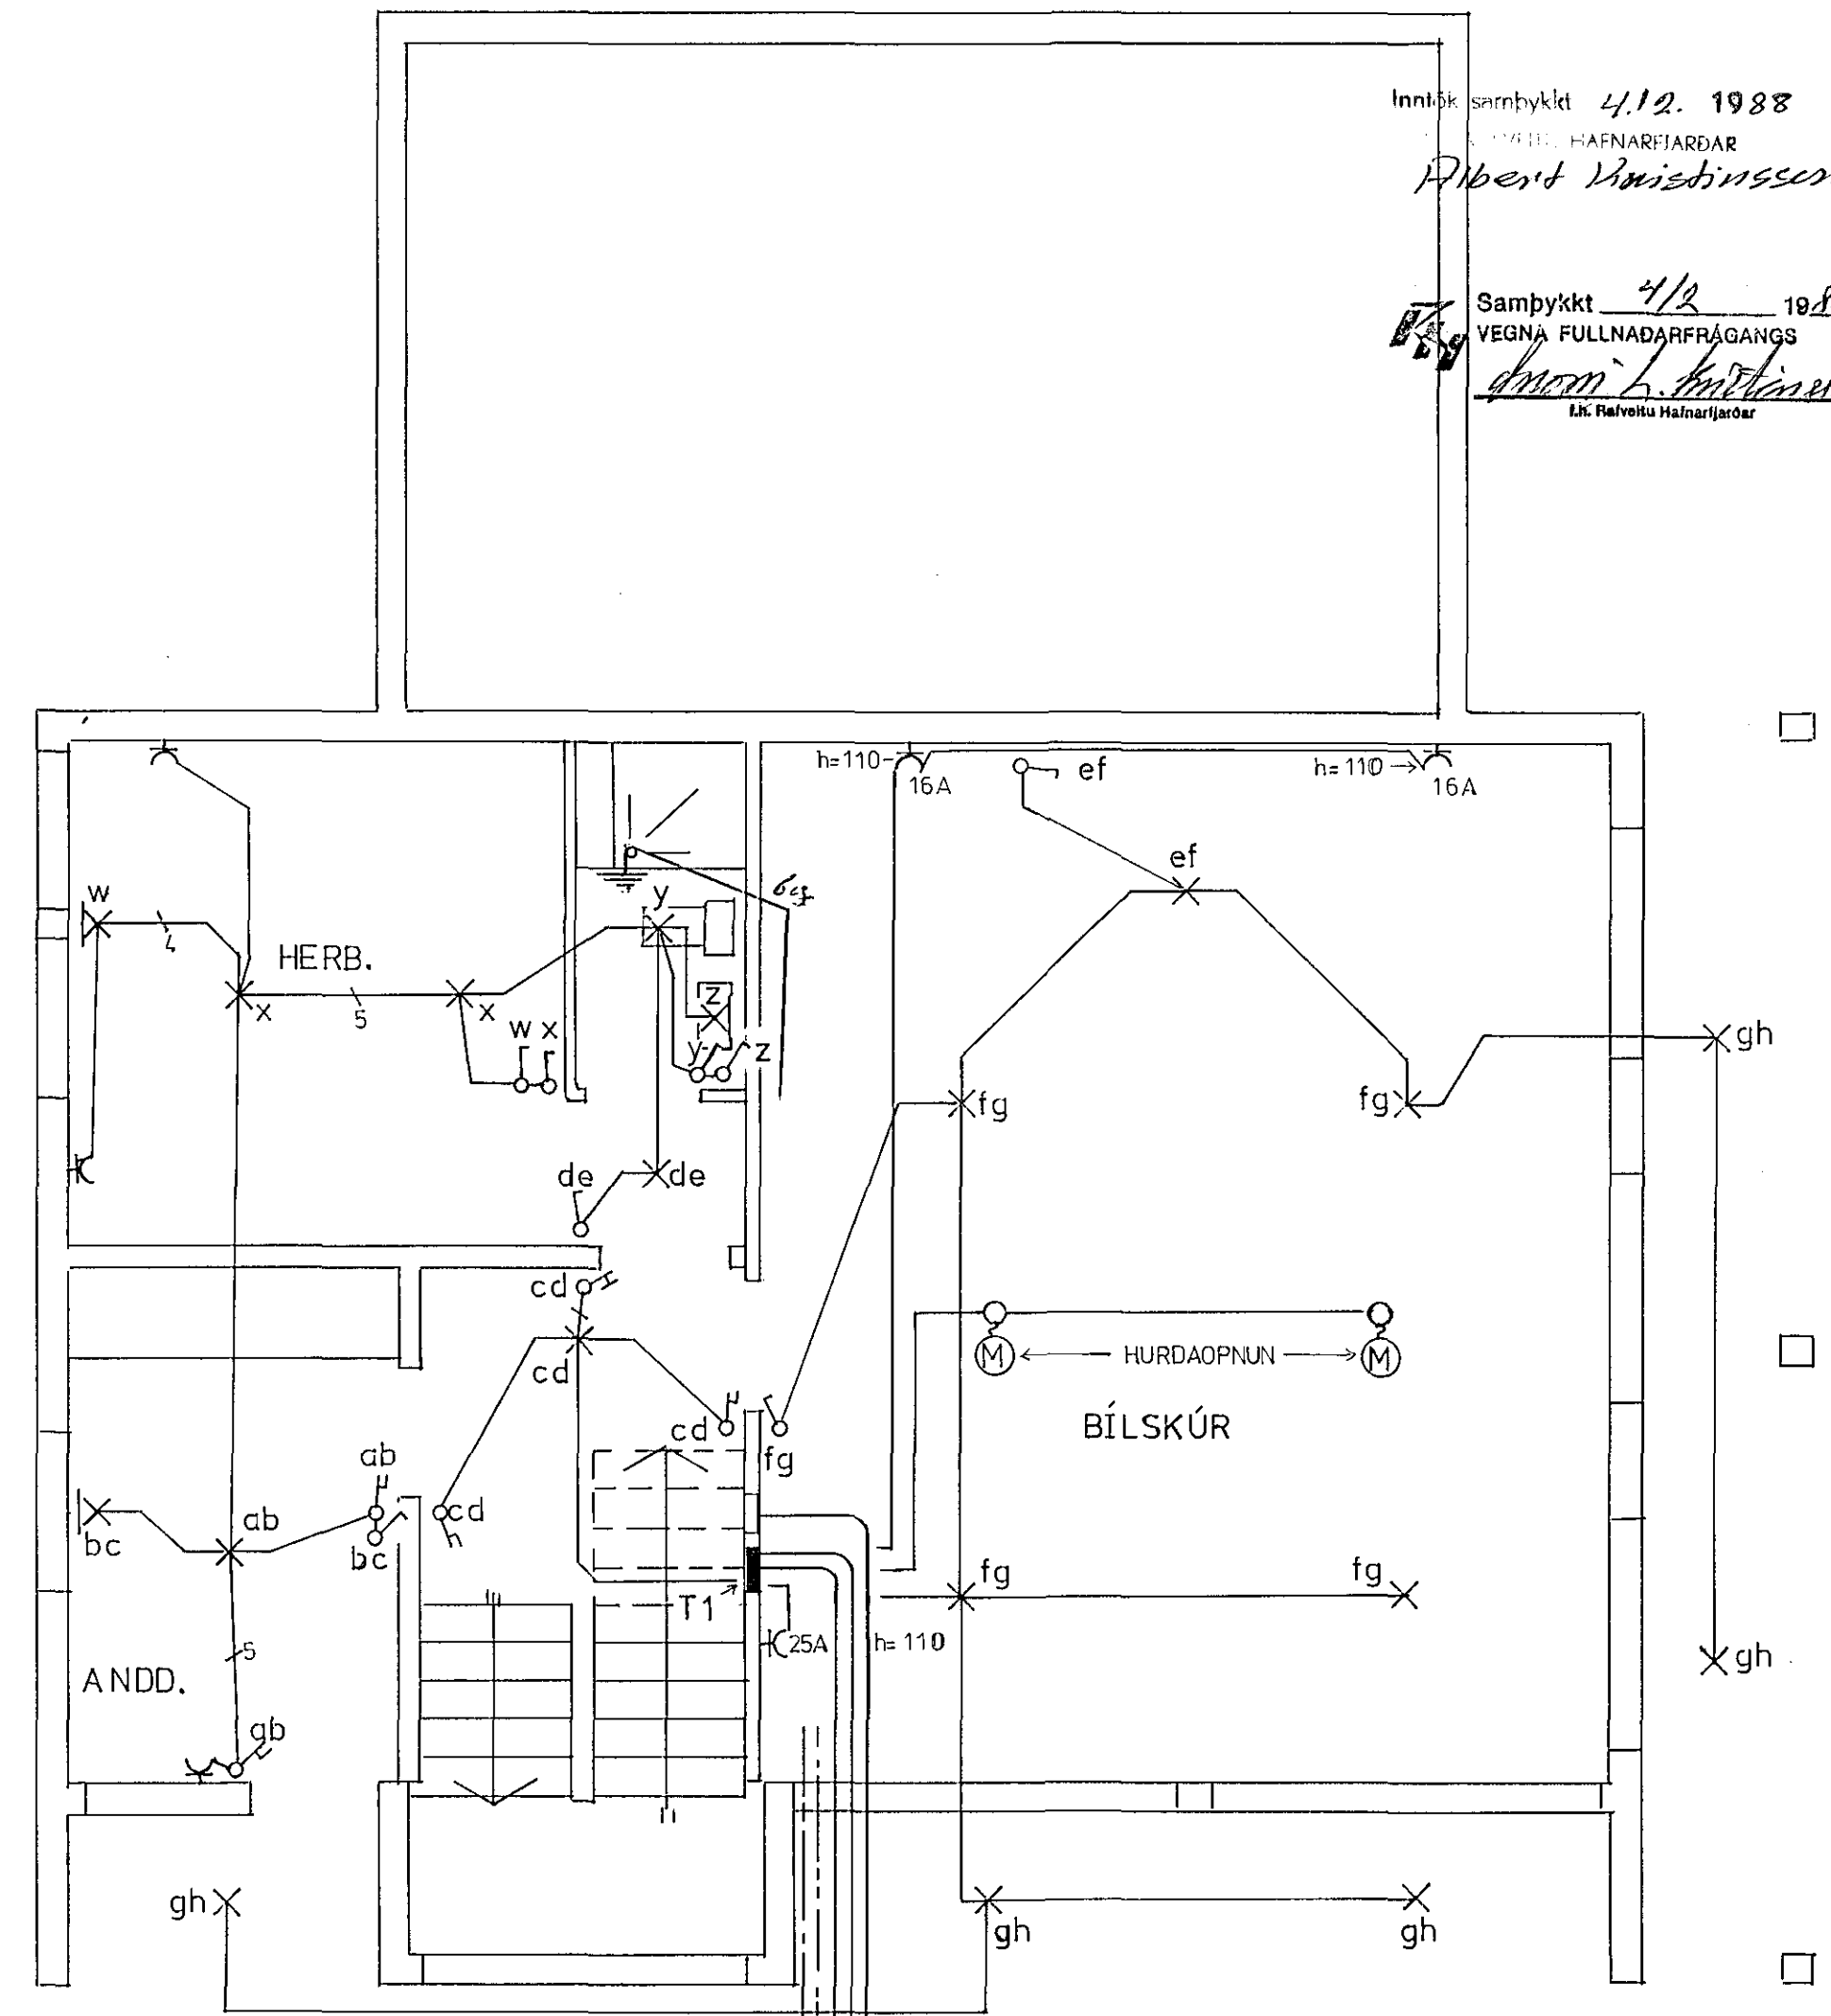

Inntök samþykkt 4.12. 1988
 HAFNARFIJARDAR
 Albert Þorsteinsson

Samþykkt 4/2 1988
 VEGNA FULLNADARFRÁGANGS
 Gunnar L. Þorsteinsson

VATNSINNTAK →
 HITAVINNTAK →
 50 MM PLP RH
 25 MM PLP ÚTILÝSING
 25 MM PLP SÍMI
 50

TEIKNING NR. 2548

	GUDM. BRAGI TORFASON	RAFM.IDNFR.	T JULI 87
	VÍDIVANGI 10 HAFNARFIRÐI	S 53479	U
	HRAUNBRÚN 4 HAFNARFIRÐI		M=1 50
	RAFLÖGN HÆÐ OG KJALLARI		BL 1 AF 2