


Snid A-A 1:100

HÖSVEITA TENGIST A FI-PAc 1

lentið samþykkt 1916 1937.  
 f.h. RAFVEITU HÁLFARJARDAR  
 Hörður Hallgrímsson

Afstöðumynd 1:500

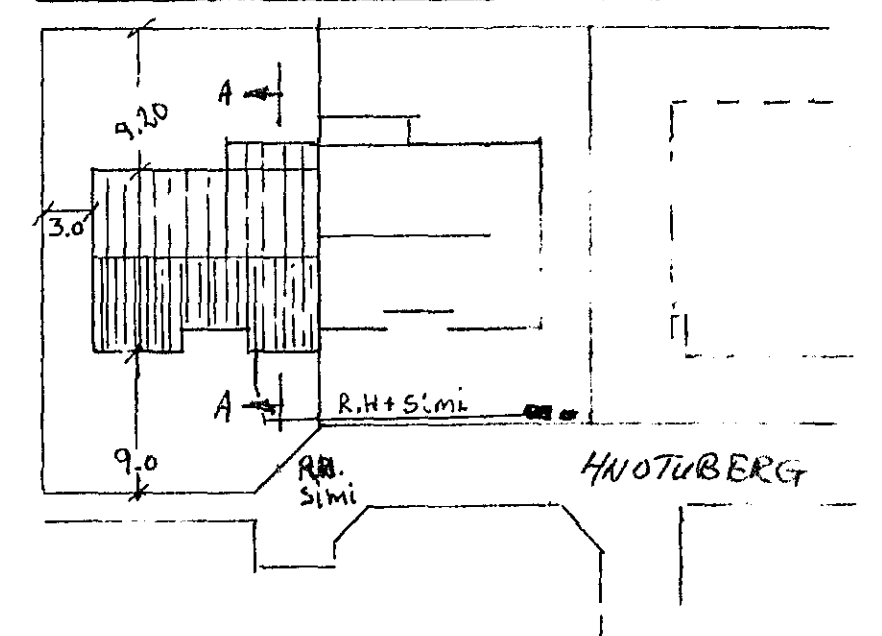

TEIKNING NR. 2491.8

|                             |             |               |
|-----------------------------|-------------|---------------|
| <b>ERGE</b> S.F. LÁGABERG I |             |               |
| BREYTINGAR                  | Hnotuberg 7 | MÁL           |
|                             | Raflögn     | BLAD 1 AF 2   |
|                             |             | DAGS. 6.11.37 |