


Húsvéita nr. 3150 Teikning nr. 2412  
 Samþykkt þ. 12. 12. 1985  
 f.h. RAEVEITU HAFNARFJARDAR  
*Jóns Guðsson.*  
 Eftirlitsmaður rafslagna

Ímáttik samþykkt 11.12. 1985  
 f.h. RAEVEITU HAFNARFJARDAR  
*Filbert Kristjánsson*

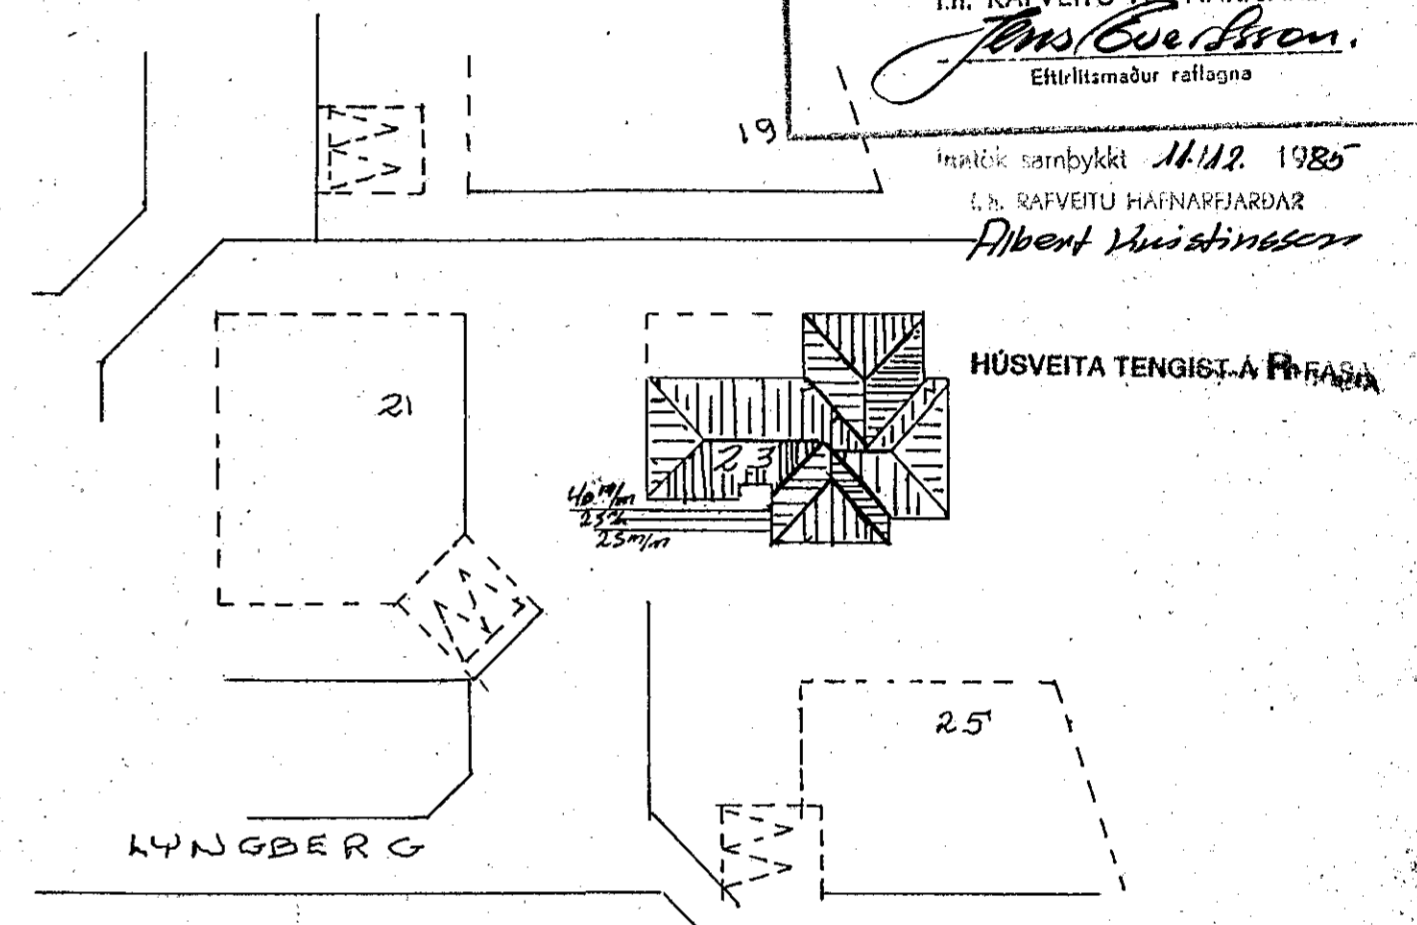

AFSTÖÐUMYND, M = 1:500.

Skýringar.

hagnir eru huldar 16mm pípuhagnir.  
 og taugar 3 x 1,5<sup>0</sup>  
 Hæð rofa sé 105 sm  
 Hæð tengla sé 20 sm  
 Málstraumur rofa sé 10A og tengla 16A

Nema annars sé  
 setið.

2413 x

<b>LYNGBERG 23.</b>		Mkv 1:50
Teiknad	Pétur Sveinsson	Dags 4/12 '85
Hannad		Sími 53363