




BITI B1 1:50 1STK

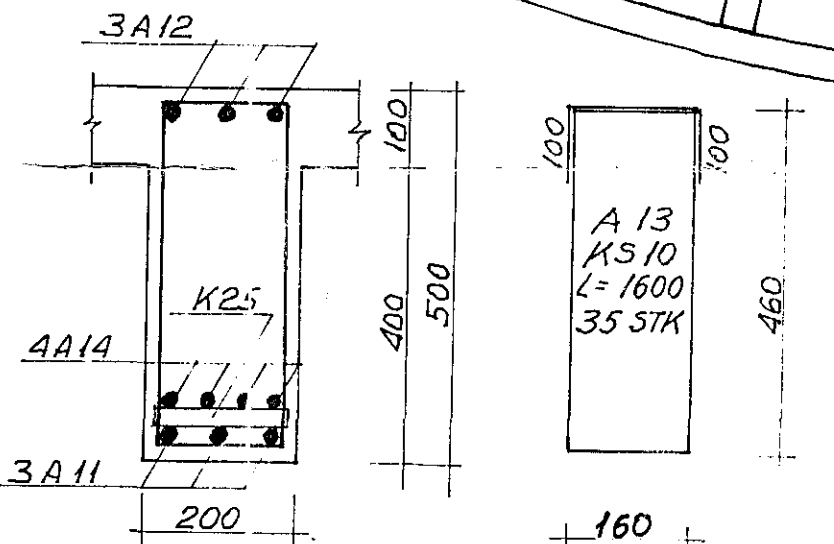


SNID B1-B1 1:10

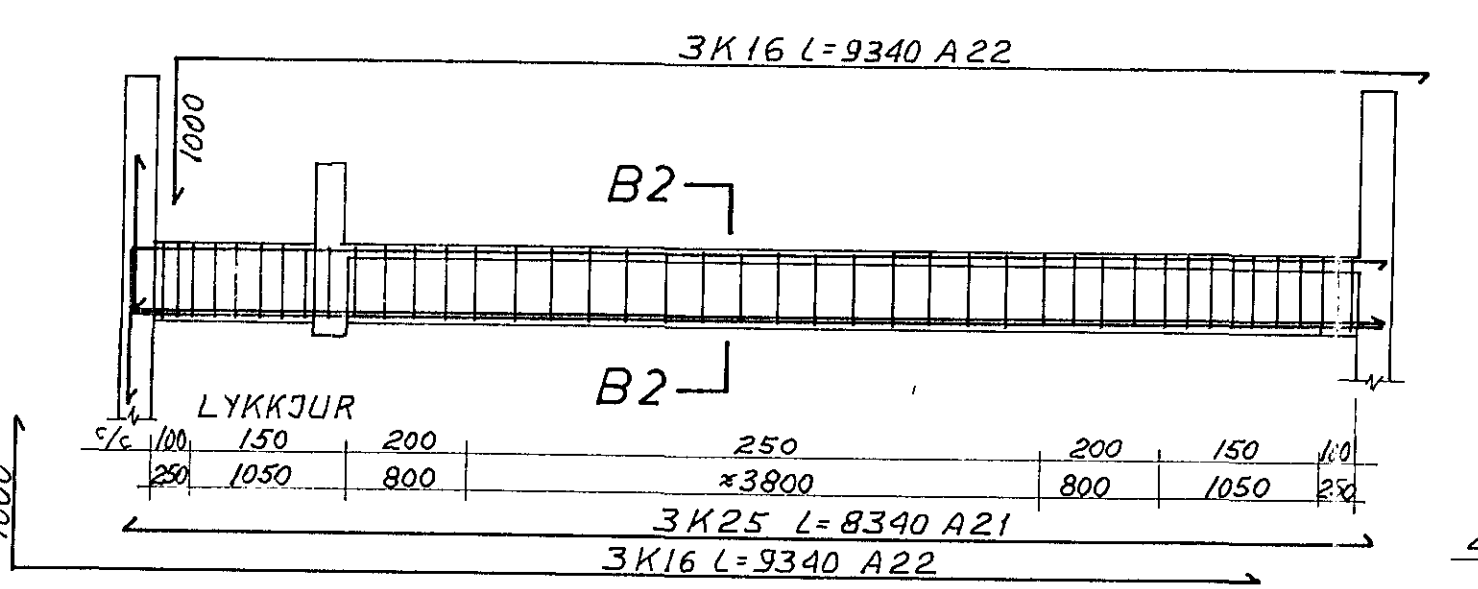


BITI B2 1:50 1STK

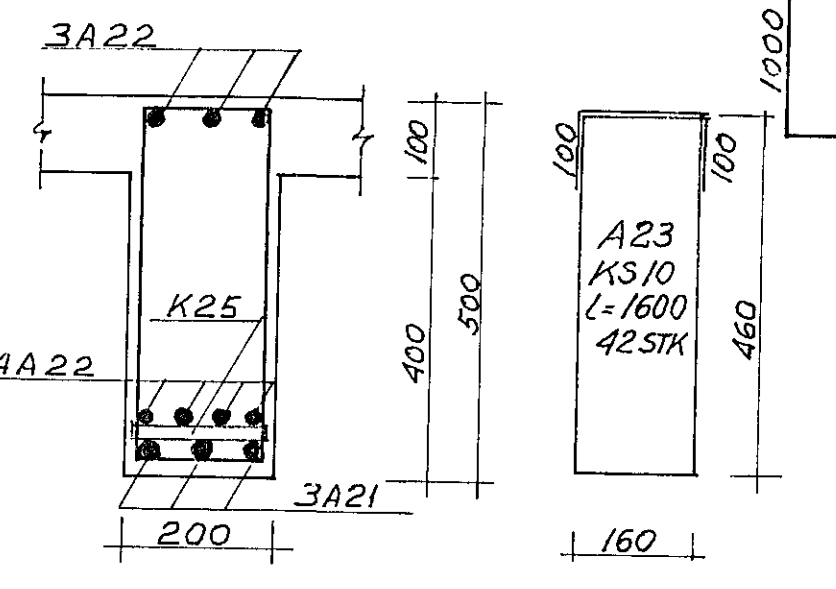


SNID B2-B2 1:10

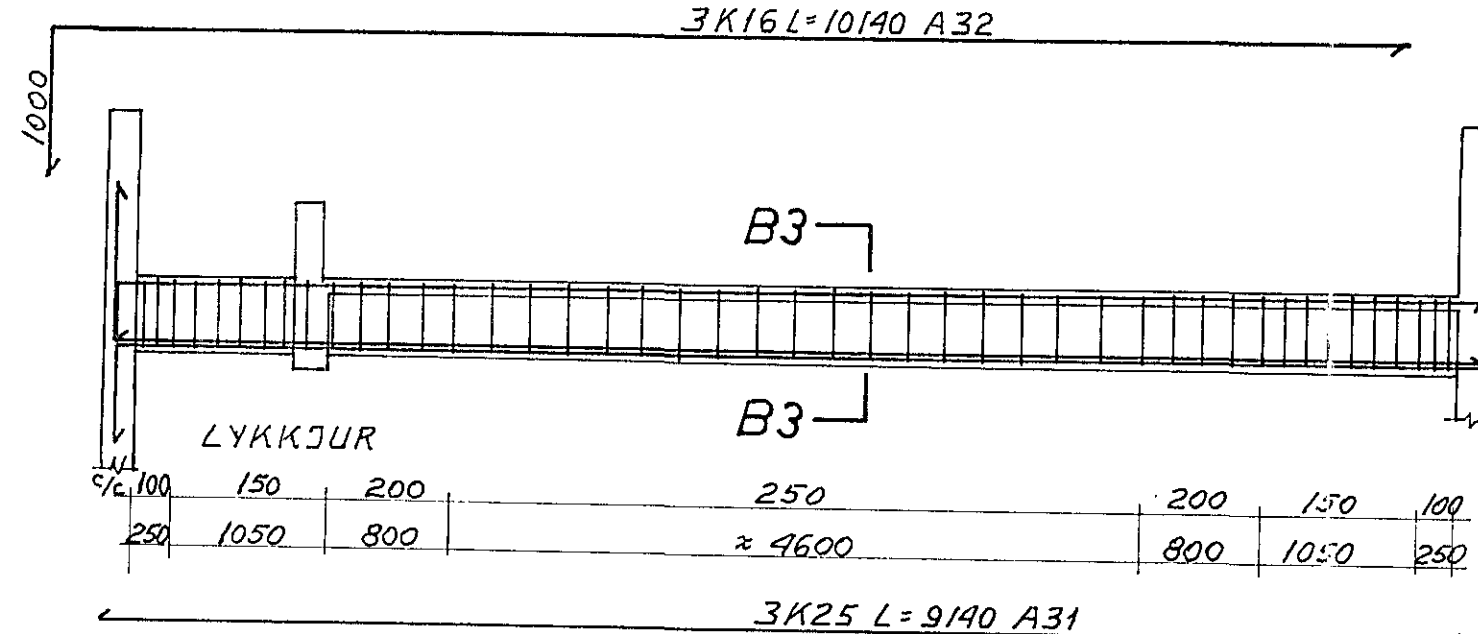


BITI B3 1:50 1STK

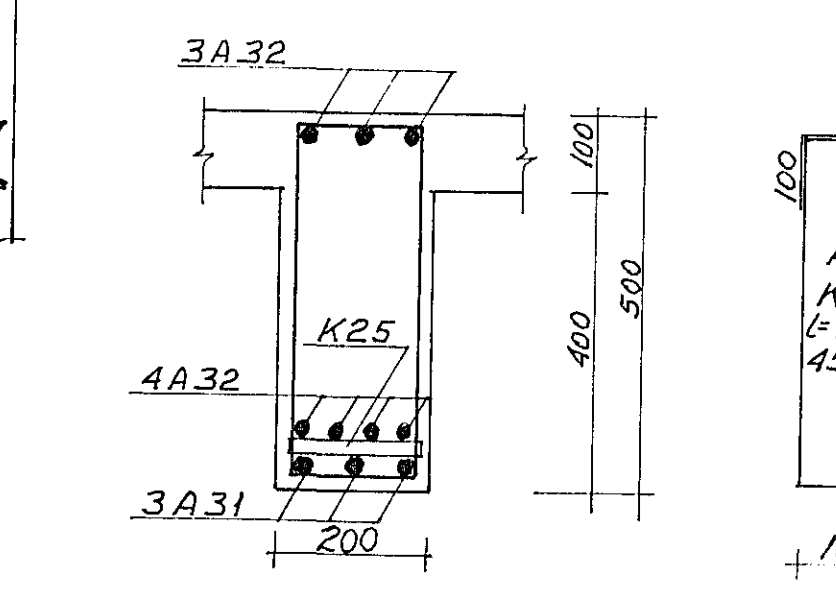


SNID B3-B3 1:10

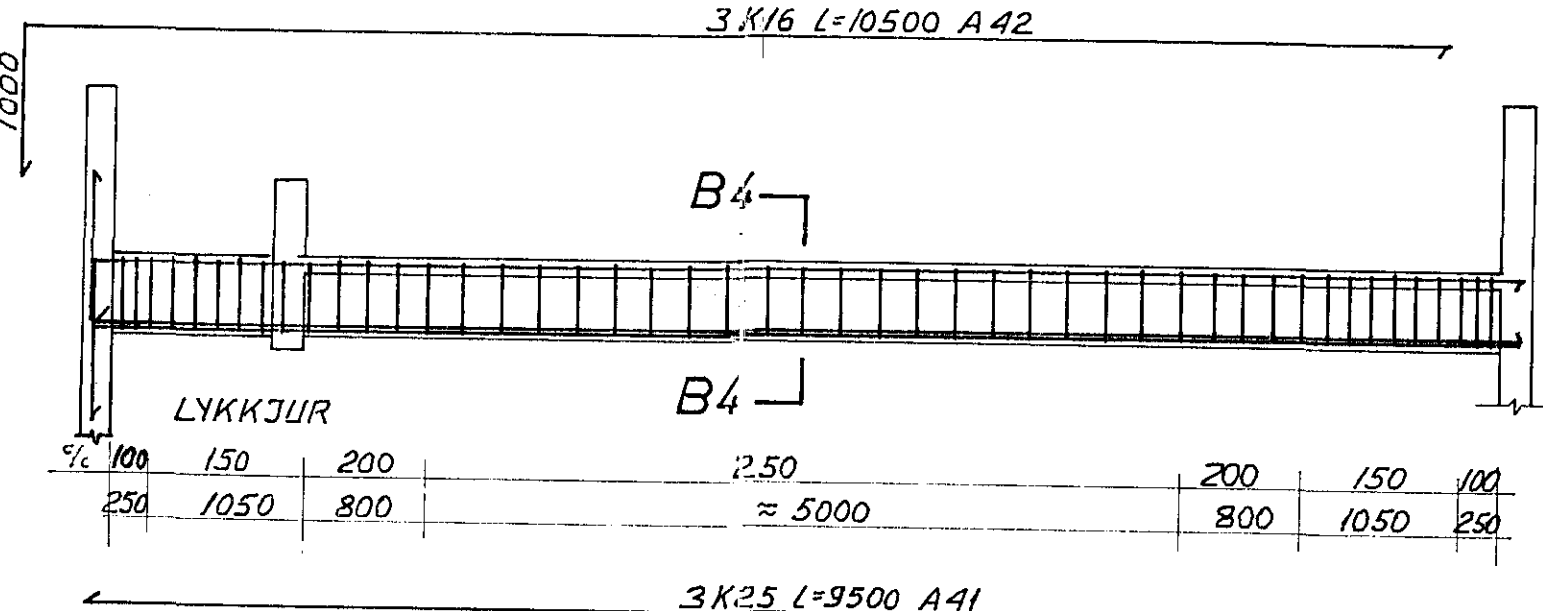


BITI B4 1:50 1STK

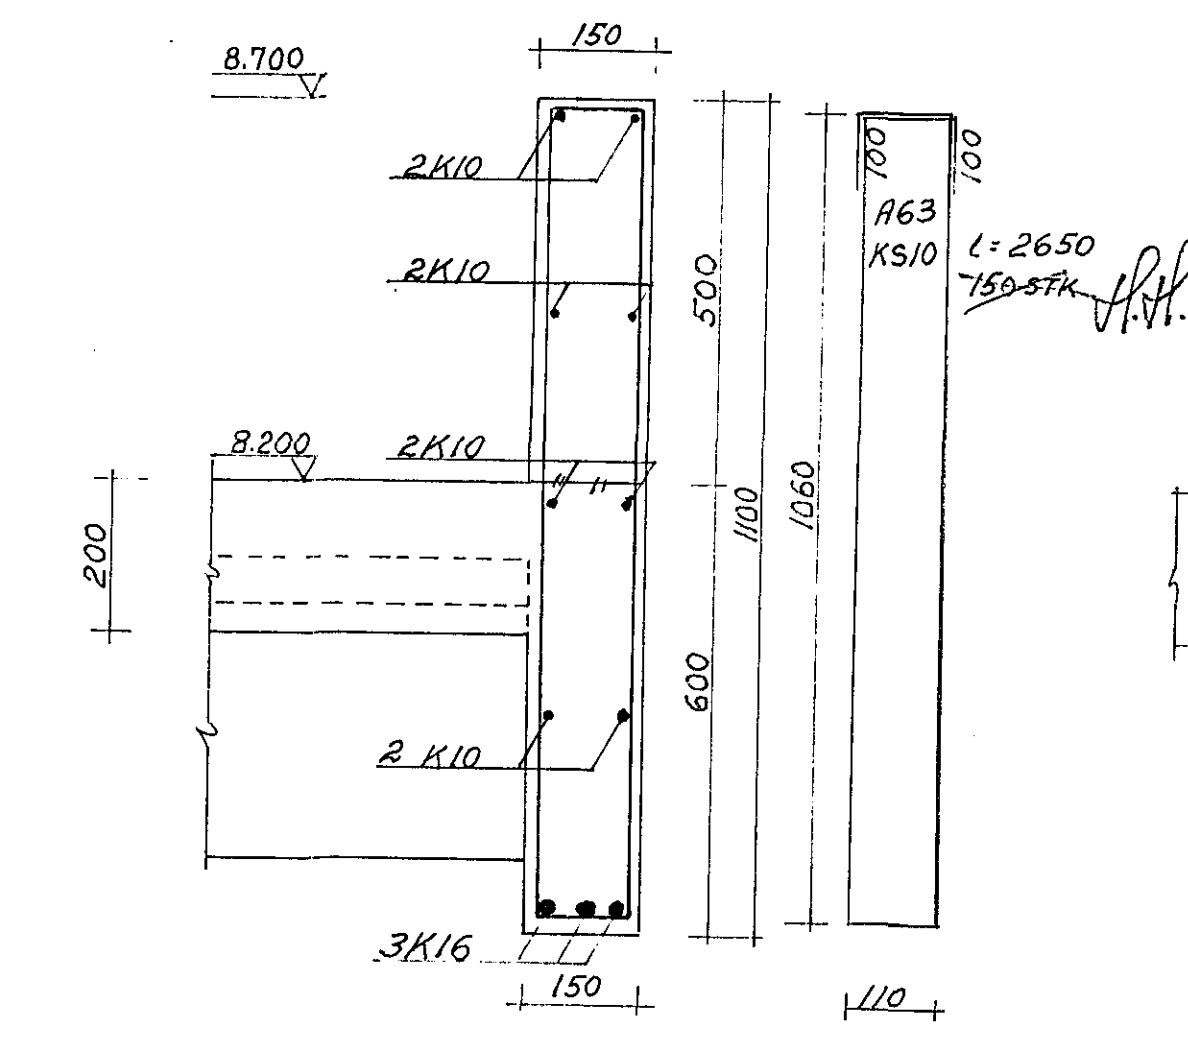


SNID B4-B4 1:10

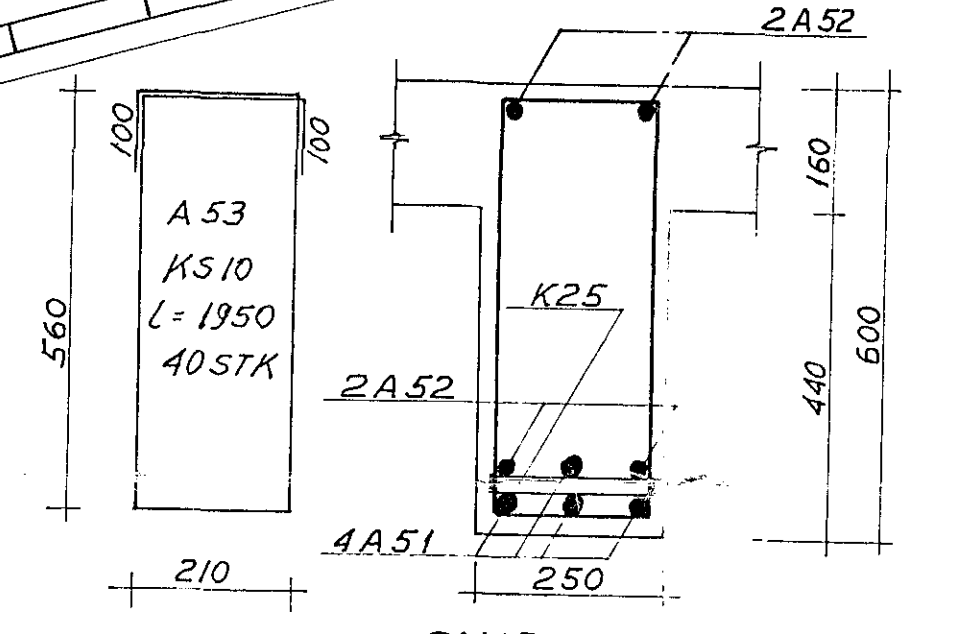

SNID B5-B5 1:10

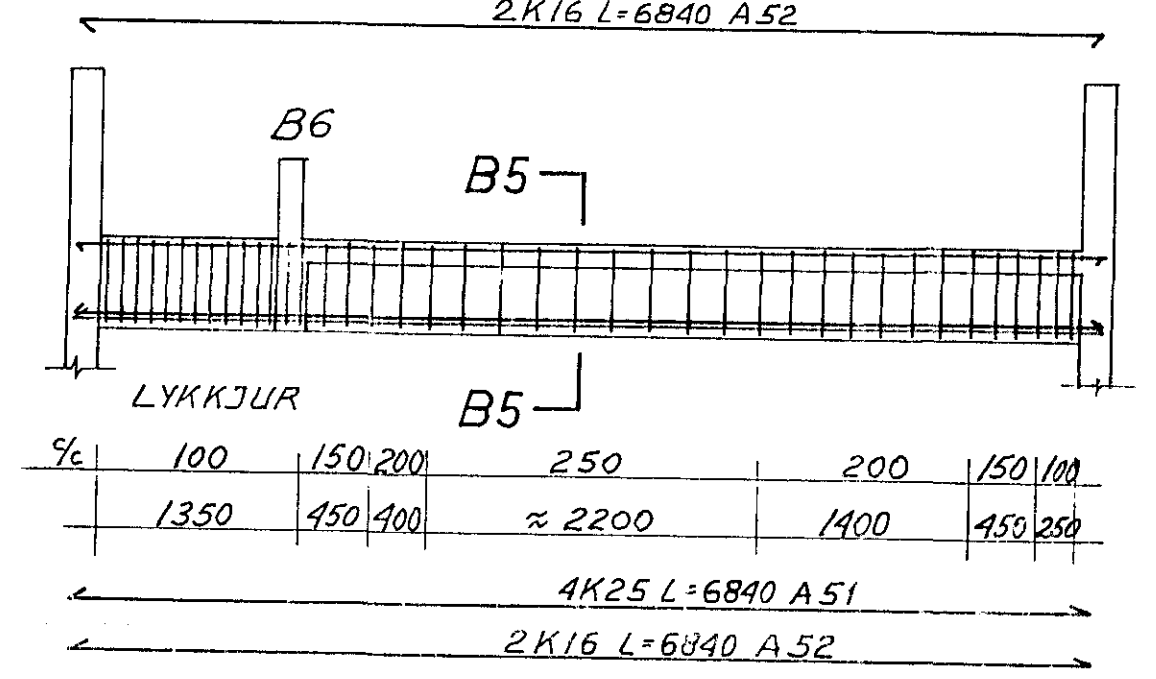

BITI B5 1:50 1STK

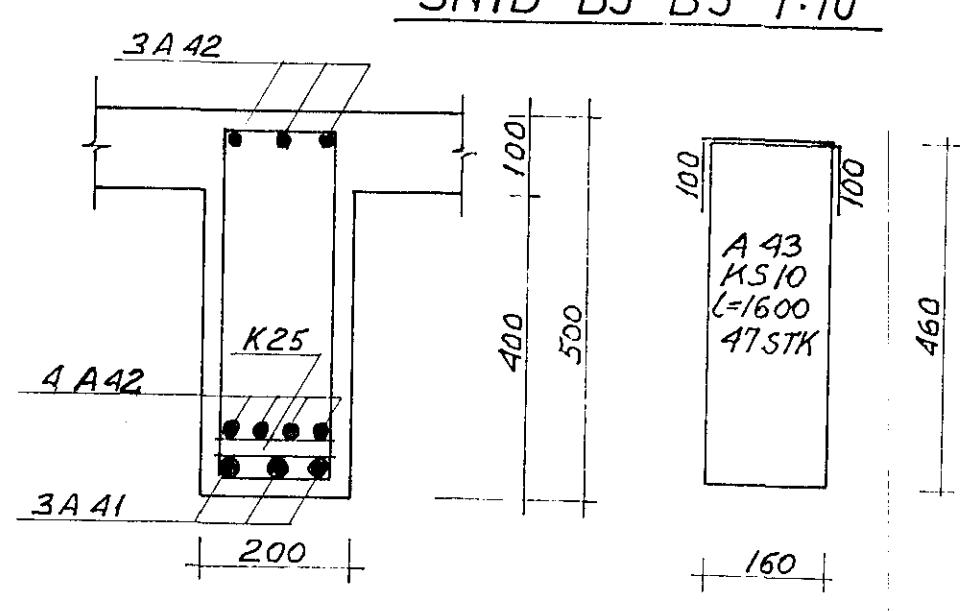


SNID B6-B6 1:10

BITNJARN BITA B6 (3K16) LEGGI ST
OFNNA BITNJARN BITA B5 PAR SEY.
BEIR KOMA SAMAN I MALLINU 5.

ÁSKILIÐ, ELÐRI
TEIKNING ÓGILD



SAFNADARHEIMILI OG
TÓNLISTARSKÓLI VÍÐ
HAFNARFJARDARKIRKJU

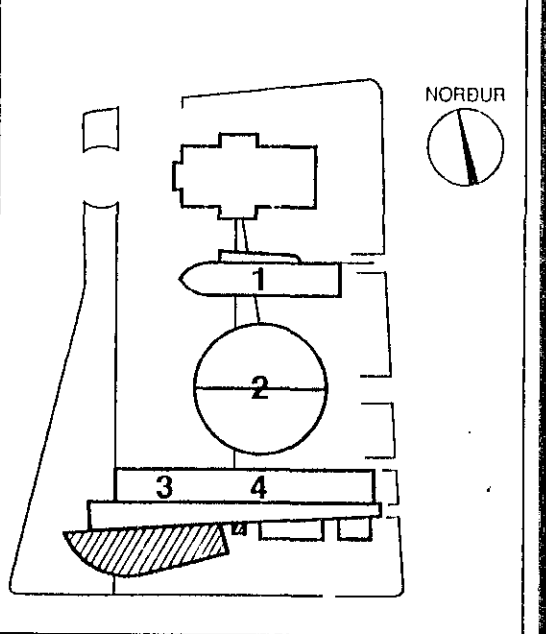

BREYTT BITA B6 SEPT. '93

VERKFRÆDISTOFA HALLDÓRS HANNESSONAR S. 91-54355
BÆJARHRAUNI 20 - HAFNARFJÖRÐUR

TÓNLISTARSKÓLI
ÞAKPLATA YFIR SAMPILS- OG
LÚDRASVEITARHÚSI OG LYFTU

Mkv: 1:10, 1:50
Reiknað: [Signature]
Teiknað: [Signature]
Yfirlitað: [Signature]

Verk: Blað nr. 33 Dags: MA 1 '92