



lantök samþykkt 26/10 1977
 9b, RAFLÖGN HAFNARFIRÐAR
 Hólder Hallgrímsson

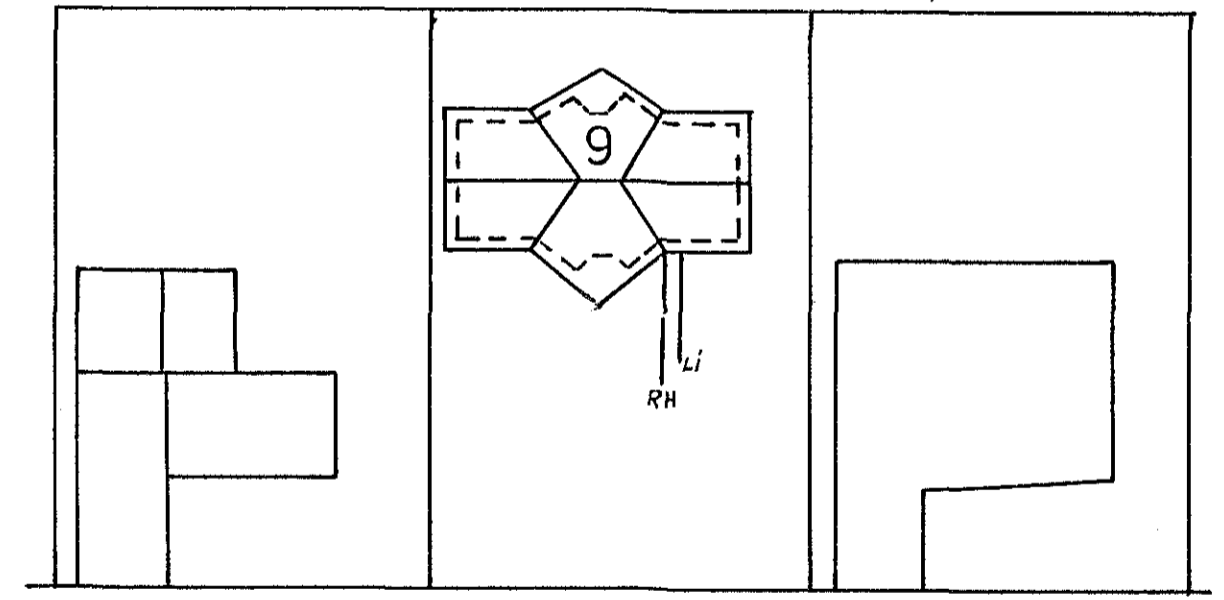

sævangur

afstaða mkv: 1:500

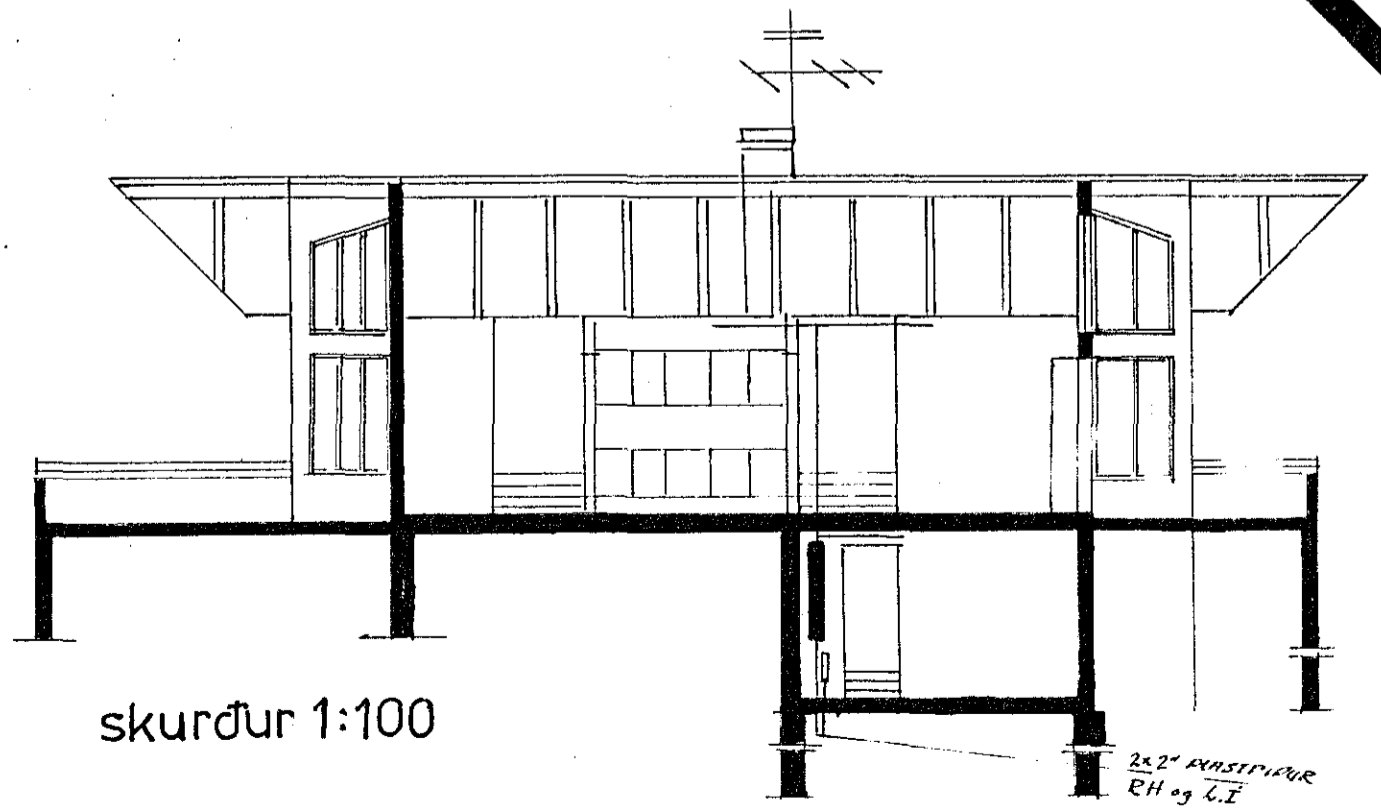

skurður 1:100

SÆVANGUR 9, HAFNARFIRÐI	mkv: 1:50		
RAFLÖGN KJALLARI	teikn: J.P.		dags. apríl '77
JÓN P. GUÐMUNDSSON sími: 50796		blad 1af2	