


Samþykkt þann
30. júní 2016

Byggingafulltrúinn í Hafi *[Signature]*

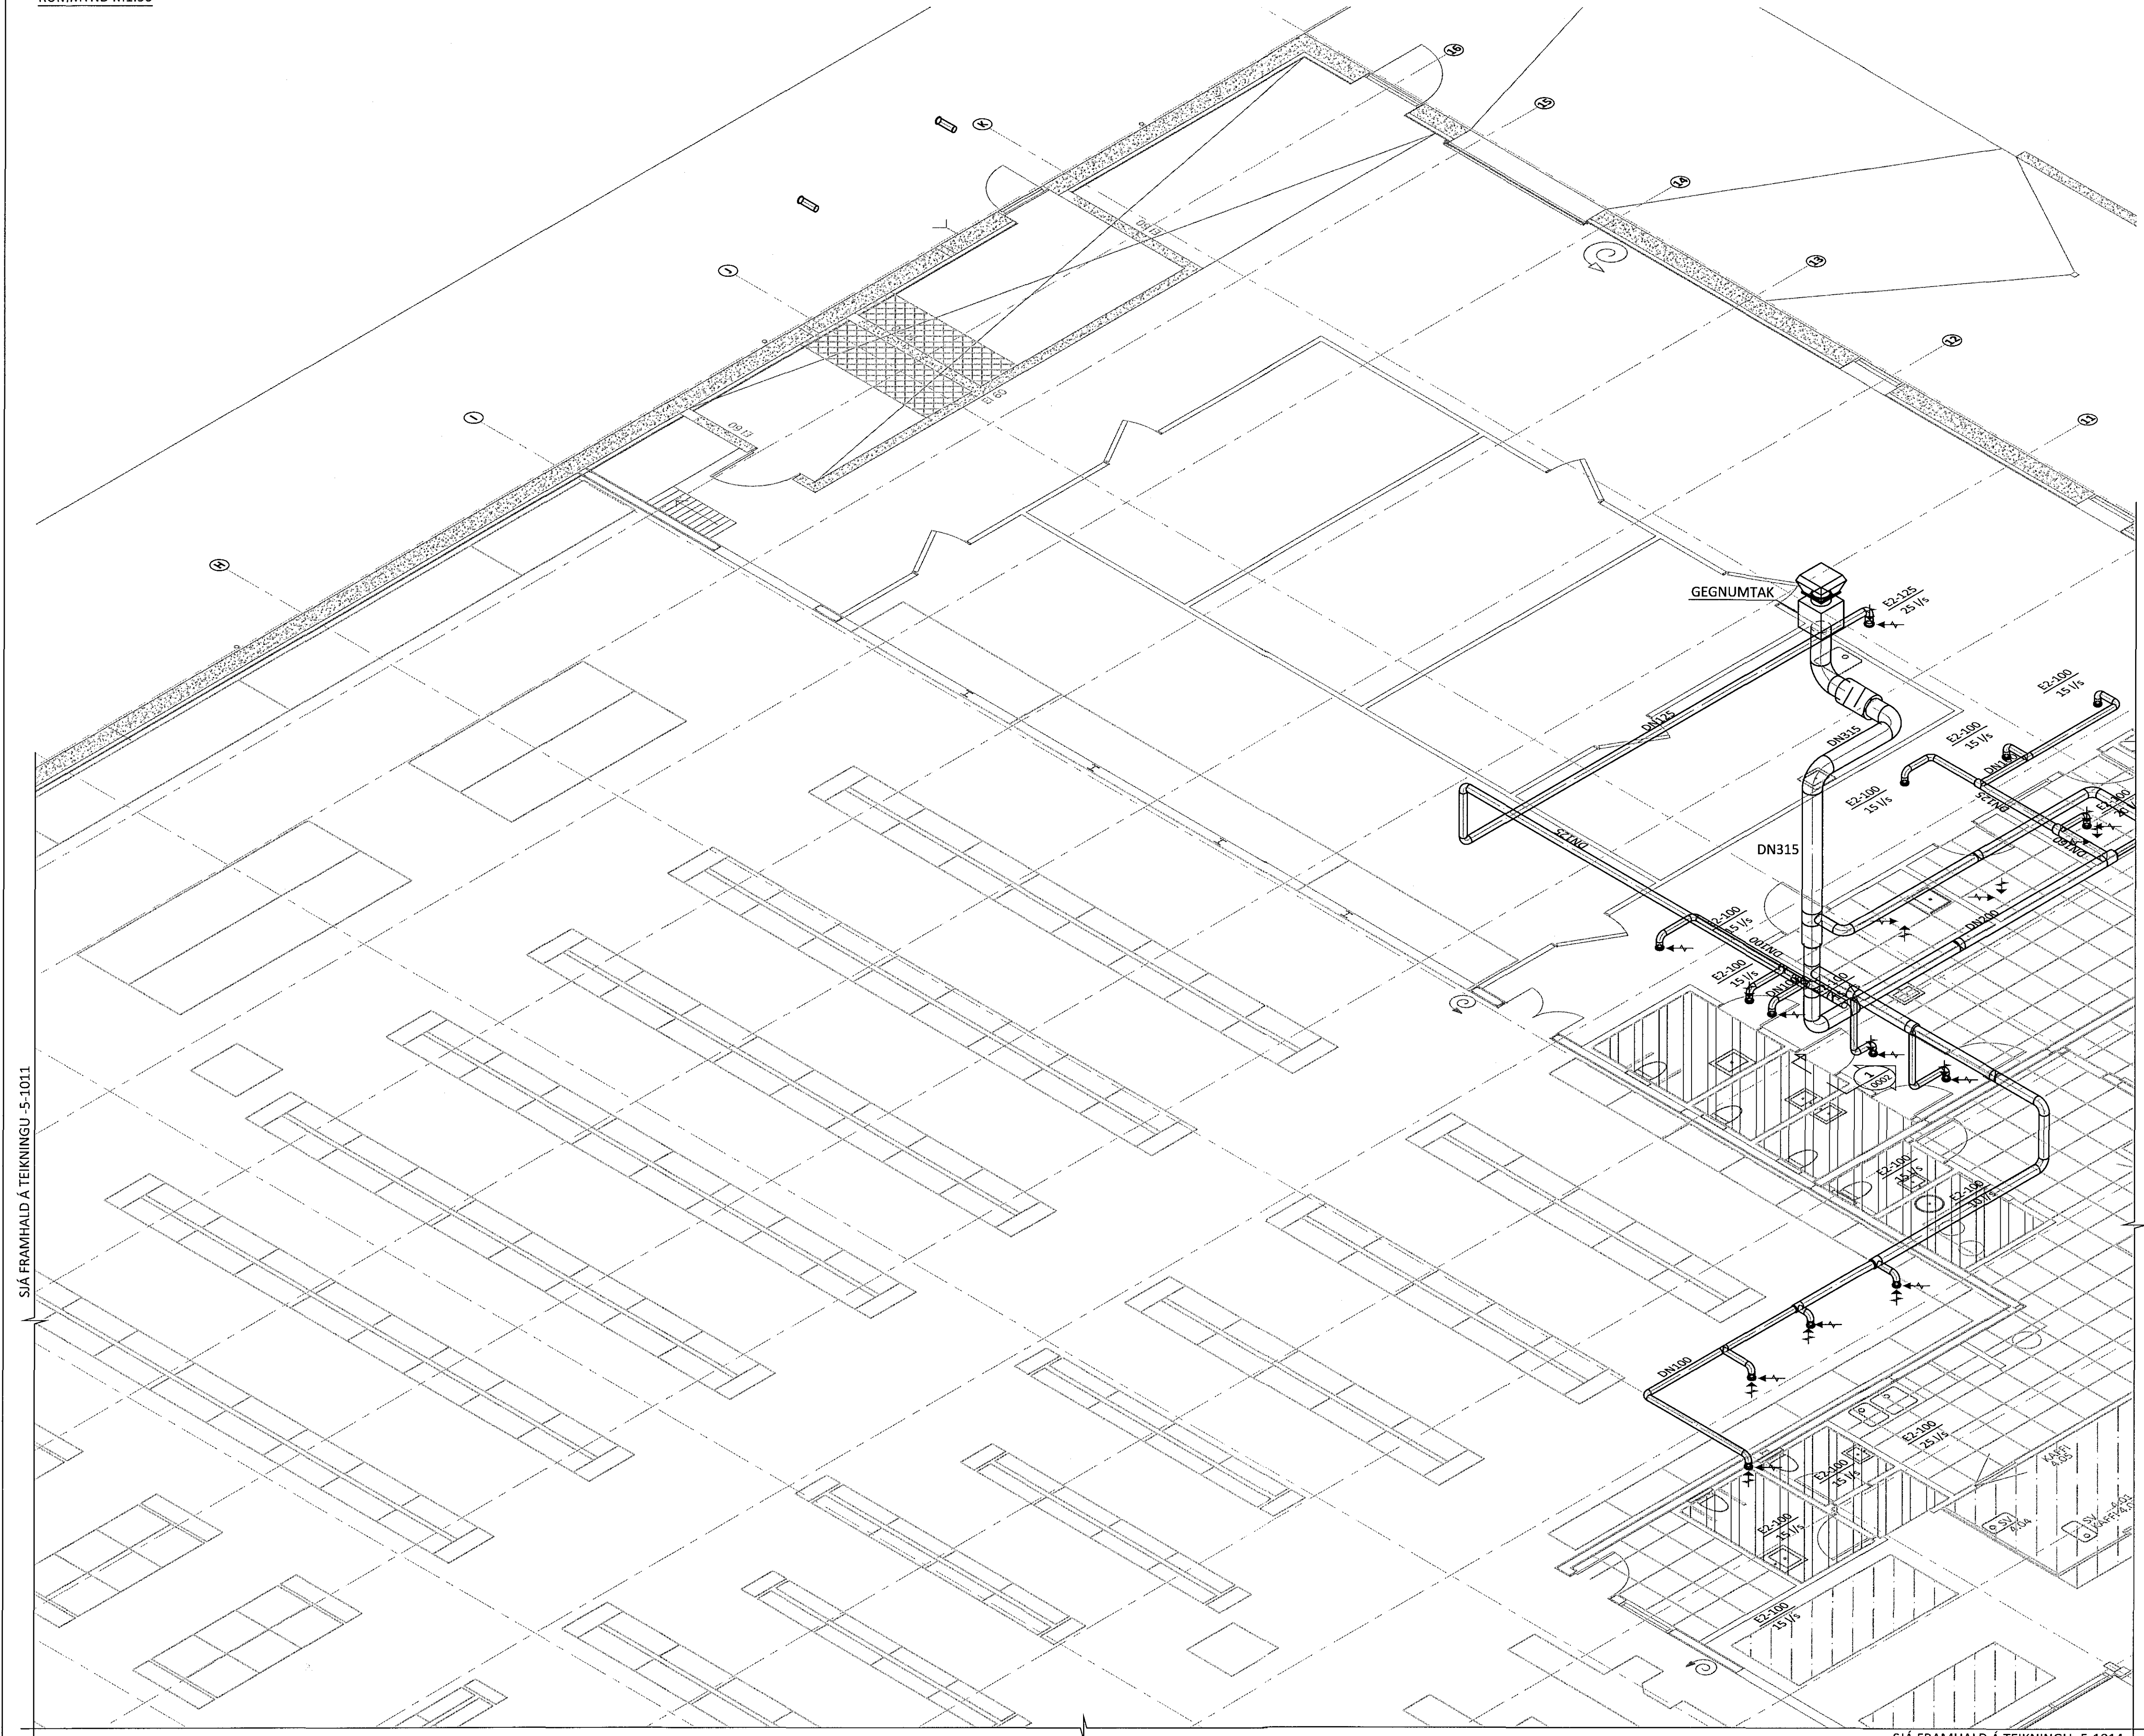


SJÁ FRAMHALD Á TEIKNINGU -5-1011

V:\Flatahraun\13\Teikningar\5-LOFTRÆSING\14048-5-1000.dwg

SJÁ FRAMHALD Á TEIKNINGU -5-1014

LYKILMYND:

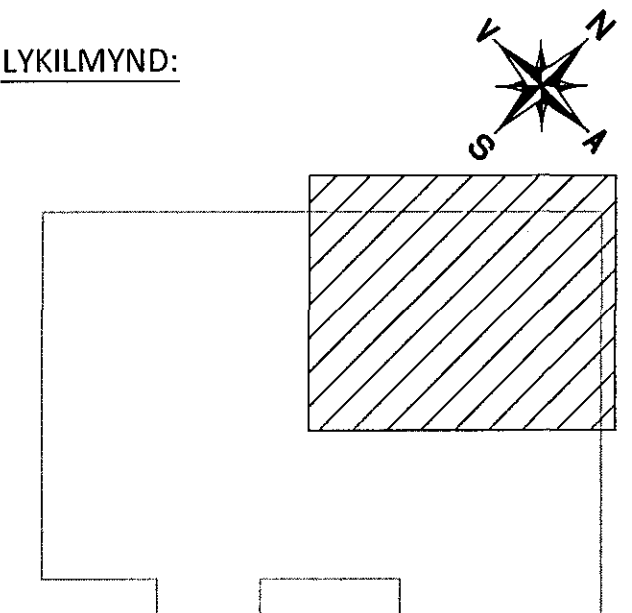

ÁRITUN BYGGINGARFULLTRÚA: *[Signature]* KT.
Tel. 220564-4389

ALMENNAR SKÝRINGAR SJÁ TEIKNINGU NR. -5-0001

A 21.06.16 REYNDARTEIKNING *[Signature]*
BR. DAGS. BREYTING



FLATAHRAUN 13 HAFNARFJÖRDUR
NÝBYGGING KRÓNÜVERSUN
LOFTRÆSING
RÚMMYND
2. HLUTI

SAMÞYKKT *[Signature]* 2016.06.22 *[Signature]*

HÖNNUÐUR GP	YFIRFARIÐ gummi@ferill.is	DAGS. ÚLG. PAG	DAGS. BREYT. 21.06.16
MKV. (A1) 1:50	VERKNR. 14048	TEIKN. NR. 5 - 1012	BREYT. A

Ferill ehf. Mörkin 1 108 Reykjavík Sími: 575 1600 Fax: 575 1601 www.ferill.is