


RÚMMYND M1:50

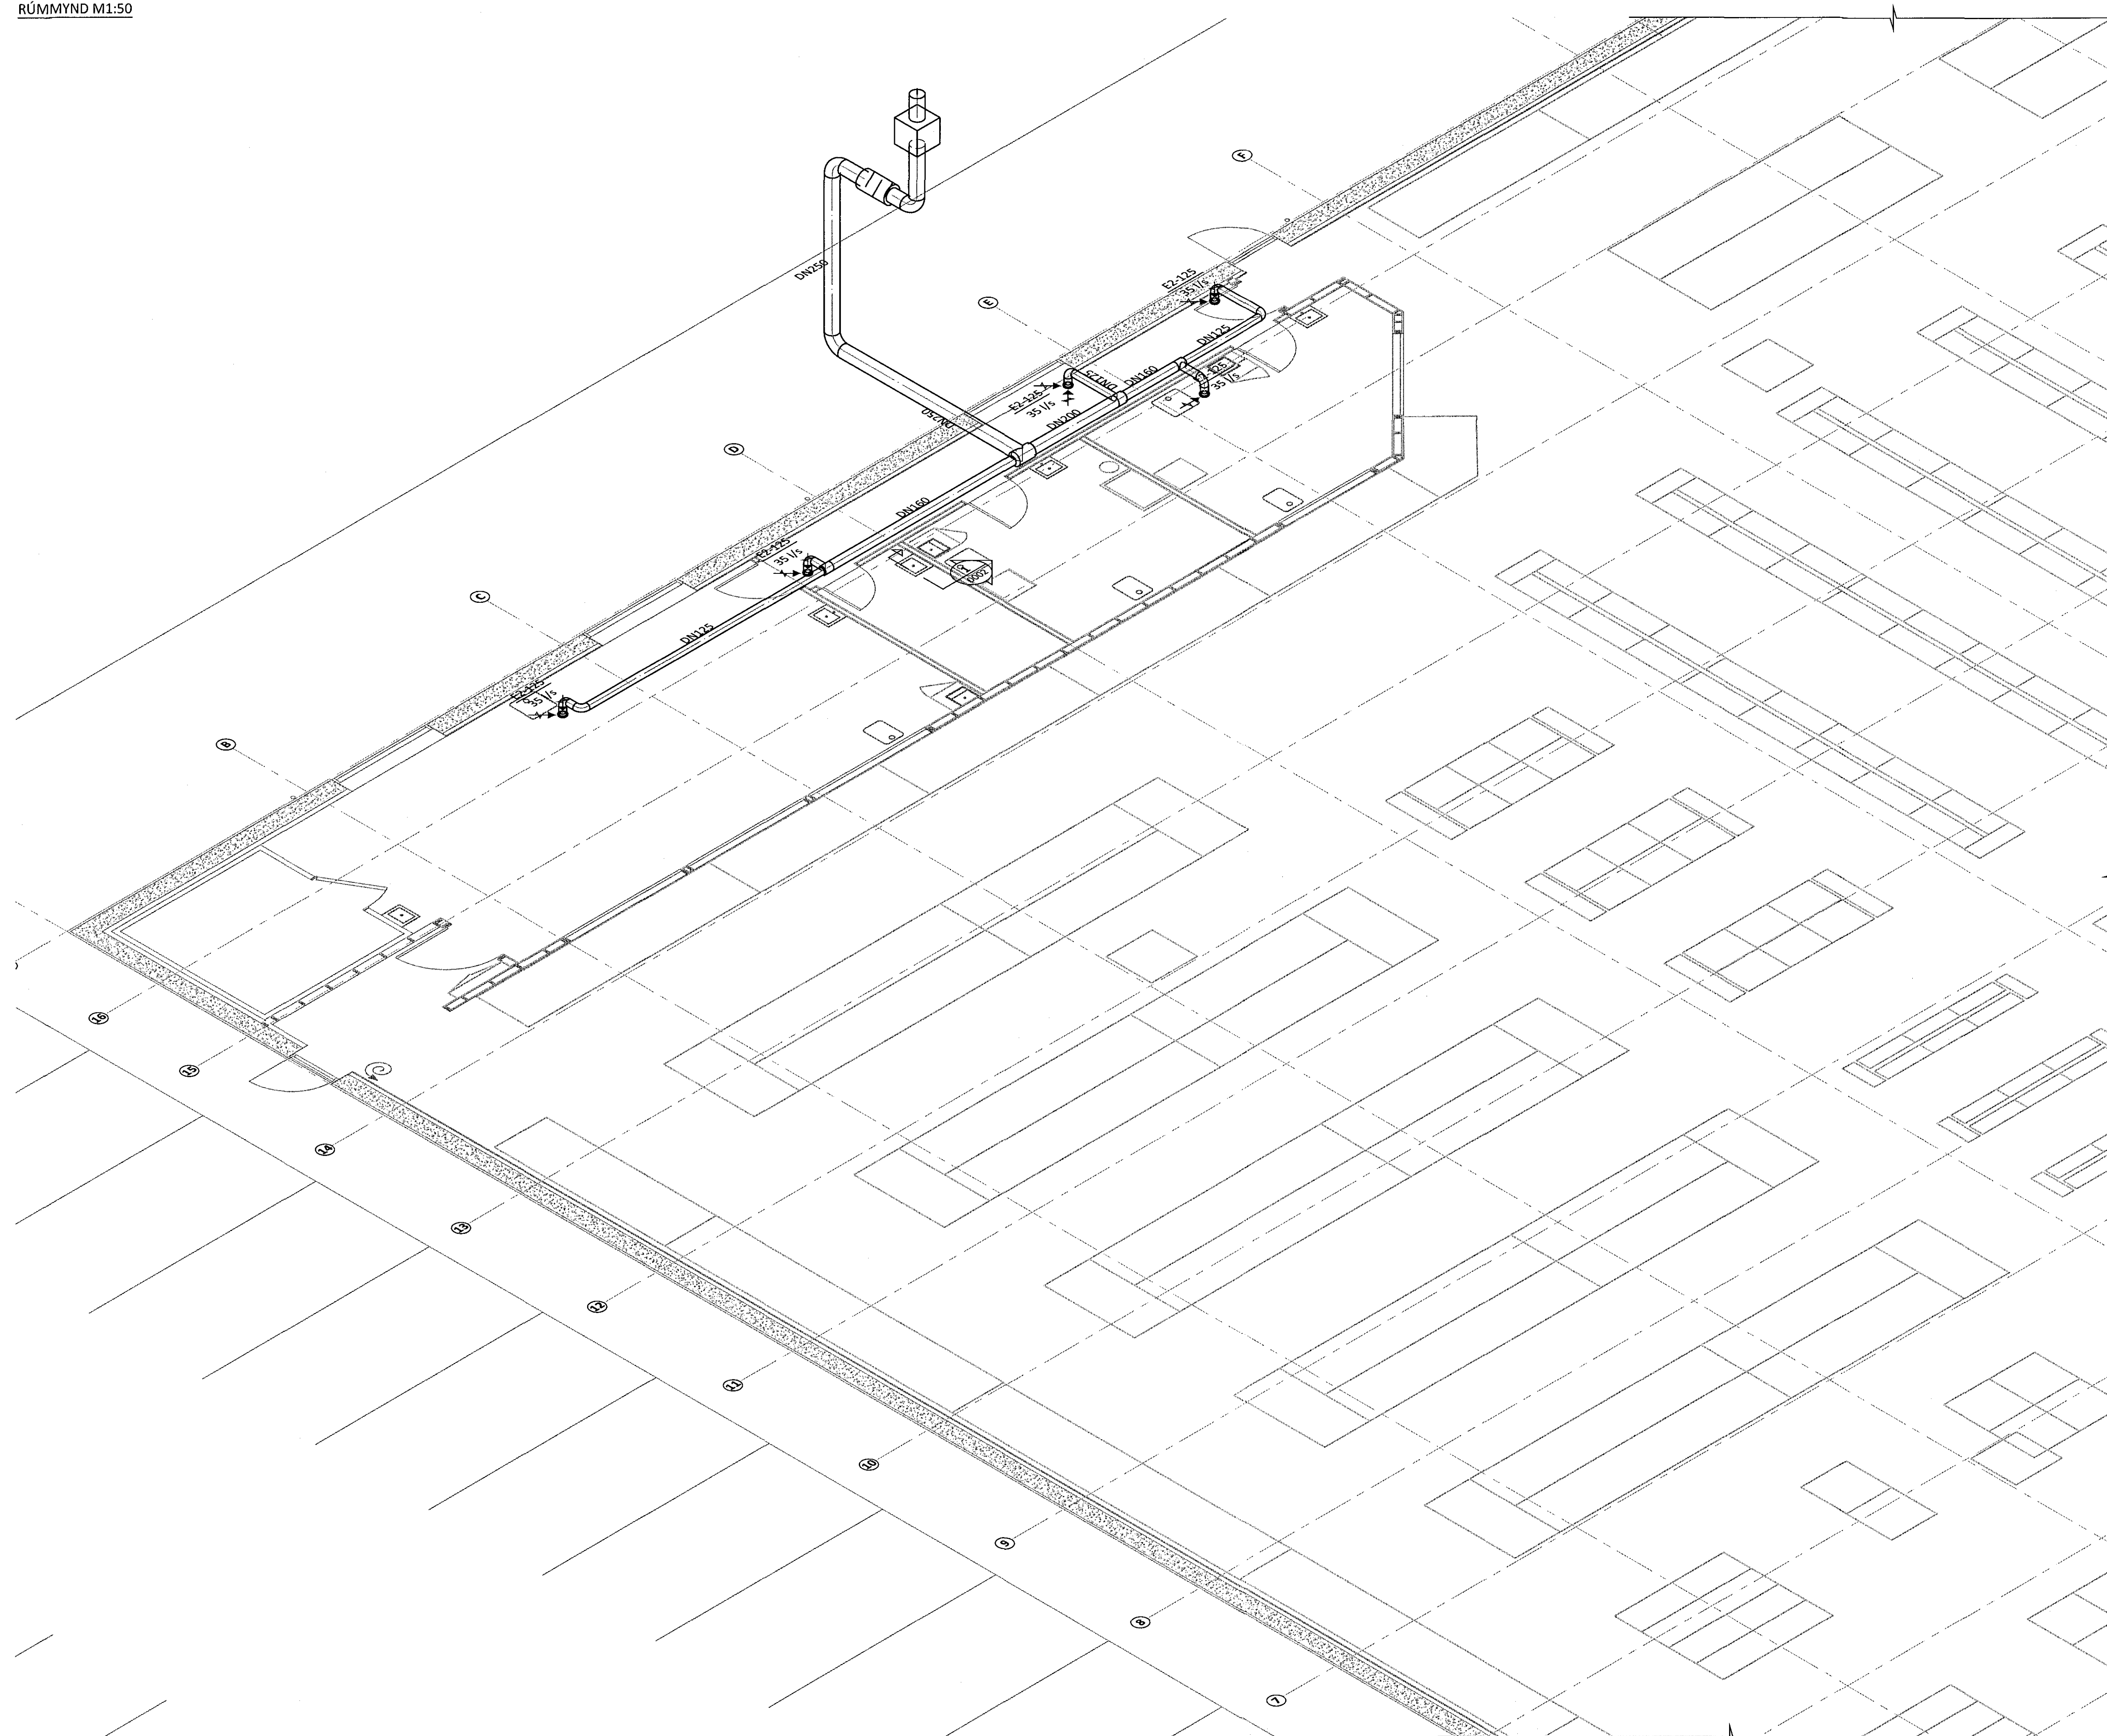

V:\Flatahraun\13\Teikningar\5-LOFTRÆSING\14048-5-1000.dwg


21.06.16 15:06:25

ÁRITUN BYGGINGARFULLTRÁJA

Samþykkt þann  
30. júní 2016  
Byggingafulltrúinn í Hluti 1

SJÁ FRAMHOLD Á TEIKNINGU 5-1012

LYKILMYND:

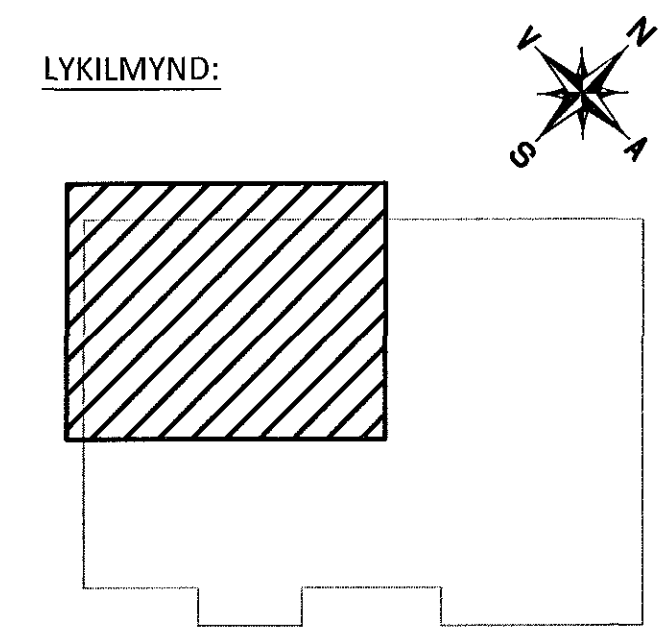

ÁRITUN BYGGINGARFULLTRÁJA: *[Signature]*  
Kt. 220564-4369

ALMENNAR SKÝRINGAR SJÁ TEIKNINGU NR. -5-0001

|     |          |                                    |
|-----|----------|------------------------------------|
| BR. | DAGS.    | BREYTING                           |
| A   | 21.06.16 | REYNDARTEIKNING <i>[Signature]</i> |



**FLATAHRAUN 13** HAFNARFJÖRÐUR  
NÝBYGGING KRÖNUVERSLUN  
LOFTRÆSING  
RÚMMYND  
1. HLUTI

|           |                    |            |              |
|-----------|--------------------|------------|--------------|
| SAMÞYKKT: | <i>[Signature]</i> | KT.        | 270760-4229  |
| HÖNNUÐUR  | YFIRFARIÐ          | DAGS. ÚTG. | DAGS. BREYT. |
| GP        | gummi@ferill.is    | DAG        | 13.11.15     |
| MIK. (A3) | 1:50               | VERNR.     | 14048        |
|           |                    | TEIKN. NR. | 5 - 1011     |
|           |                    | BREYT.     | A            |

Ferill ehf. Mörkin 1 108 Reykjavík Sími: 575 1600 Fax: 575 1601 www.ferill.is