



ARITUN BYGGINGARFULLTRÚA

Samþykkt þann
30. Júní 2016
Byggingafulltrúinn *[Signature]*

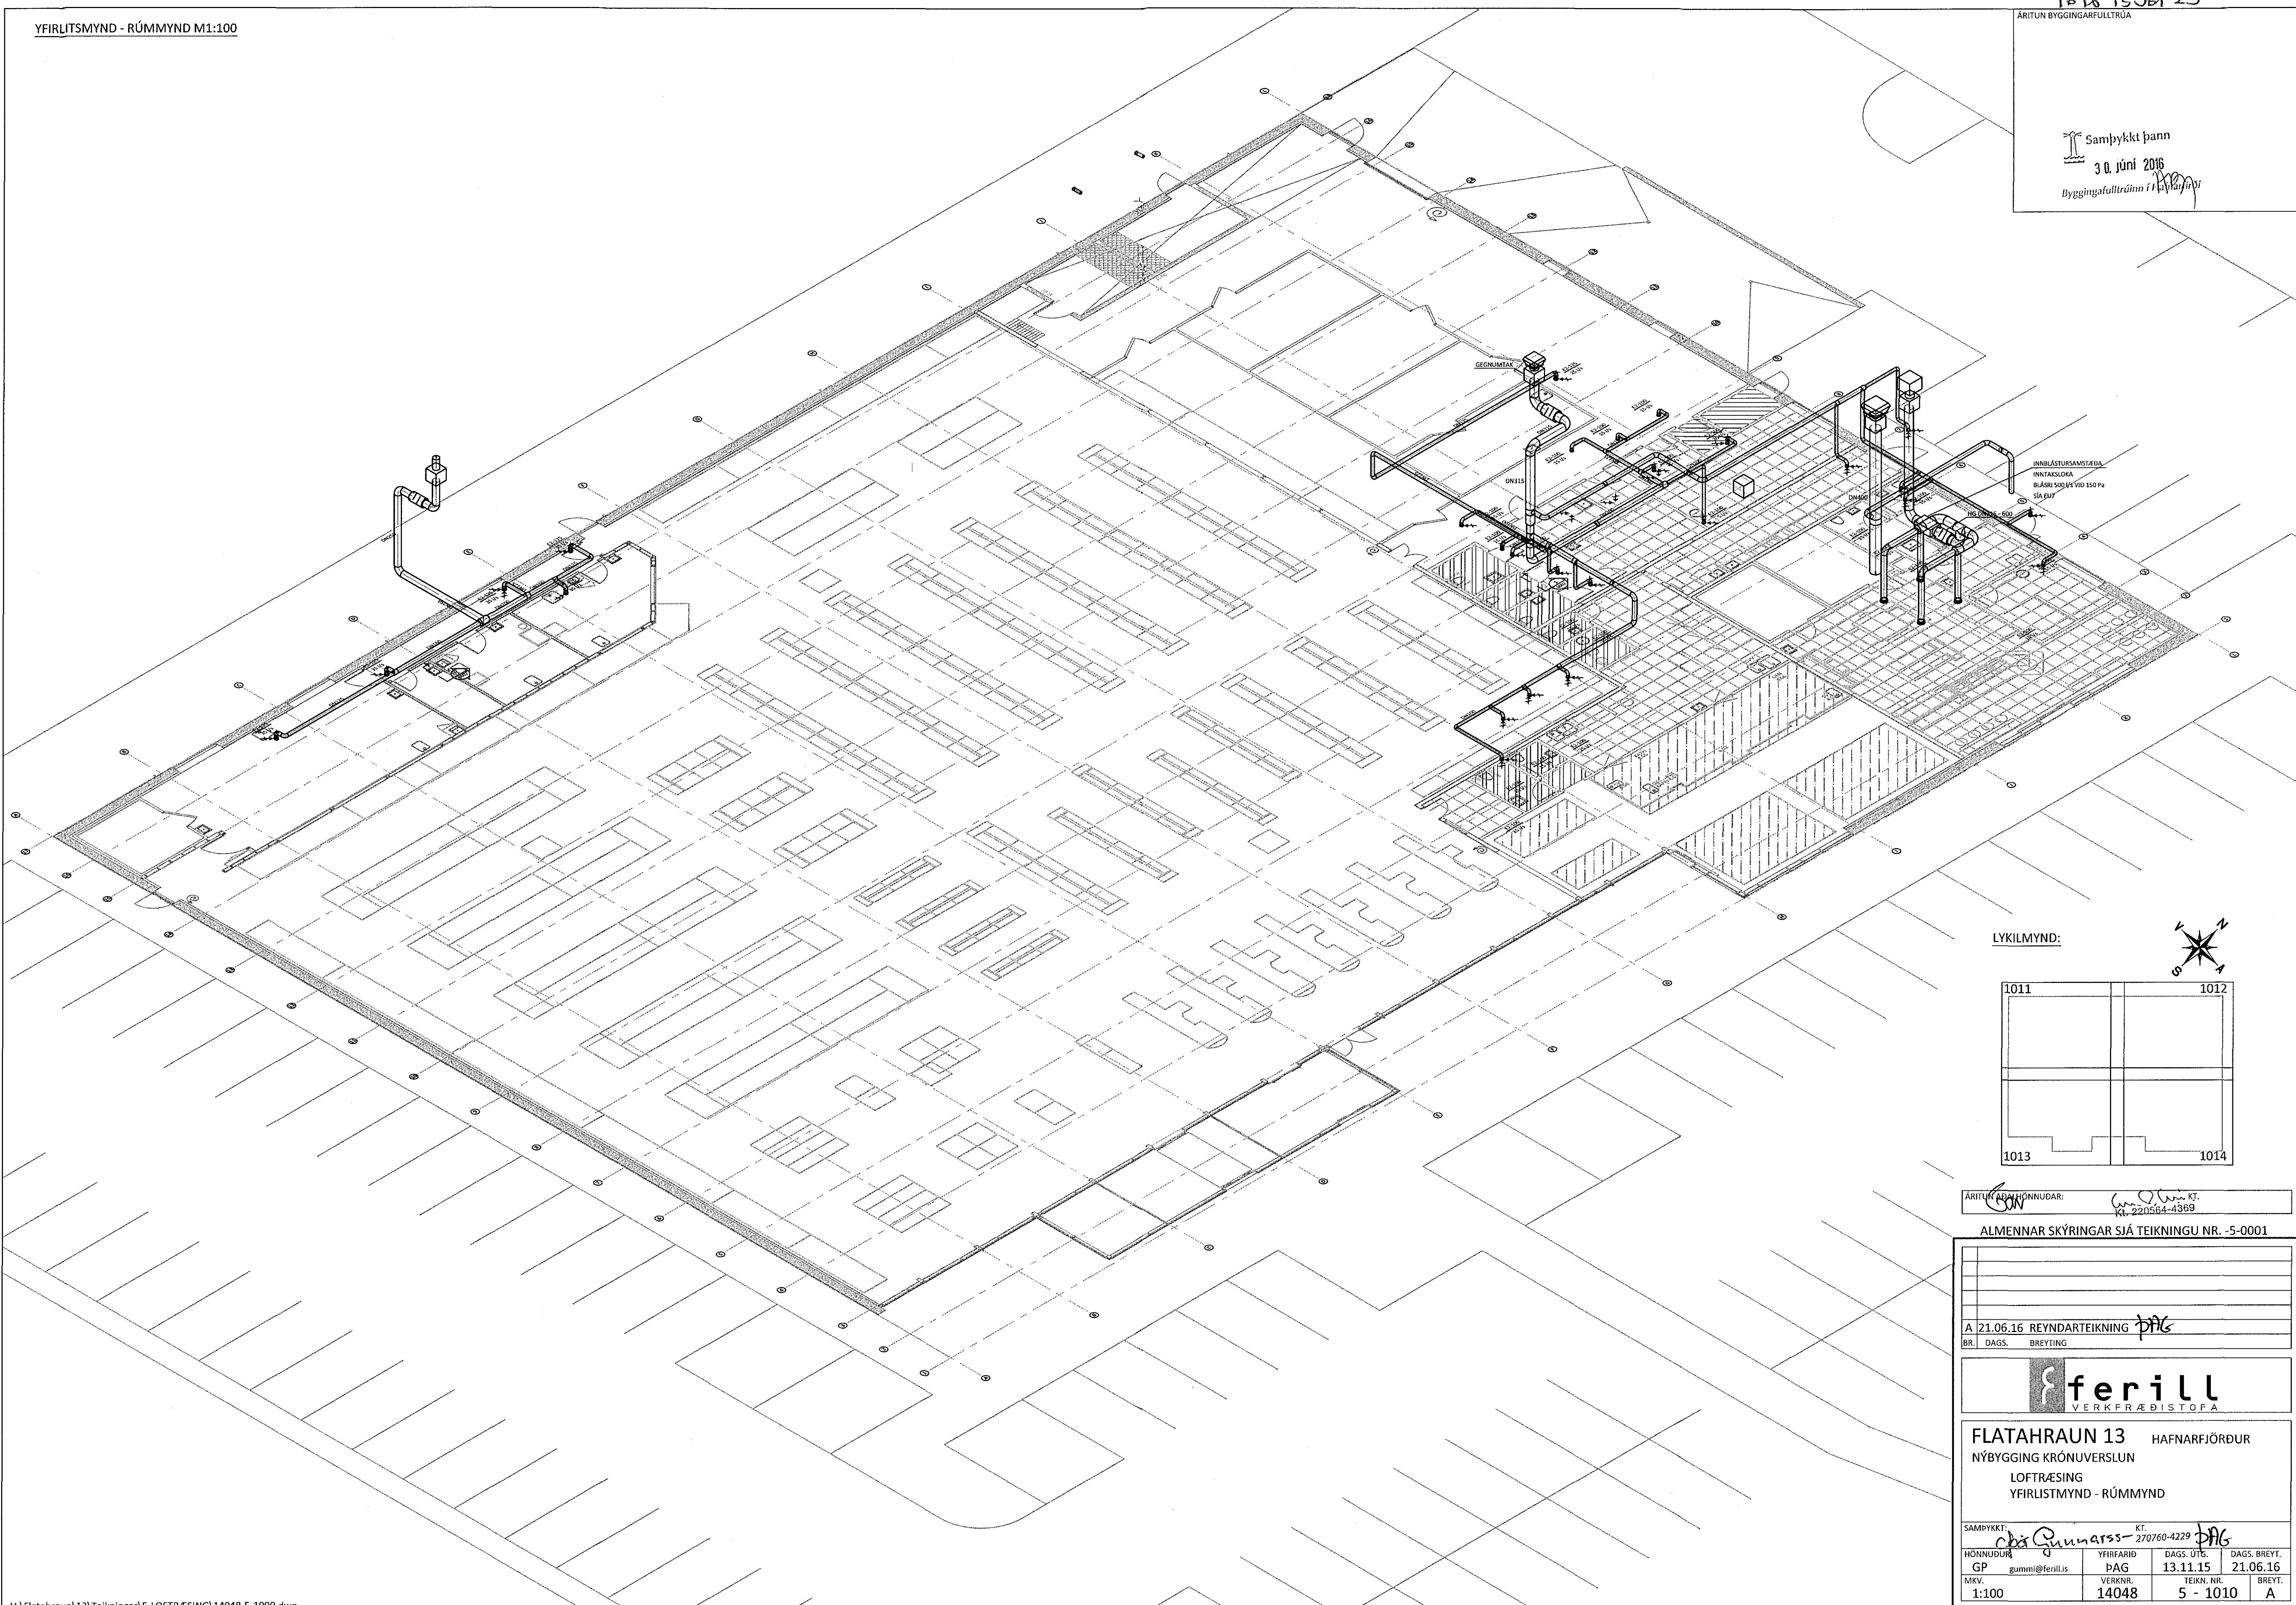

LYKILMYND:

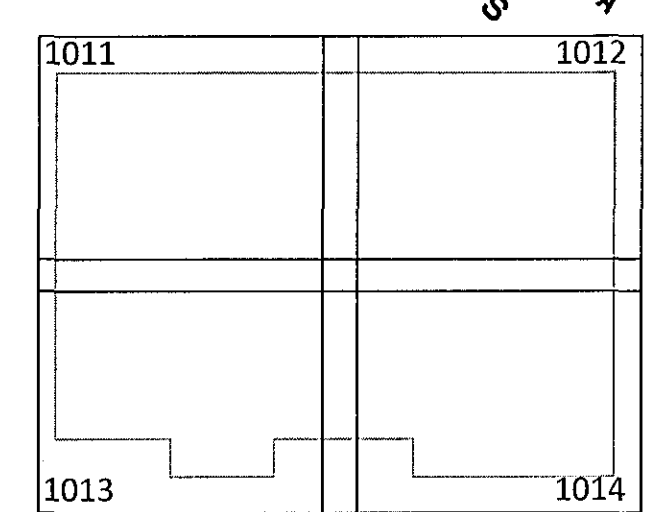

ARITUNARÁÐGAFMENN: *[Signature]*
KT. 220564-4369

ALMENNAR SKÝRINGAR SJÁ TEIKNINGU NR. -5-0001

A 21.06.16 REYNDARTEIKNING <i>PAG</i>		
BR.	DAGS.	BREYTING



FLATAHRAUN 13 HAFNARFJÖRDUR
NÝBYGGING KRÓNUVERSUN
LOFTRÆSING
YFIRLISTMYND - RÚMMYND

SAMPYKKT: <i>[Signature]</i> KT. <i>PAG</i>			
HÖNNUÐUR	YFIRFARIÐ	DAGS. ÚTG.	DAGS. BREYT.
GP	gummi@ferill.is	PAG	13.11.15
MKV.	VERKNR.	TEIKN. NR.	BREYT.
1:100	14048	5 - 1010	A