



Sampykkt þann  
30. júní 2016  

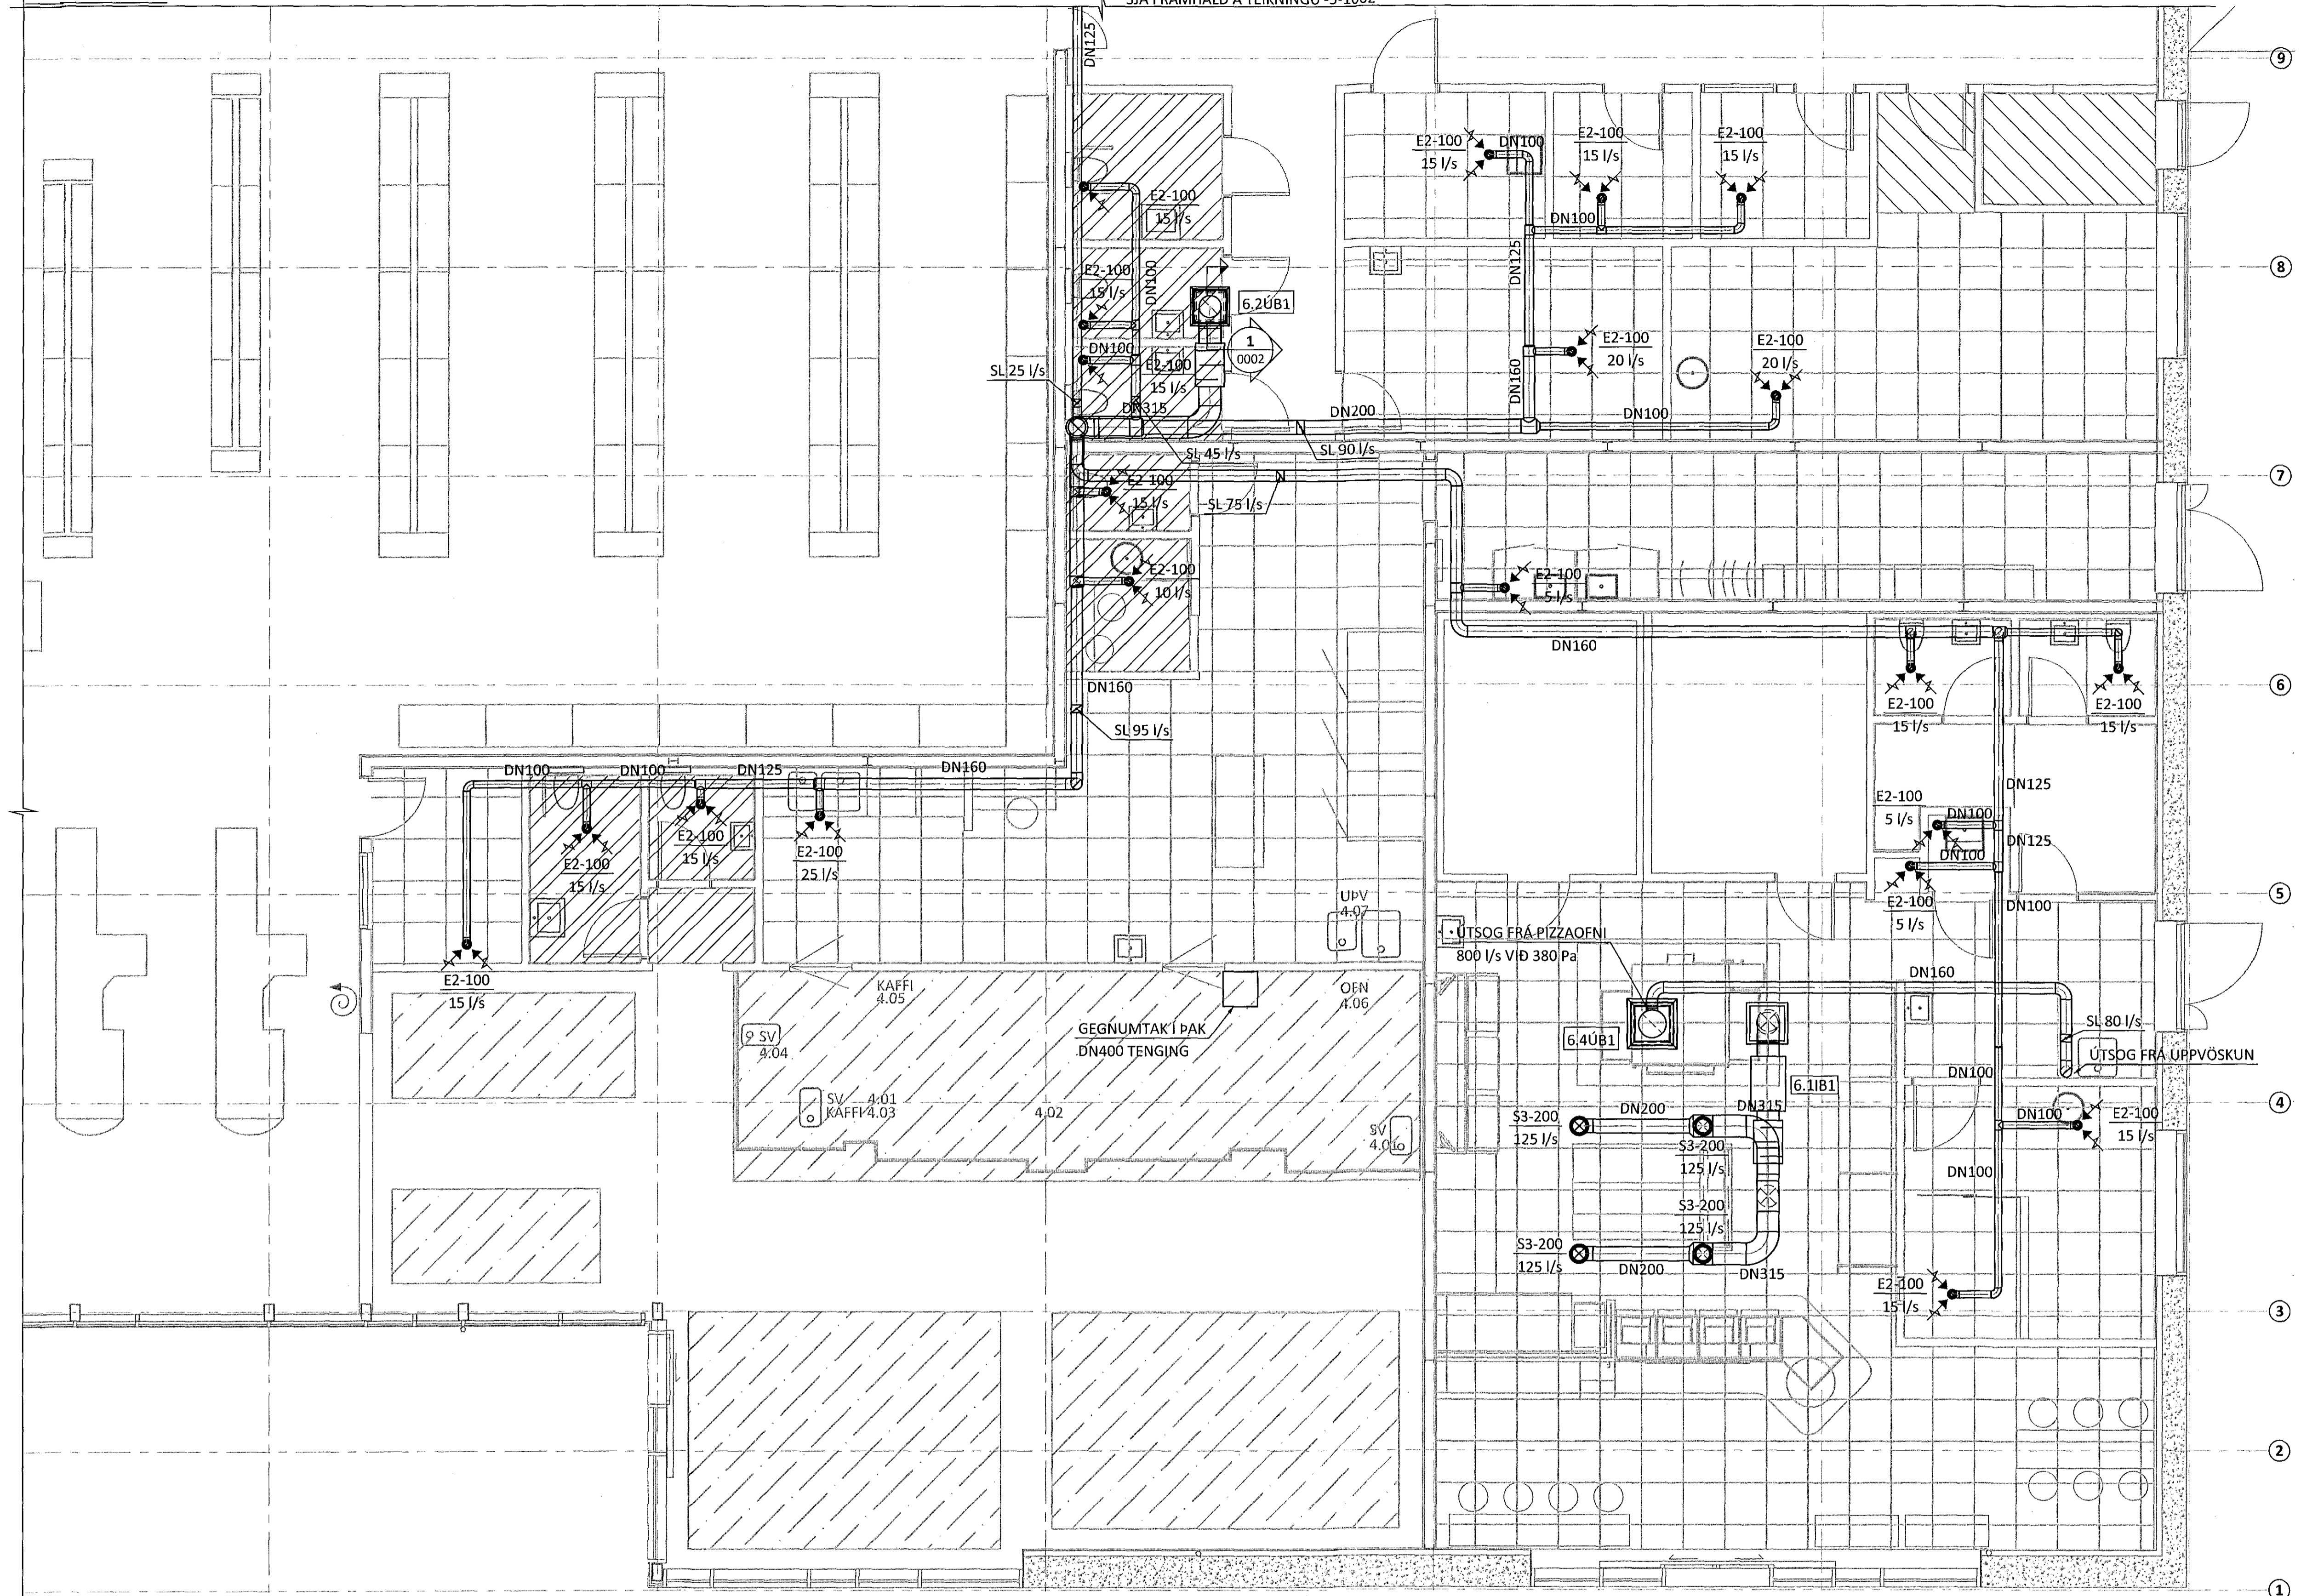

LYKILMYND:

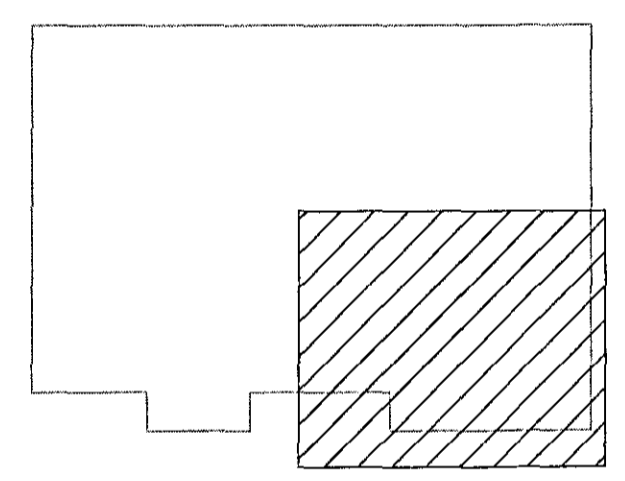

ÁRTUN BYGGINGARFULLTRÚA: *[Signature]*  
Kt. 220564-4369

ALMENNAR SKÝRINGAR SJÁ TEIKNINGU NR. -5-0001

BR.	DAGS.	BREYTING
A	21.06.16	REYNDARTEIKNING <i>[Signature]</i>



FLATAHRAUN 13 HAFNARFJÖRDUR  
NÝBYGGING KRÖNUVERSLUN  
LOFTRÆSING  
GRUNNMYND  
4. HLUTI

HÖNNUÐUR	YRIFARID	DAGS. ÚTS.	DAGS. BREYT.
GP	gurnmi@ferill.is	BAG	13.11.15
MRV. (A1)	VERKNR.	TEKN. NR.	BREYT.
1:50	14048	5 - 1004	A

Ferill ehf. Mörkin 1, 108 Reykjavík. Sími: 575 1600 Fax: 575 1601 www.ferill.is