


V:\Flatahraun\13\Teikningar\5-LOFTRÆSING\14048-5-1000.dwg

27/616 1506125

ÁRTUN BYGGINGARFULLTRÚA

Samþykkt þann  
30. júní 2016  
Byggingafulltrúinn í Hafnarfjörð

SIÁ FRAMHÁLD Á TEIKNINGU -5-1002

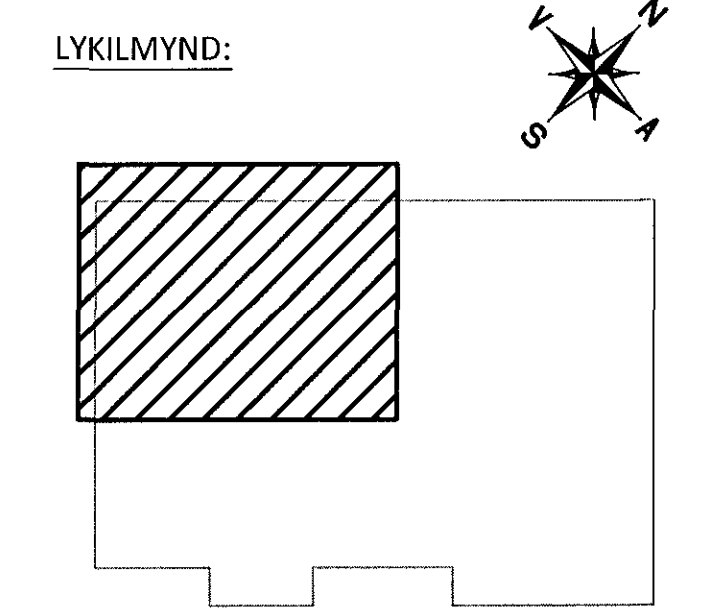

ÁRTUN / ÁHÖNNUNÐAR: *[Signature]*  
Kl. 220564-4369 KT.

ALMENNAR SKÝRINGAR SIÁ TEIKNINGU NR. -5-0001

BR.	DAGS.	BREYTING
A	21.06.16	REYNDARTEIKNING <i>[Signature]</i>



FLATAHRAUN 13 HAFNARFJÖRDUR  
NÝBYGGING KRÓNUVERSLUN  
LOFTRÆSING  
GRUNNMYND  
1. HLUTI

HÖNNUNÐUR	YFIRFARIÐ	DAGS. ÚTG.	DAGS. BREYT.
GP	gummi@ferill.is	13.11.15	21.06.16
MKV. (A1)	VERKNR.	TEIKN. NR.	BREYT.
1:50	14048	5 - 1001	A

Samþykkt *[Signature]* 270760-4229 *[Signature]*

Ferill ehf. Mörktin 1 108 Reykjavík Sími: 575 1600 Fax: 575 1601 www.ferill.is