


Samþykkt þann
 30. júní 2016
 Byggingafulltrúinn: *[Signature]*

LYKILMYND:

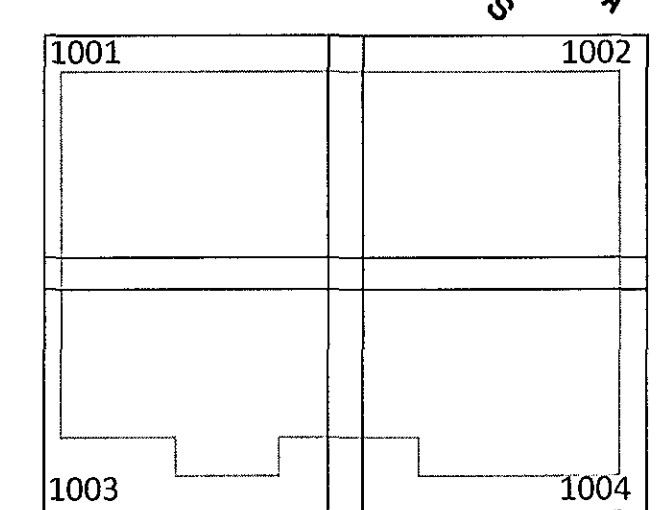

ÁRITUN/ÁÐALHÖNNUÐAR: *[Signature]* KT.
 KT. 220564-4369
 ALMENNAR SKÝRINGAR SJÁ TEIKNINGU NR. -5-0001

A 21.06.16 REYNDARTEIKNING *[Signature]*
 BR. DAGS. BREYTING



FLATAHRAUN 13 HAFNARFJÖRDUR
 NÝBYGGING KRÓNUVERSLUN
 LOFTRÆSING
 YFIRLISTMYND - GRUNNMYND

SAMÞYKKT:	<i>[Signature]</i> KT.	270760-4229	
HÖNNUÐUR	YFIRFARID	DAGS. ÚTG.	DAGS. BREYT.
GP	gummi@ferill.is	DAG	13.11.15
MRV. (A1)	VERKNR.	TEIKN. NÚL.	21.06.16
1:100	14048	5 - 1000	BREYT. A