


GÁMAR

LÓÐ 24: 936,6 m²
F2074360
L120273

LÓÐ NR. 26: 1.064,0 m²
F2074361
L120273

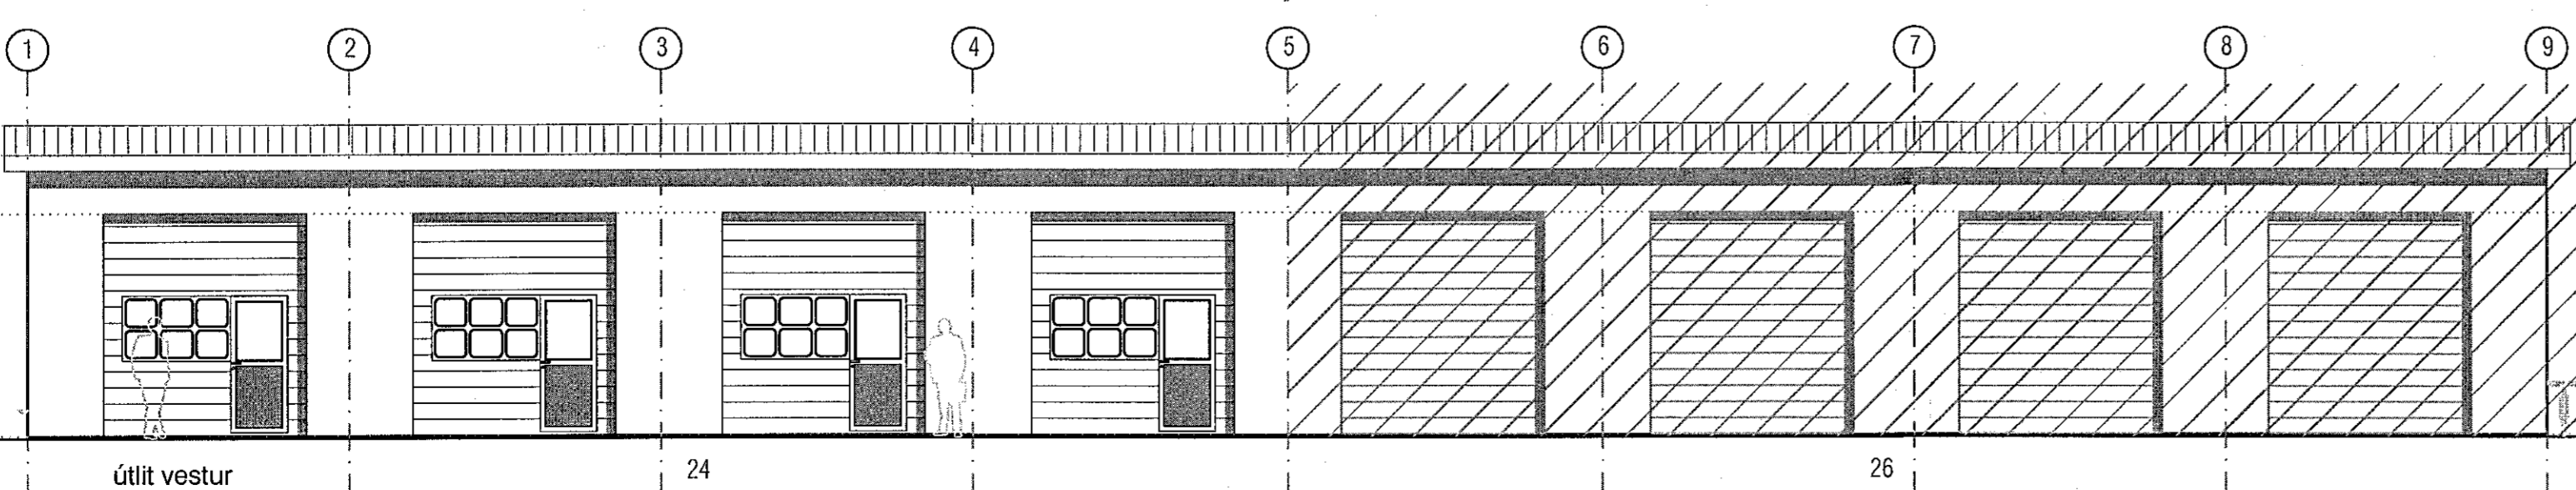

BREYTING 18.01.2021:
BREYTT INNRA SKIPULAG OG BREYTT GLUGGASKIPAN.
SKRÁNINGU RÝMSNÚMERA BREYTT.
NÝ BYGGINGAR OG BRUNAVARNARLÝSING.

mansard
teiknistofa ehf
Ármúla 4 - 108 Reykjavík
www.mansard.is - joni@mansard.is
Kt.: 570394-2079

Verkhelti: DALSHRAUN 24 - HAFNARFIRÐI
Efni: ADALUPPDRÁTTUR
GRUNNMYNDIR-ÚTLIT OG SNID

Verknúmer: A-21-01-03	Mkv.: 1:100	A1
Teikn. nr.: A-002	Dags.: 15.01.2021	
Hannað: JHH	Teiknað: JHH	

Jón Hrafn Hjóðversson byggingafræðingur
Kt.: 280662-6519 - s: 862-7102
Samþykkt:

SJS
24.02.2021

Digitally signed by
Ólafur H. Þorvaldursson
DN: cn=Ólafur H.
Þorvaldursson, o=Mansard ehf, ou=Byggingarfræðingur,
c=Ísland
Reason: I am the author of this document
Date: 2021.02.04 16:07Z