



Samþykkt þann  
23. apríl 2021  
Fl. byggingarfulltráans (Hafnarfirði)  
Sigurður Steinar Jónsson

LÉTIR VEGGIR SEM DARF AD FJARLEGJA

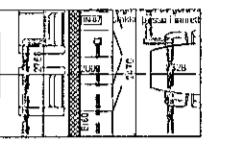

SEINSTEYPTIR VEGGIR SEM DARF AD SAGA

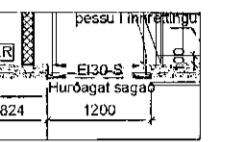

D:  
C:  
B:  
A:  
BREYTINGAR: DAGS:

SÓLVANGUR SÓLVANGSVEGI 2 HAFNARFIRÐI  
NÚVERANDI BYGGING VERK: 1916  
KVARÐI: 1:50  
DAGS: 20.02.2021  
RIF OG FÖRGUN TEIKN: JJP  
GRUNNM. 4 HÆÐ 1 af 2 SKRÁ: 1916 - Sól.v.eldn.dwg

ÚTI INNI


ARKITEKTAR

ÞINGHOLTSSÍÐRÆTI 27 101 REYKJAVÍK  
SÍMAR 5527600 & 5627600 FAX 5527601  
REIÞANG rei@u.is VEFFANG www.u.is

BALDUR Ó. SVAVARSSON ARKITEKTAR FAI  
120257-5149

JÓN ÞÓR ÞORVALDSSON ARKITEKTAR FAI  
021256-7519

A-220

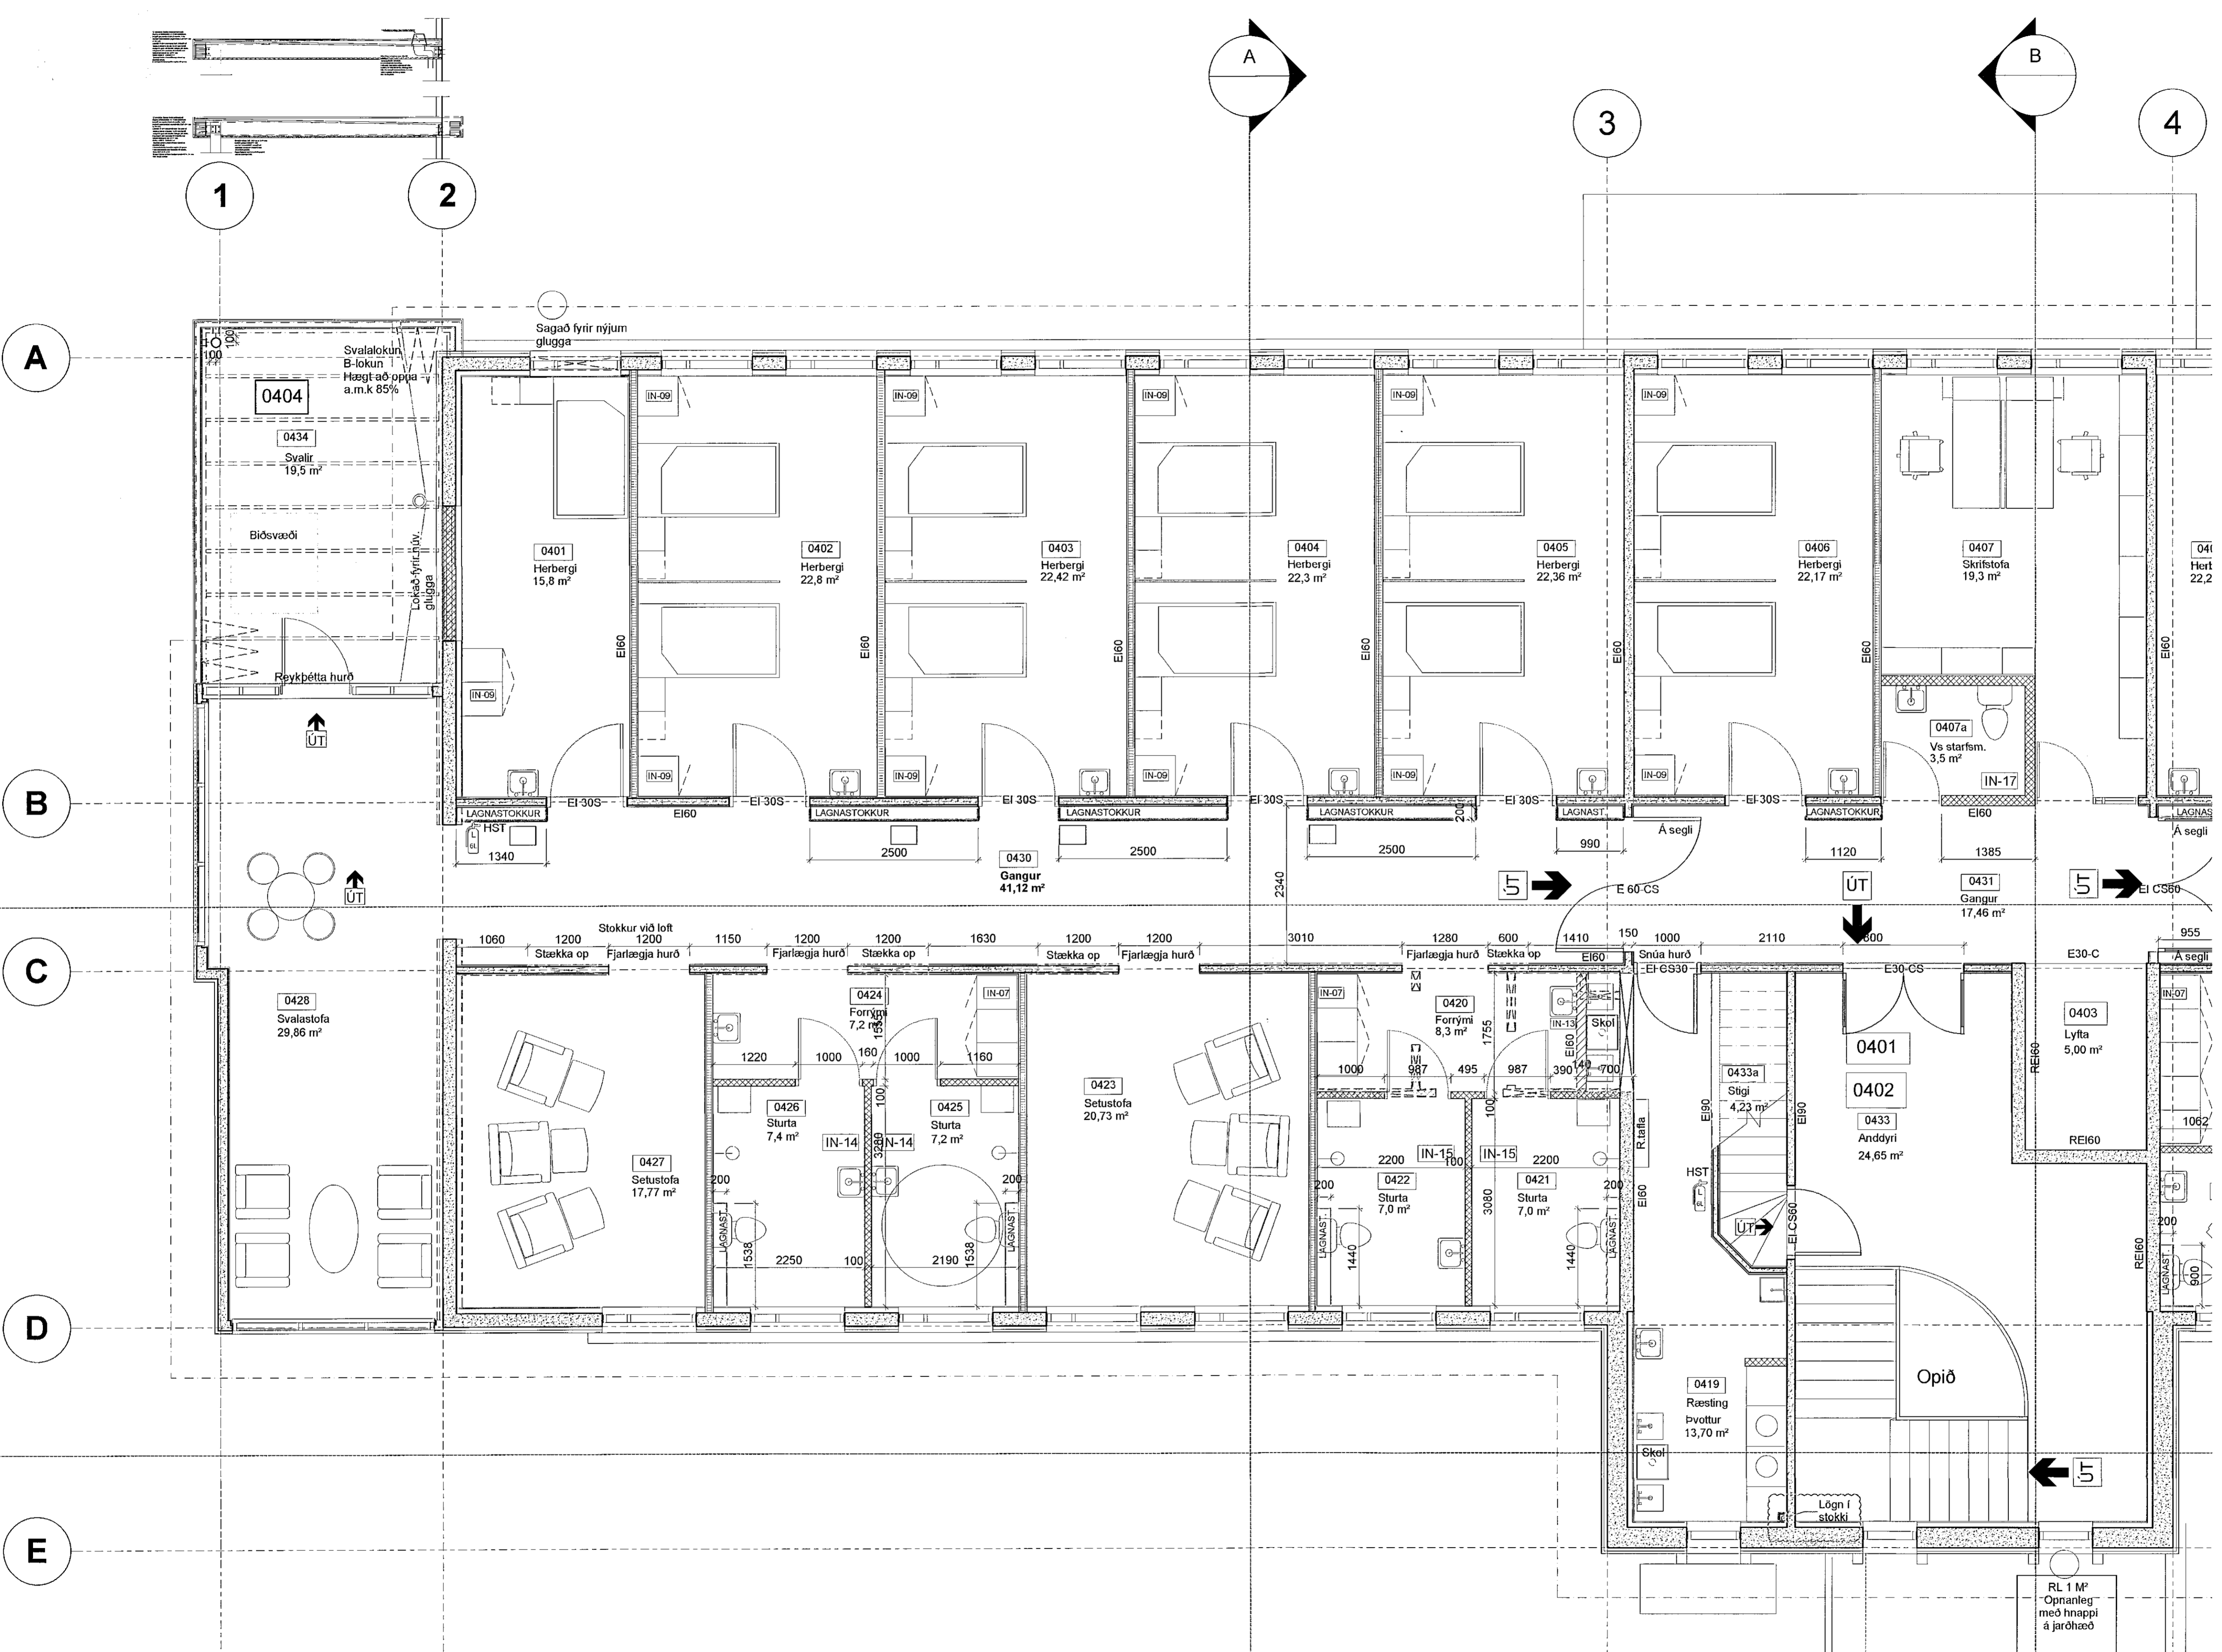

GRUNNMYND 4. HÆÐAR 1:50