



1 2 3 4 5 6 7 8 9 10 11 12 13 14 15 16

A B C D E F G H


Undirritun samreingarhóndunar:

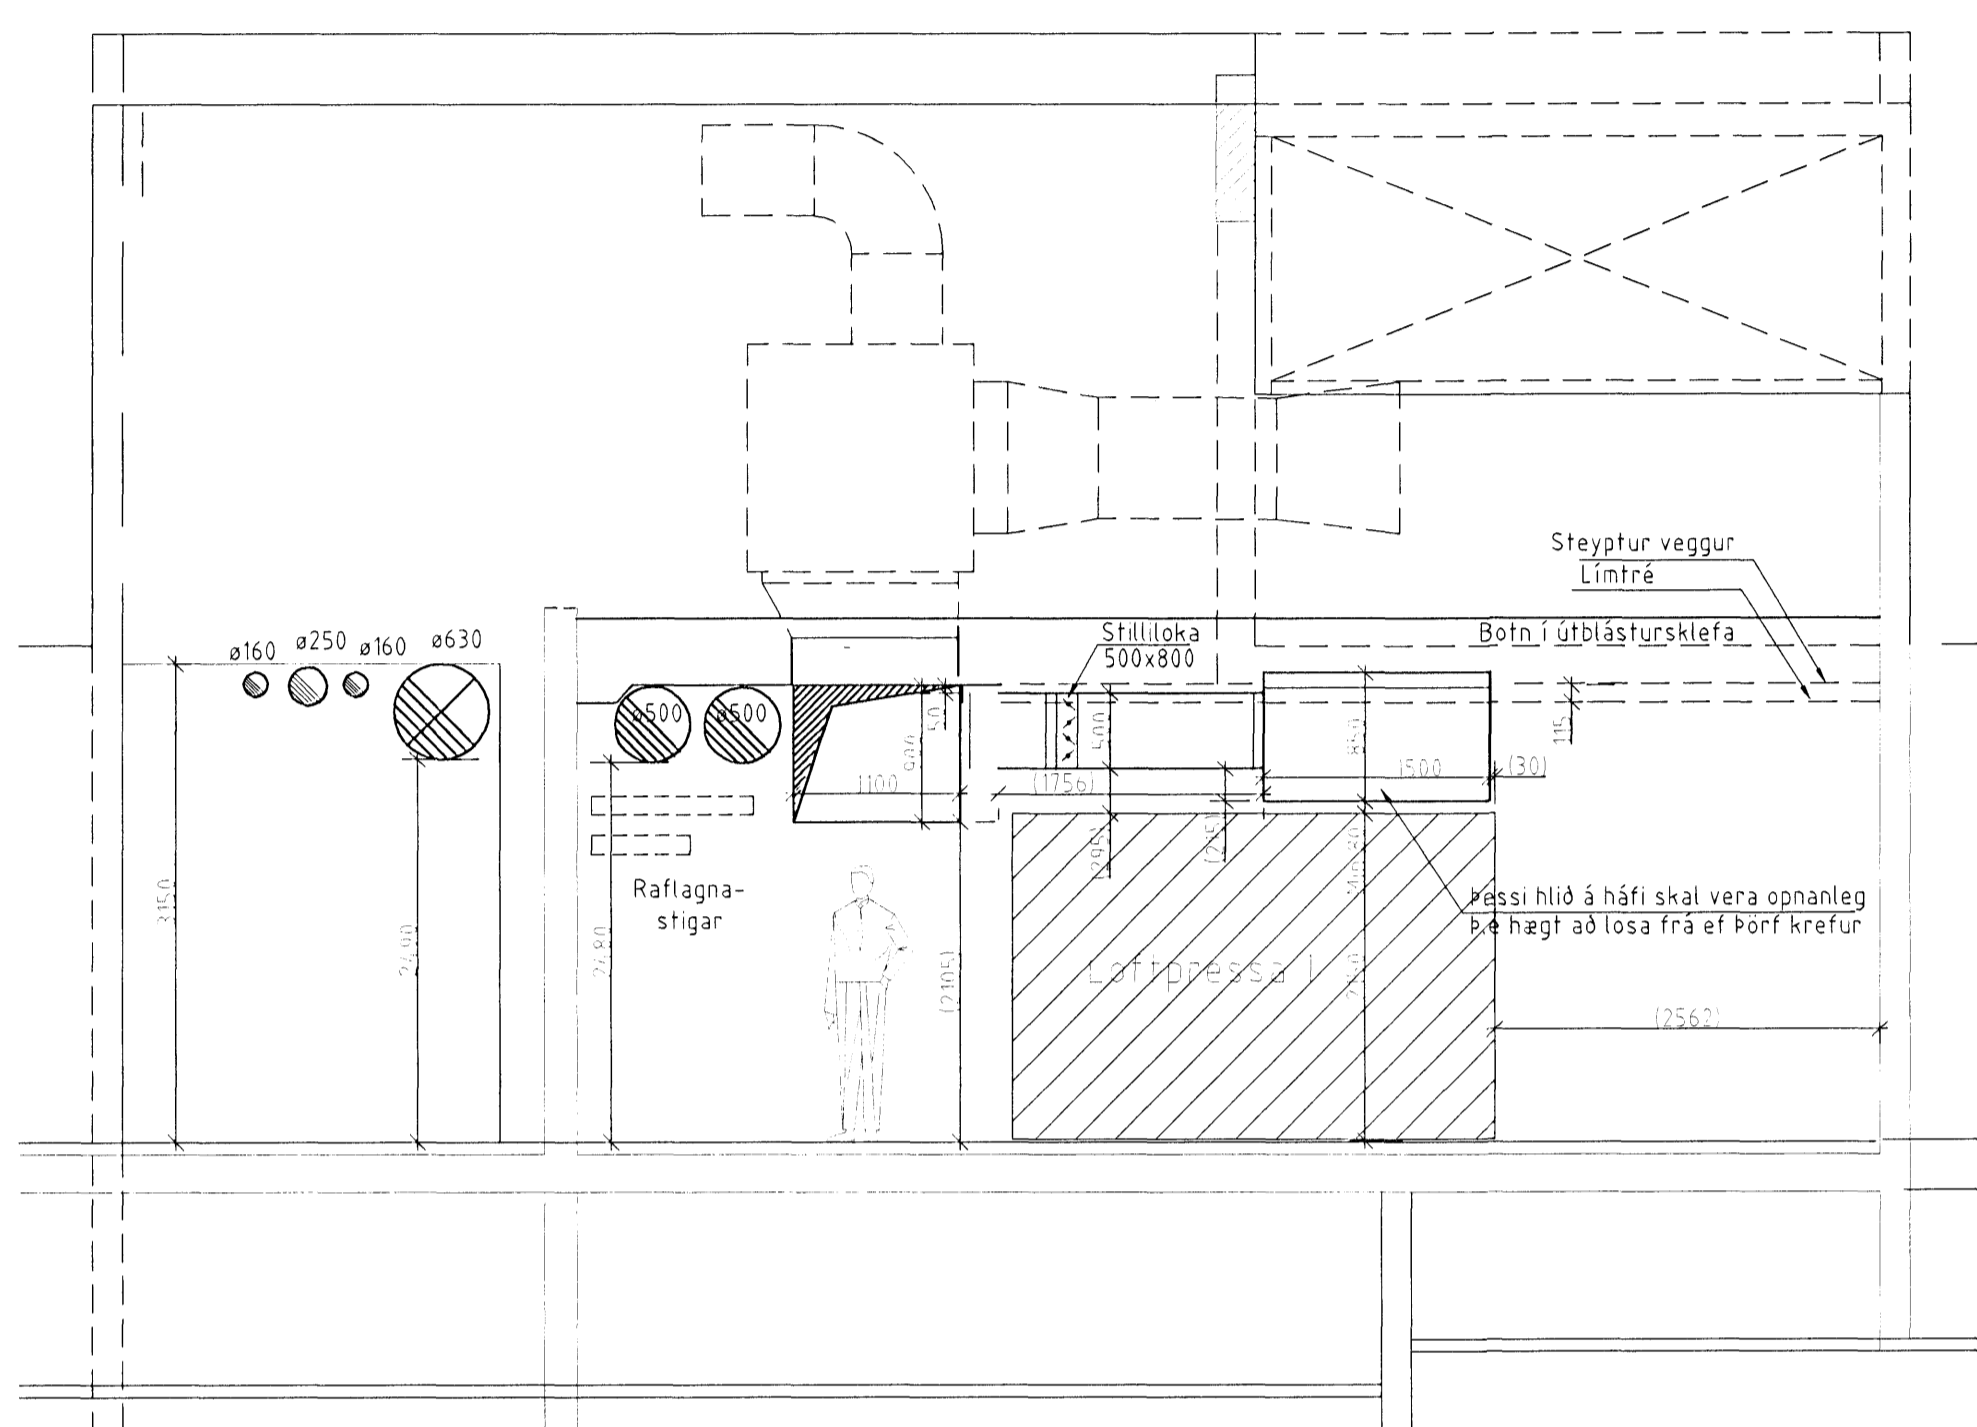


H Snið  
214/404 Mkv. 1: 50

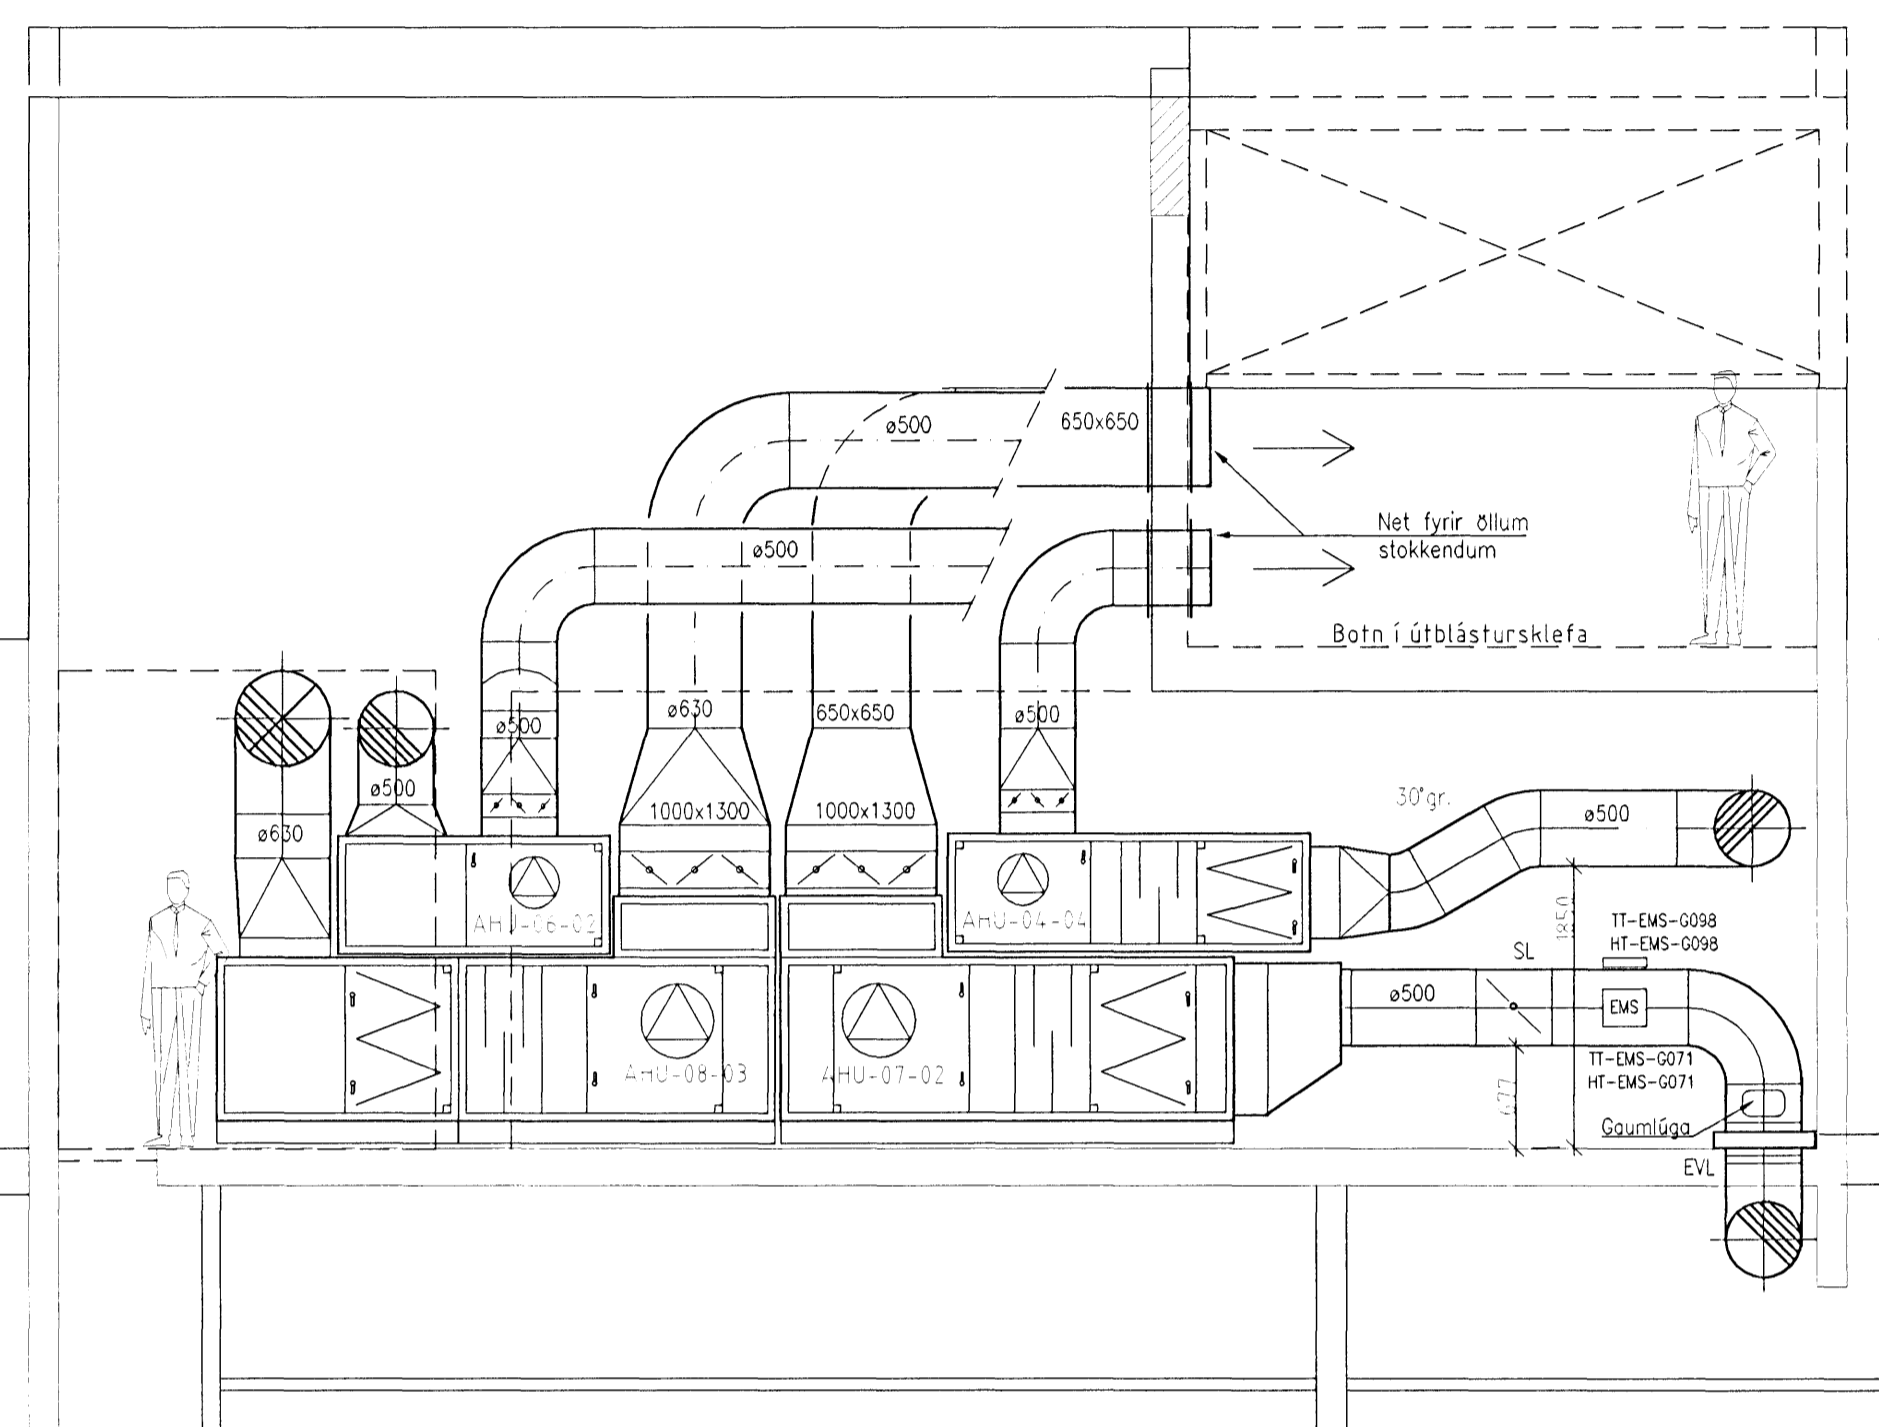


J Snið  
214/404 Mkv. 1: 50

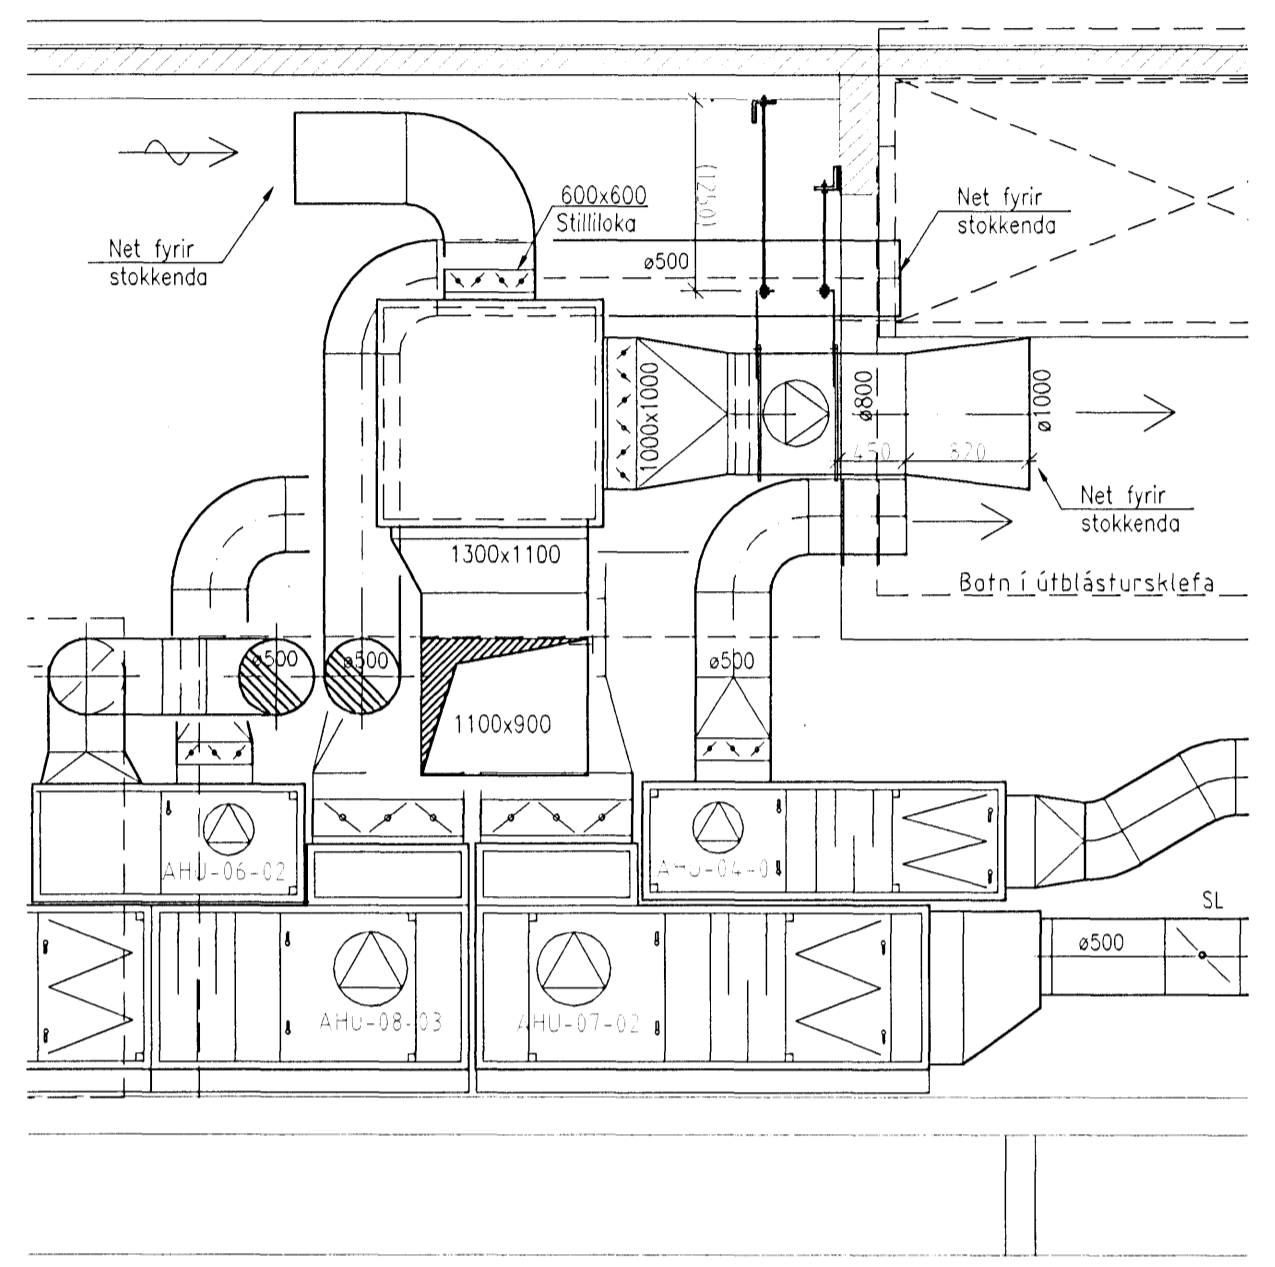


K Snið  
214/404 Mkv. 1: 50

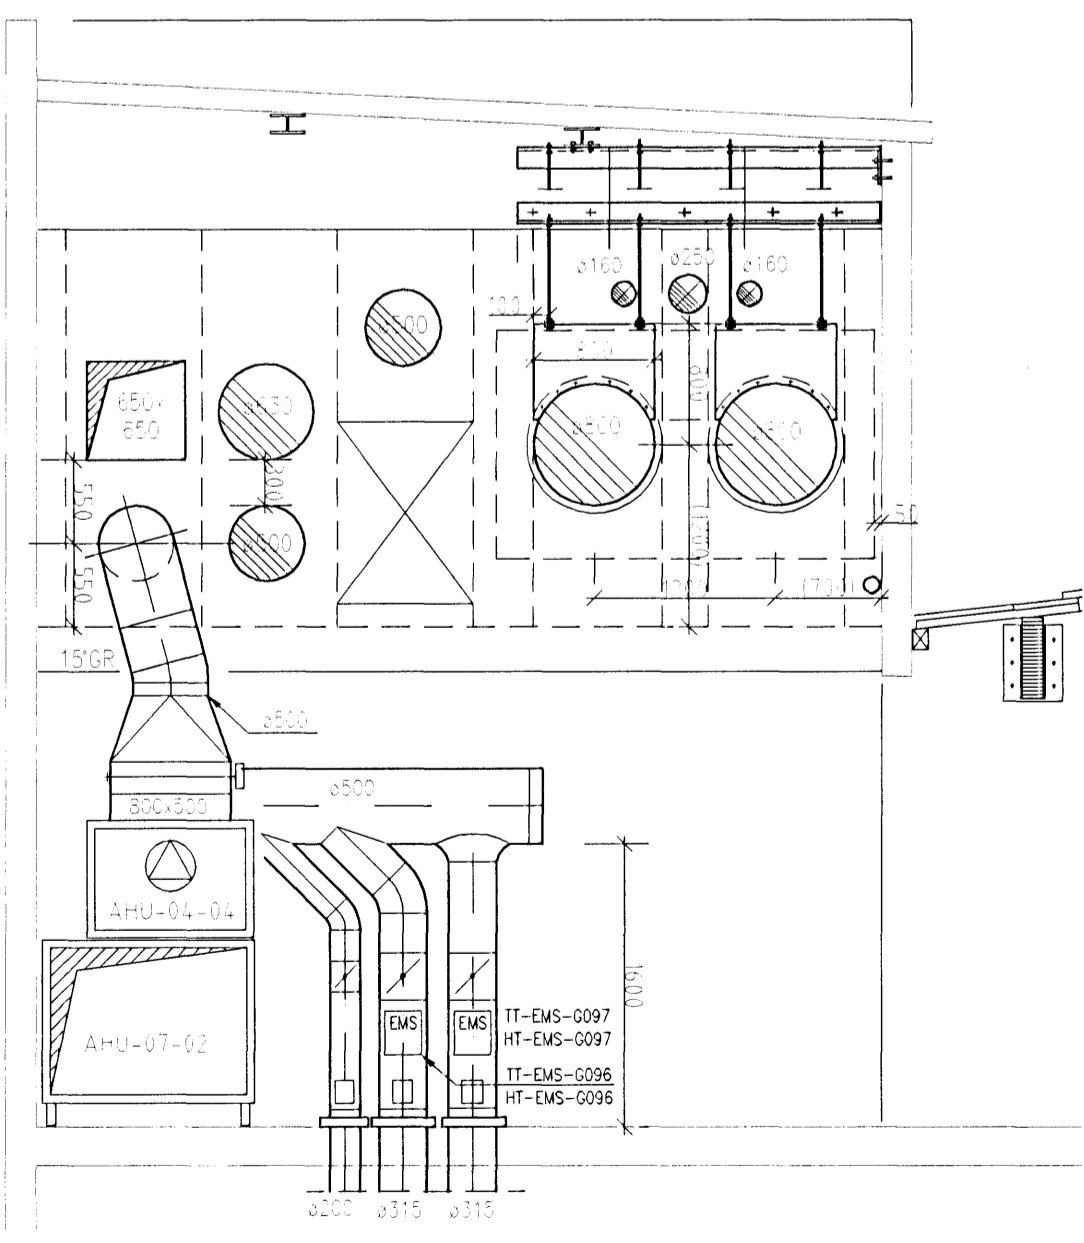


L Snið  
214/404 Mkv. 1: 50

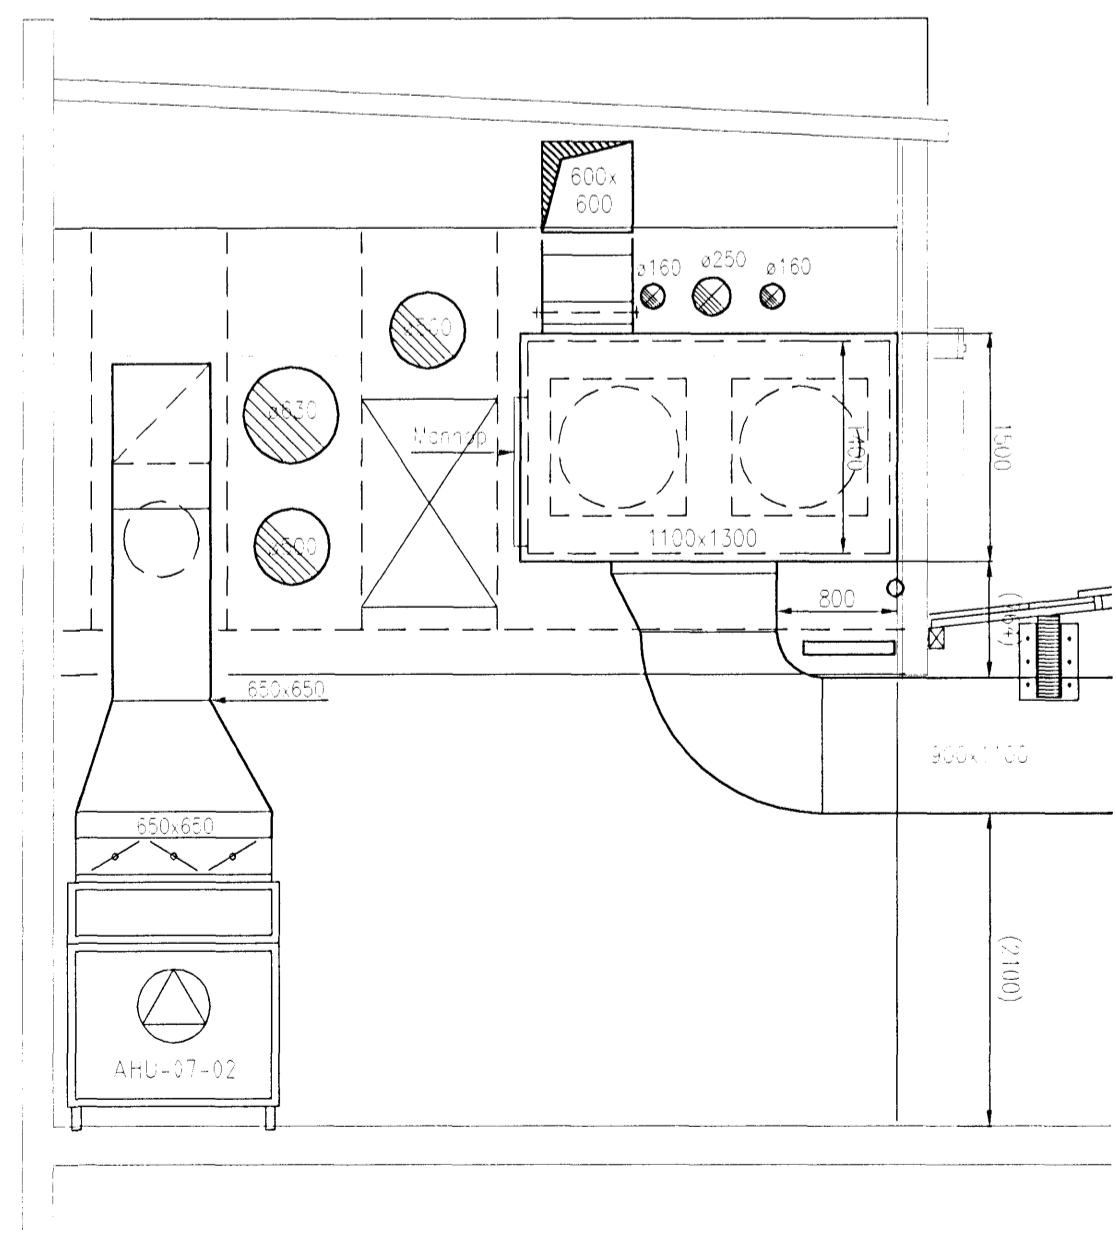


M Snið  
214/404 Mkv. 1: 50

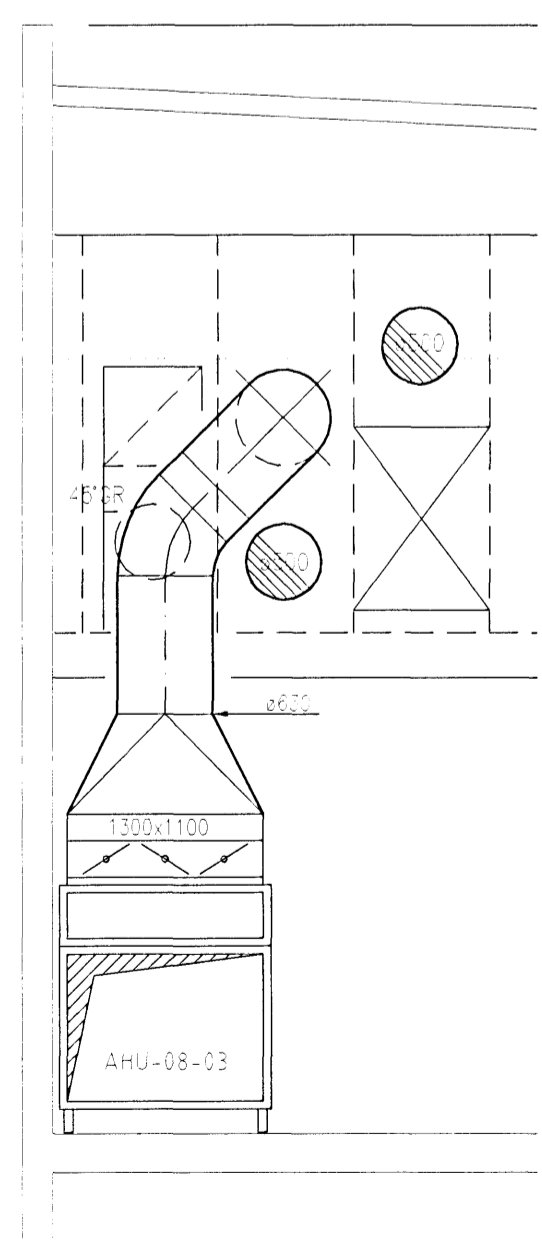

N Snið  
214/404 Mkv. 1: 50

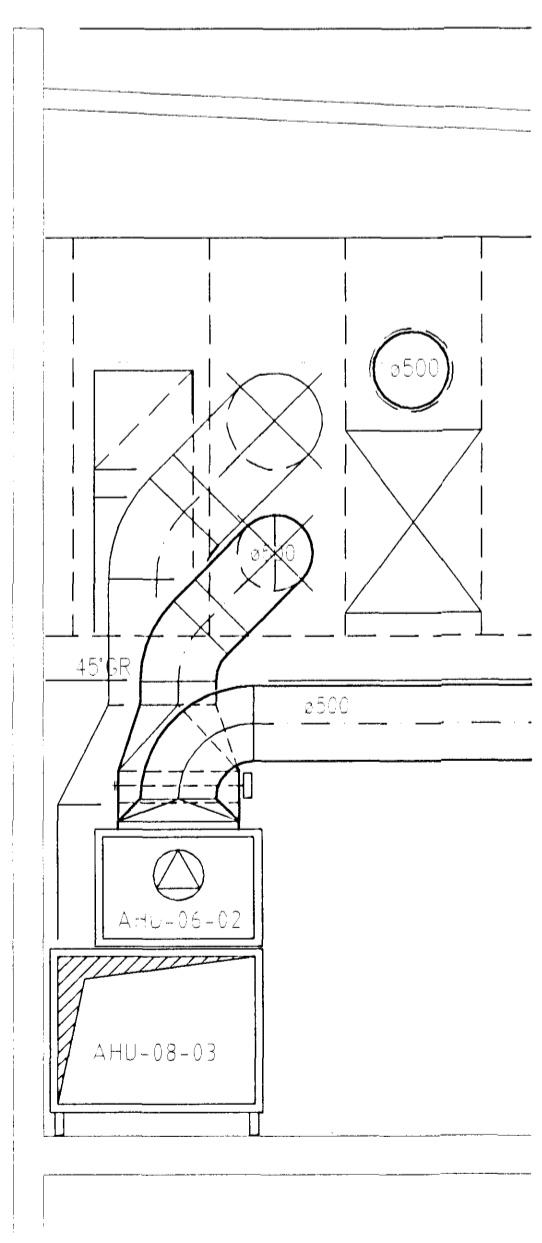

O Snið  
214/404 Mkv. 1: 50

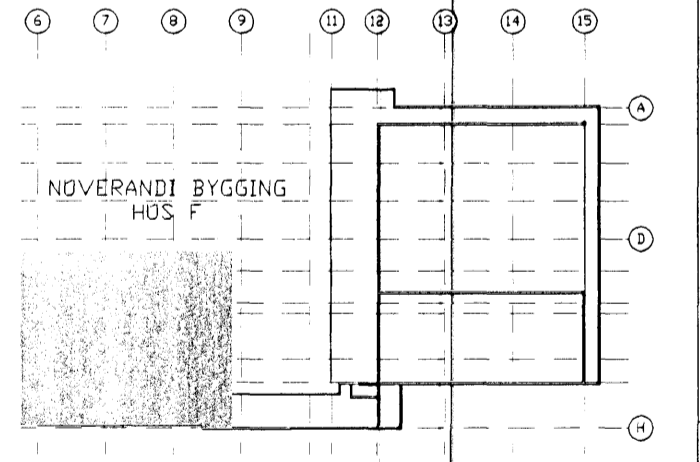

LYKILMYND *Jp 0205-7579*

A	Rauntekning	22.09.2005
Nr.	Lýsing & breytingu	Dags

**actavis**

Reykjavíkurvegur 78, Hafnarfirði  
F-Verksmiðja - Stækun  
Loftræstikerfi  
Snið

Tekning nr. IS1F-M08-02-404-A

Dags:	12.04.2005	Kverbi:	1:50	AT	Verk nr.:
Skjalnúmer:	379-2H-Loftræstikerfi.dwg				379

**LAGNATÆKNI**  
Hönnunar- og ráðgjafarstofa /FRV  
Hönnunargötu 13, 200 Kópavogur, Ísland  
Sími 354-564 5252 Fax 354-564 5251  
it@lagnotak.is www.lagnotak.is

Samb.: *[Signature]*  
Kennitala: *400147-2719*

1 2 3 4 5 6 7 8 9 10 11 12 13 14 15 16