



F Sníð
Mkv. 1:50

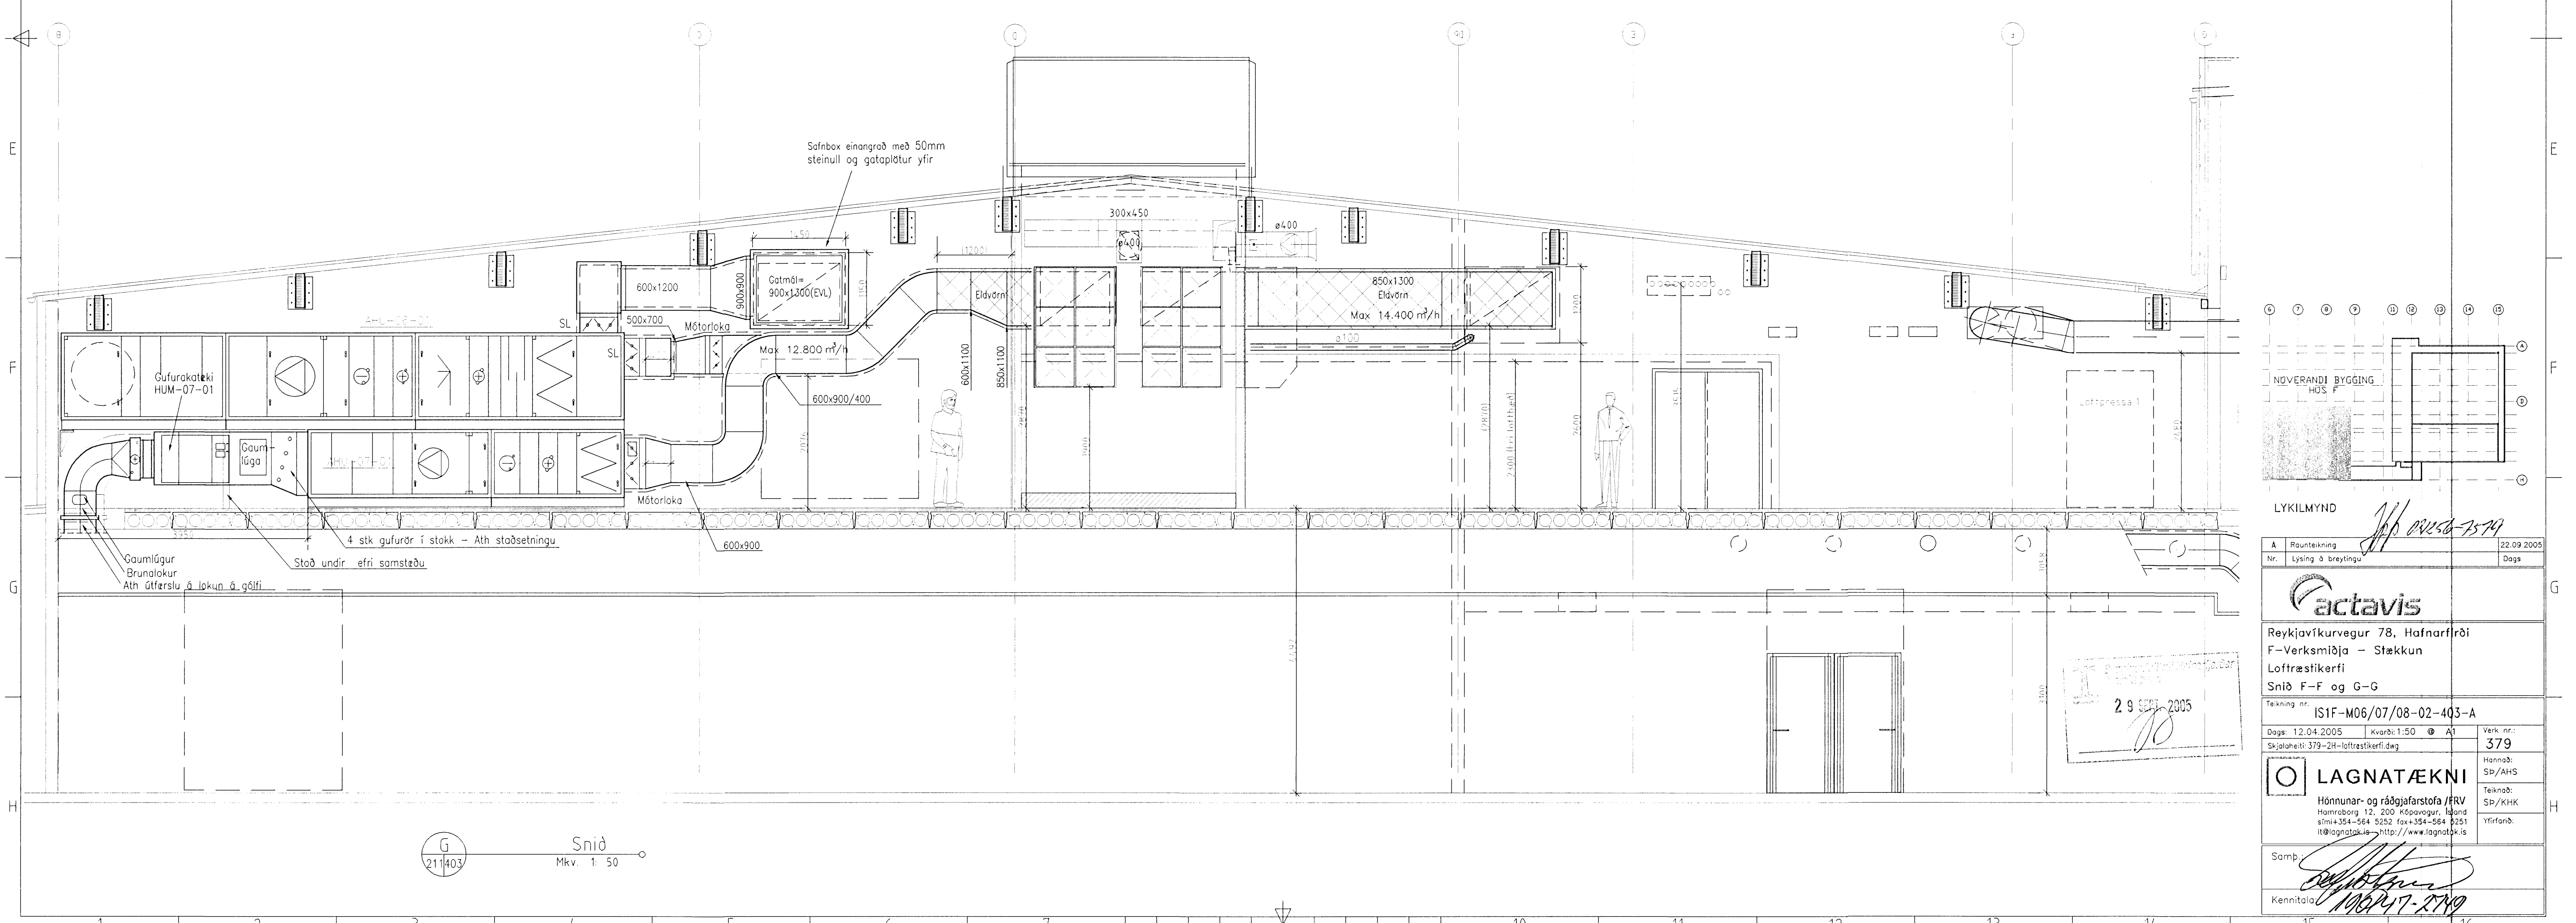

G Sníð
Mkv. 1:50

Undirritun samræmingarhönnuðar:

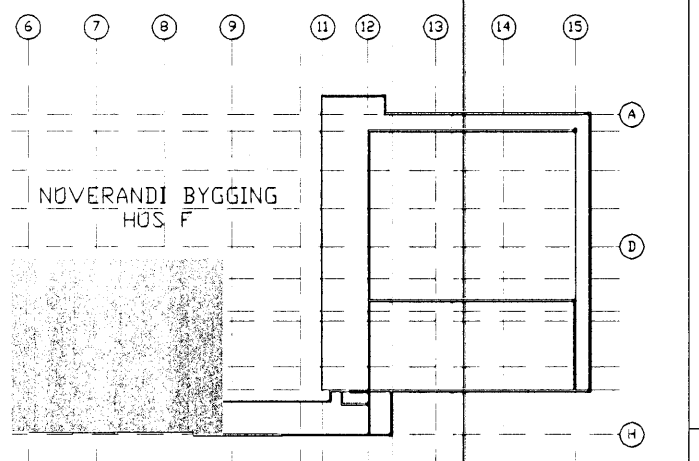

LYKILMYND

A	Reunteikning	22.09.2005
Nr.	Lýsing á breytingu	Dags

actavis
 Reykjavíkurvegur 78, Hafnarfirði
 F-Verksmiðja - Stækun
 Loftfræstikerfi
 Sníð F-F og G-G

Teikning nr.	IS1F-M06/07/08-02-403-A
Dagur	12.04.2005
Skjalaheiti	379-2H-Loftfræstikerfi.dwg
Verk nr.	379
Hönnuð	SB/AHS
Teiknað	SB/KHK
Yfirfand.	

LAGNATÆKNI
 Hönnunar- og ráðgjafarstofa /FRV
 Sími 254-564, 5252 Fax 254-564, 5251
 E-mail lagnatak.is - http://www.lagnatak.is

Samb. *[Signature]*
 Kennitala *[Signature]*